

10/14

THIS EASEMENT IS RE-RECORDED TO SHOW "AS INSTALLED" STEP III OF UTILITIES INSTALLATION AS SHOWN ON ATTACHED D.E. CO. DRAWING ON 2-4-2112.

(68 44261)

APARTMENTS

Name of Project: ROSIN APARTMENTS

EASEMENT GRANT and DECLARATION OF RESTRICTIONS

THE UNDERSIGNED, hereinafter called "GRANTOR(S)", in consideration of the sum of One Dollar (\$1.00) and other valuable considerations, receipt of which is hereby acknowledged, hereby grants and conveys to THE DETROIT EDISON COMPANY, a corporation organized and existing concurrently under the laws of Michigan and New York, with offices at 2000 Second Avenue, Detroit, Michigan, 48226, hereinafter referred to as "EDISON", and MICHIGAN BELL TELEPHONE COMPANY, a Michigan corporation, with offices at 1365 Cass Avenue, Detroit, Michigan, 48226, hereinafter referred to as "BELL", their licensees, lessees, successors and assigns, easements for the purpose of providing underground electric and communication services, including the necessary underground lines, cables and equipment, and including above ground cable pole(s), and other utility facilities, in, under, over, upon and across an area 6 feet wide, the planned centerline(s) of which are presently identified on The Detroit Edison Company Drawing No. OU 2-4-2112, but the location of which shall be shown on revised drawings "as installed", which drawings shall be attached hereto and made a part hereof subsequent to installation and prior to recording. Said easements are located in land in the Twp. of Southfield, County of Oakland, State of Michigan, described in Appendix "A" which is attached hereto and made a part hereof.

These covenants are granted subject to the following conditions and restrictions:

1. It is understood and agreed that the title to all primary and secondary electric cables, communication cables, secondary service pedestals, switching equipment, transformers, meters, meter enclosures and equipment of either EDISON or BELL situated in or on premises of the Grantor(s) shall at all times remain in EDISON or BELL and shall be deemed to be personal property and shall not be deemed a part of the realty.
2. EDISON and BELL, their employees, agents and contractors, shall have full right and authority to enter at all times upon said premises for the purpose of constructing, reconstructing, repairing, modifying, operating and maintaining said electric and communication facilities described above.
3. No excavations (except for public utility purposes), no structures, apparatus of any kind and no changes of finished grade shall be allowed within the utility easements hereinabove described. No excavations for fences shall be allowed within the utility easements in the property described herein. Except as provided herein, the Grantors shall have the right to make any other use of the land subject to such

RECORDED RIGHT OF WAY NO. 24924

Handwritten signature or initials

easements which is not inconsistent with the right of the utilities; provided, however, that Grantor(s) shall not plant trees or large shrubs within the said utility easements. EDISON and BELL shall have the right without incurring any liability to the property owner for so doing, to trim any trees, bushes, roots or plants of any kind which, in the sole opinion of the utilities, interferes with their facilities, or is necessary for the installation, re-installation, repair, operation, modification or removal of their facilities in the utility easements hereinabove described.

4. No shrubs or foliage shall be permitted on Grantor's property within five (5') feet of the front door of transformer enclosure(s) or switching cabinet(s), nor shall shrubs or foliage be permitted within five (5') feet of service connection pedestals.

5. The Grantor(s) and all subsequent owners shall own, install, maintain and replace their single phase electric service conductors.

6. The installation of said electric service conductors shall comply with and conform to the specifications of The Detroit Edison Company.

7. Grantor(s) shall not make any change in grade in or near the easements when the change, in the opinion of either of the utilities interferes with the facilities already installed or which may be installed in the future.

8. The foregoing easements, restrictions and covenants shall run with the land and shall not be subject to termination without the consent of the utilities herein concerned, and shall inure to the benefit of and be binding upon the heirs, administrators, executors, personal representatives, successors and assigns of the parties hereto.

9. Enforcement may be instituted by civil proceedings against any person or persons violating or attempting to violate any covenants contained herein, either to restrain violation or to recover damages.

10. Invalidation of any of these covenants or restrictions by judgment or court order shall in no wise affect any of the other provisions which shall remain in full force and effect.

IN WITNESS WHEREOF, the Grantor(s) have set their hands and seals on this 12th day of March, 1951.

APPENDIX "A"

Lots 4 & 5, "Brookside Acres No. 1" a subdivision of part of the W. 1/2 of the N.W. 1/4 of Sec. 14, T1N, R10E, Southfield Twp., Oakland County, Michigan, according to the plat thereof as recorded in Liber 32, Page 17, Oakland County Records.

John H. Humphrey
John H. Humphrey
Attorney at Law
1000 Woodward Ave.
Detroit, Michigan

1953 NOV 27 AM 11 01
RECORDED
REGISTERED
OAKLAND COUNTY RECORDS

RECORDED RIGHT OF WAY NO. 24974

IN THE PRESENCE OF:

Ruth M. McGarry
Ruth M. McGarry

Robert M. Rosin
Robert M. Rosin

Frances R. Cohen
Frances R. Cohen

Barbara J. Rosin
Barbara J. Rosin, his wife

Ruth M. McGarry
Ruth M. McGarry

Richard S. Rosin
Richard S. Rosin

Frances R. Cohen
Frances R. Cohen

Linda Rosin
Linda Rosin, his wife


ALL OF:
19963 James Couzens
Detroit, Michigan

~~UNITED JEWISH CHARITIES OF DETROIT,
a Michigan Non-Profit Corporation
163 Madison
Detroit, Michigan~~

By: _____
By: _____

~~1988 JUL 21 10 00
DAKLAND & CO
REGISTER OF
RECORDS
MICHIGAN~~

RECORDED RIGHT OF WAY NO. 24974

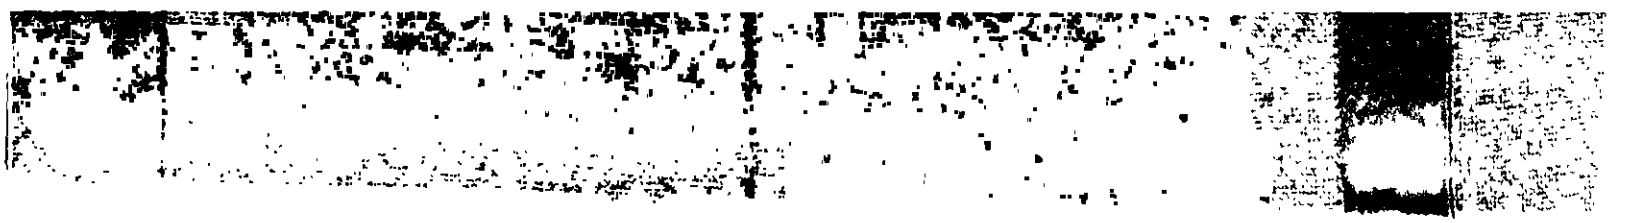

STATE OF MICHIGAN)
COUNTY OF Wayne) SS

On this 12 day of March, 1968, before me, the subscriber, a Notary Public in and for said County, personally appeared ROBERT M. ROSIN and BARBARA J. ROSIN, his wife, to me known to be the persons named in and who executed the within instrument as vendor and acknowledged that they executed the same as their free act and deed for the intents and purposes therein mentioned.

My Commission expires: March 18, 1969

Ruth M. McGarry
Notary Public Ruth M. McGarry

Wayne County, Michigan

STATE OF MICHIGAN)
COUNTY OF Wayne) SS

On this 12 day of March, 1968, before me, the subscriber, a Notary Public in and for said County, personally appeared RICHARD S. ROSIN and LINDA ROSIN, his wife, to me known to be the persons named in and who executed the within instrument as vendor and acknowledged that they executed the same as their free act and deed for the intents and purposes therein mentioned.

My Commission expires: March 18, 1969

Ruth M. McGarry
Notary Public Ruth M. McGarry

Wayne County, Michigan

STATE OF MICHIGAN)
COUNTY OF _____) SS

On this _____ day of _____, 1968, before me appeared _____ and _____ to me personally known, who being by me duly sworn, did say that they are respectively _____ and _____ of UNITED JEWISH CHARITIES OF DETROIT, a Michigan Non-Profit corporation created and existing under the laws of the State of Michigan and that the said instrument was signed and sealed in behalf of said corporation by authority of its Board of Directors and the said _____ and _____ acknowledged the said instrument to be the free act and deed of the said Corporation.

My Commission expires: _____

Notary Public

Co., Michigan

RECORDED FROM 22 FEB 1968 249724

MEMORANDUM ORDER
FOR GENERAL USE
DE FORM MS 77 12-53

TO Engineering Coordinator Supervisor DATE 3-15-68 TIME _____
1901 Second - Room 126
Re: Underground Service - Scoria Apartments - Southfield Township
Oakland County - Michigan

Agreements and Easements obtained by M.B.T.

Work to proceed with construction.

COPIES TO E. Olson - 1901 Second - Rm. 126
H. W. Friebe - 720 G. O.
REPORT Al Lee - Building Service Center
File

SIGNED *Stephen A. McNamee*
Stephen A. McNamee/lw
Staff Attorney
Law Department

DATE RETURNED _____ TIME _____ SIGNED _____

APARTMENTS

AGREEMENT

THIS AGREEMENT, made this 12th day of MARCH, 1968,
between Robert M. Rosin and Barbara J. Rosin, his wife and Richard S. Rosin and
Linda Rosin, his wife; all of 19963 James Couzens, Detroit, Michigan

hereinafter referred to as "DEVELOPER", and THE DETROIT EDISON COMPANY, a New York corporation, with offices at 2000 Second Avenue, Detroit, Michigan, 48226, hereinafter referred to as "EDISON", and MICHIGAN BELL TELEPHONE COMPANY, a Michigan corporation, with offices at 1365 Cass Avenue, Detroit, Michigan, 48226, hereinafter referred to as "BELL".

W I T N E S S E T H :

WHEREAS, DEVELOPER is developing apartments to be known as Rosin
Apartments, on land in the Township of Southfield,
County of Oakland, State of Michigan, as described in Appendix "A",
which is attached hereto and made a part hereof, and

WHEREAS, DEVELOPER desires EDISON and BELL to install their facilities for
underground single phase electric service and communication services including
necessary cable poles and above ground equipment.

NOW, THEREFORE, in consideration of the mutual promises and covenants herein
made between DEVELOPER and EDISON and BELL, it is hereby agreed as follows:

I DEVELOPER AGREES:

1. To record prior to utility installations a separate instrument granting
private easements for public utilities and restrictions acceptable to EDISON and BELL
for their utility facilities.

2. To grade easements to finished grade in accordance with local govern-
mental regulations prior to installation of underground lines so that the facilities
of the utilities can be properly installed in relation to finished grade. The grade
established for the land at the time the utilities place their facilities in the
easements shall be considered finished grade.

3. To place survey stakes indicating property lines and building plot
lines before and after trenching to enable the utilities to properly locate their
underground facilities and above ground equipment.

4. To install sanitary sewers prior to installation of electric underground
lines. Sewer, water and gas lines may cross but may not be installed within the
easements used for electric and communication lines.

Handwritten notes:
Dec. 14
1968, with 4, 1968
#1;
1968

RECORDED INSTRUMENT NO. 24974

5. To remove at DEVELOPER'S expense all trees, shrubbery or obstruction which may be necessary or required for installation of electric and communication facilities in the easements provided to EDISON and BELL, and to provide for trench at DEVELOPER'S expense in accordance with a separate letter agreement between DEVELOPER and EDISON.

6. To locate the trenches in the easements and to backfill in accordance with specifications of the utilities. DEVELOPER assures EDISON and BELL that the backfill shall be free of rubble and clods of hard or frozen dirt and shall not contain material which can damage emplaced lines.

7. To pay all extra costs incurred by utilities if paving is done before cable or conduit crossings are in place.

8. At DEVELOPER'S expense, as and wherever required by BELL, to place conduit within the land described in Appendix "A" for telephone facilities.

9. DEVELOPER further agrees that if subsequent to the installation of the utility's facilities by EDISON or BELL, it is necessary to repair, move, modify rearrange or relocate any of their facilities to conform to a new plot plan or change of grade made by DEVELOPER or for any cause or changes attributable to public authority having jurisdiction or to DEVELOPER'S action or request, DEVELOPER will forthwith pay the cost and expense of repairing, moving, modifying, rearranging or relocating said facilities to EDISON or BELL upon receipt of a statement therefore. Further, that if the electric or communication utility facilities of EDISON or BELL, or the electric service conductors owned and installed by DEVELOPER or their successors or assigns and which EDISON will maintain, are damaged by acts of negligence on the part of the DEVELOPER, or by contractors engaged by DEVELOPER of their successors or assigns, repairs shall be made by the utilities named herein at the cost and expense of DEVELOPER or their successors and assigns and shall be paid forthwith to EDISON or BELL by DEVELOPER or their successors and assigns upon receiving a statement therefore.

II

UTILITIES AGREE:

1. Upon completion of the above requirements, to furnish, install, own and maintain, at their own expense, (except costs and expenses set forth in Paragraphs 5, 7, 8 and 9), their electric and communication facilities in the private easements located in the above described lands. Provided, however, should the above described installations of the utilities be damaged by acts of negligence on the part of DEVELOPER or their contractors or assigns, repairs shall be made at the cost and expense of the

RECORDED SECRET OF WAY NO. 24474

DEVELOPER or their successors or assigns and shall be paid forthwith to EDISON or BELL by DEVELOPER or their successors or assigns upon receiving a statement therefore.

2. To meter and bill each tenant individually at the standard rates established by the Michigan Public Service Commission.

This Agreement shall inure to the benefit of and be binding upon the respective heirs, administrators, executors, personal representatives, successors, and assigns of the parties hereto.

IN WITNESS WHEREOF, the parties hereto have set their hands and seals the day and year first above written.

In the Presence of:

Stephen A. McNamee
Stephen A. McNamee

Irene C. Kata
IRENE C. KATA

Barbara DiAgostino
BARBARA DIAGOSTINO

Carol A. Moore
CAROL A. MOORE

THE DETROIT EDISON COMPANY

By: R. Q. Duke
R. Q. DUKE, DIRECTOR
Properties and Rights of Way Dept.

By: Lillian J. M. Carroll
LILLIAN J. M. CARROLL ASST. SECRETARY

MICHIGAN BELL TELEPHONE COMPANY

By: Carl T. Hall
Staff Supervisor, Right of Way
(Authorized signature)
CARL T. HALL

APPENDIX "A"

Lots 4 thru 8, "Brookside Acres No. 1", a subdivision of part of the W. 1/2 of the N.W. 1/4 of Sec. 14, T1N, R1E1, Southfield Twp., Oakland Co., Michigan, according to the plat thereof as recorded in Liber 32 of Plats, Page 17, Oakland County records.

DOCUMENT PREPARED BY
MICHAEL J. ...
AND ...
SOUTHFIELD, MICHIGAN

RECORDED UNDER OF MAP NO. 84974

In the Presence of:

Ruth M. McGarry
Ruth M. McGarry

Robert M. Rosin
Robert M. Rosin

Frances R. Cohen
Frances R. Cohen

Barbara J. Rosin
Barbara J. Rosin, his wife

Ruth M. McGarry
Ruth M. McGarry

Richard S. Rosin
Richard S. Rosin

Frances R. Cohen
Frances R. Cohen

Linda Rosin
Linda Rosin, his wife

STATE OF MICHIGAN)
COUNTY OF Wayne) SS

On this 12 day of March, 1968, before me, the subscriber, a Notary Public in and for said County, personally appeared ROBERT M. ROSIN and BARBARA J. ROSIN, his wife, to me known to be the persons named in and who executed the within instrument as vendor and acknowledged that they executed the same as their free act and deed for the intents and purposes therein mentioned.

My Commission expires: March 18, 1969

Ruth M. McGarry
Notary Public Ruth M. McGarry
Wayne County, Mich.

STATE OF MICHIGAN)
COUNTY OF Wayne) SS

On this 12 day of March, 1968, before me, the subscriber, a Notary Public in and for said County, personally appeared RICHARD S. ROSIN and LINDA ROSIN, his wife, to me known to be the persons named in and who executed the within instrument as vendor and acknowledged that they executed the same as their free act and deed for the intents and purposes therein mentioned.

My Commission expires: March 18, 1969

Ruth M. McGarry
Notary Public Ruth M. McGarry
Wayne County, Mich.

RECORDED RIGHT OF WAY NO. 249274

STATE OF MICHIGAN)
COUNTY OF WAYNE)

SS

On this 18th day of March, 1967, before me, the
subscriber, a Notary Public in and for said County, personally appeared

R. Q. Duke and Lillian J.H. Carroll

to me personally known, who being by me duly sworn, did say that they are

the Director, Properties & Rights of Way and an Assistant Secretary
Dept.

of THE DETROIT EDISON COMPANY, a New York Corporation, and that the seal
affixed to said instrument is the corporate seal of said corporation, and

that said instrument was signed in behalf of said corporation, by authority
of its Board of Directors and R. Q. Duke and

Lillian J.H. Carroll acknowledged said instrument to be the free
act and deed of said corporation.

My Commission expires: July 9, 1968

Rene C. Kata
Notary Public RENE C. KATA

Wayne County, Michigan

STATE OF MICHIGAN)
COUNTY OF OAKLAND)

SS

On this 13th day of March, 1968, before me, the
subscriber, a Notary Public in and for said County, appeared CARL T. HALL

to me personally known, who being by me duly sworn did say that he is Staff
Supervisor of Right of Way, authorized by and for MICHIGAN BELL TELEPHONE COMPANY,

a Michigan corporation, and that said instrument was signed in behalf of said
corporation, by authority of its Board of Directors, and CARL T. HALL

acknowledged said instrument to be the free act and deed of said corporation.

My Commission expires: _____

Francis J. Michaels
Notary Public

Francis J. Michaels, Notary Public
Oakland County, Michigan
Commission Expires Oct. 17 1969

_____ County, Michigan

RECORDED RIGHT OF WAY NO. 244977

24974

March 19, 1968

Mr. Robert Rosin
19963 James Couzens
Detroit, Michigan

Re: Rosin Apartments
S.S. Twelve Mile Rd., nr. Evergreen Rd.
City of Southfield - Oakland County

Gentlemen:

Subject to our agreement with you for the installation of underground electric lines in the above project, The Detroit Edison Company, will own, install and maintain its electric lines and equipment and provide trenching in easements six (6') feet in width, which will be subsequently platted or provided by separate easement instrument at a cost to you of \$1930.50 based on 1430 estimated trench feet at the rate of \$1.35 per trench foot. This cost is based on the location of lines and equipment as shown on the combined utility plan as approved on February 6, 1968. Any changes in these locations may require an adjustment in the cost figures. An additional charge will be made if boring under pavement, etc., is required or sand backfill is requested.

Normally, trenching operations will not be undertaken during December, January, February, or March unless soil conditions are suitable. However, if you request us to trench under adverse conditions and will make payment to us for any additional costs to us over and above the trenching cost stated above, we will proceed with the installation.

The future maintenance of our electric lines in the proposed easements does not include repair of damage to our lines and equipment caused by you, your contractors, agents, employes, successors and assigns. If such damage should occur, we would expect reimbursement for repairs.

For your convenience, we will bill you on terms of thirty (30) days.

Please sign three of the enclosed copies and return them. You may retain the fourth copy for your file.

Very truly yours,

Floyd W. Sell
Floyd W. Sell
Asst. Division Manager

ACCEPTED

R. Rosin

Robert M. Rosin

Date: 3/21/68

RECORDED RIGHT OF WAY NO. 24974





L. 5286
P. 693-695

TITLE BLOCK
STEP III
 D.O. --- 203047
 N.O. --- 3678597
 FOREMAN --- E. MAITRE
 LABOR --- D.E.CO.
 START --- 8-1-68
 FINISH --- 8-6-68
 NOTES --- E. MAITRE
 SUPERVISOR --- C. GOERS
 RECORDS --- B. RAK

TITLE BLOCK
STEP II
FOR ROAD CROSSINGS
 D.O. --- 203047
 N.O. --- 3678597
 FOREMAN --- CLARK
 LABOR --- D.E.CO.
 START --- 5-2-68
 FINISH --- 5-2-68
 NOTES --- CLARK
 SUPERVISOR --- GOERS
 RECORDS --- RAK

TITLE BLOCK
STEP I
 D.O. --- 203047
 N.O. --- 3678597
 FOREMAN --- CLARK
 LABOR --- D.E.CO.
 START --- 4-8-68
 FINISH --- 4-8-68
 NOTES --- CLARK
 SUPERVISOR --- GOERS
 RECORDS --- RAK

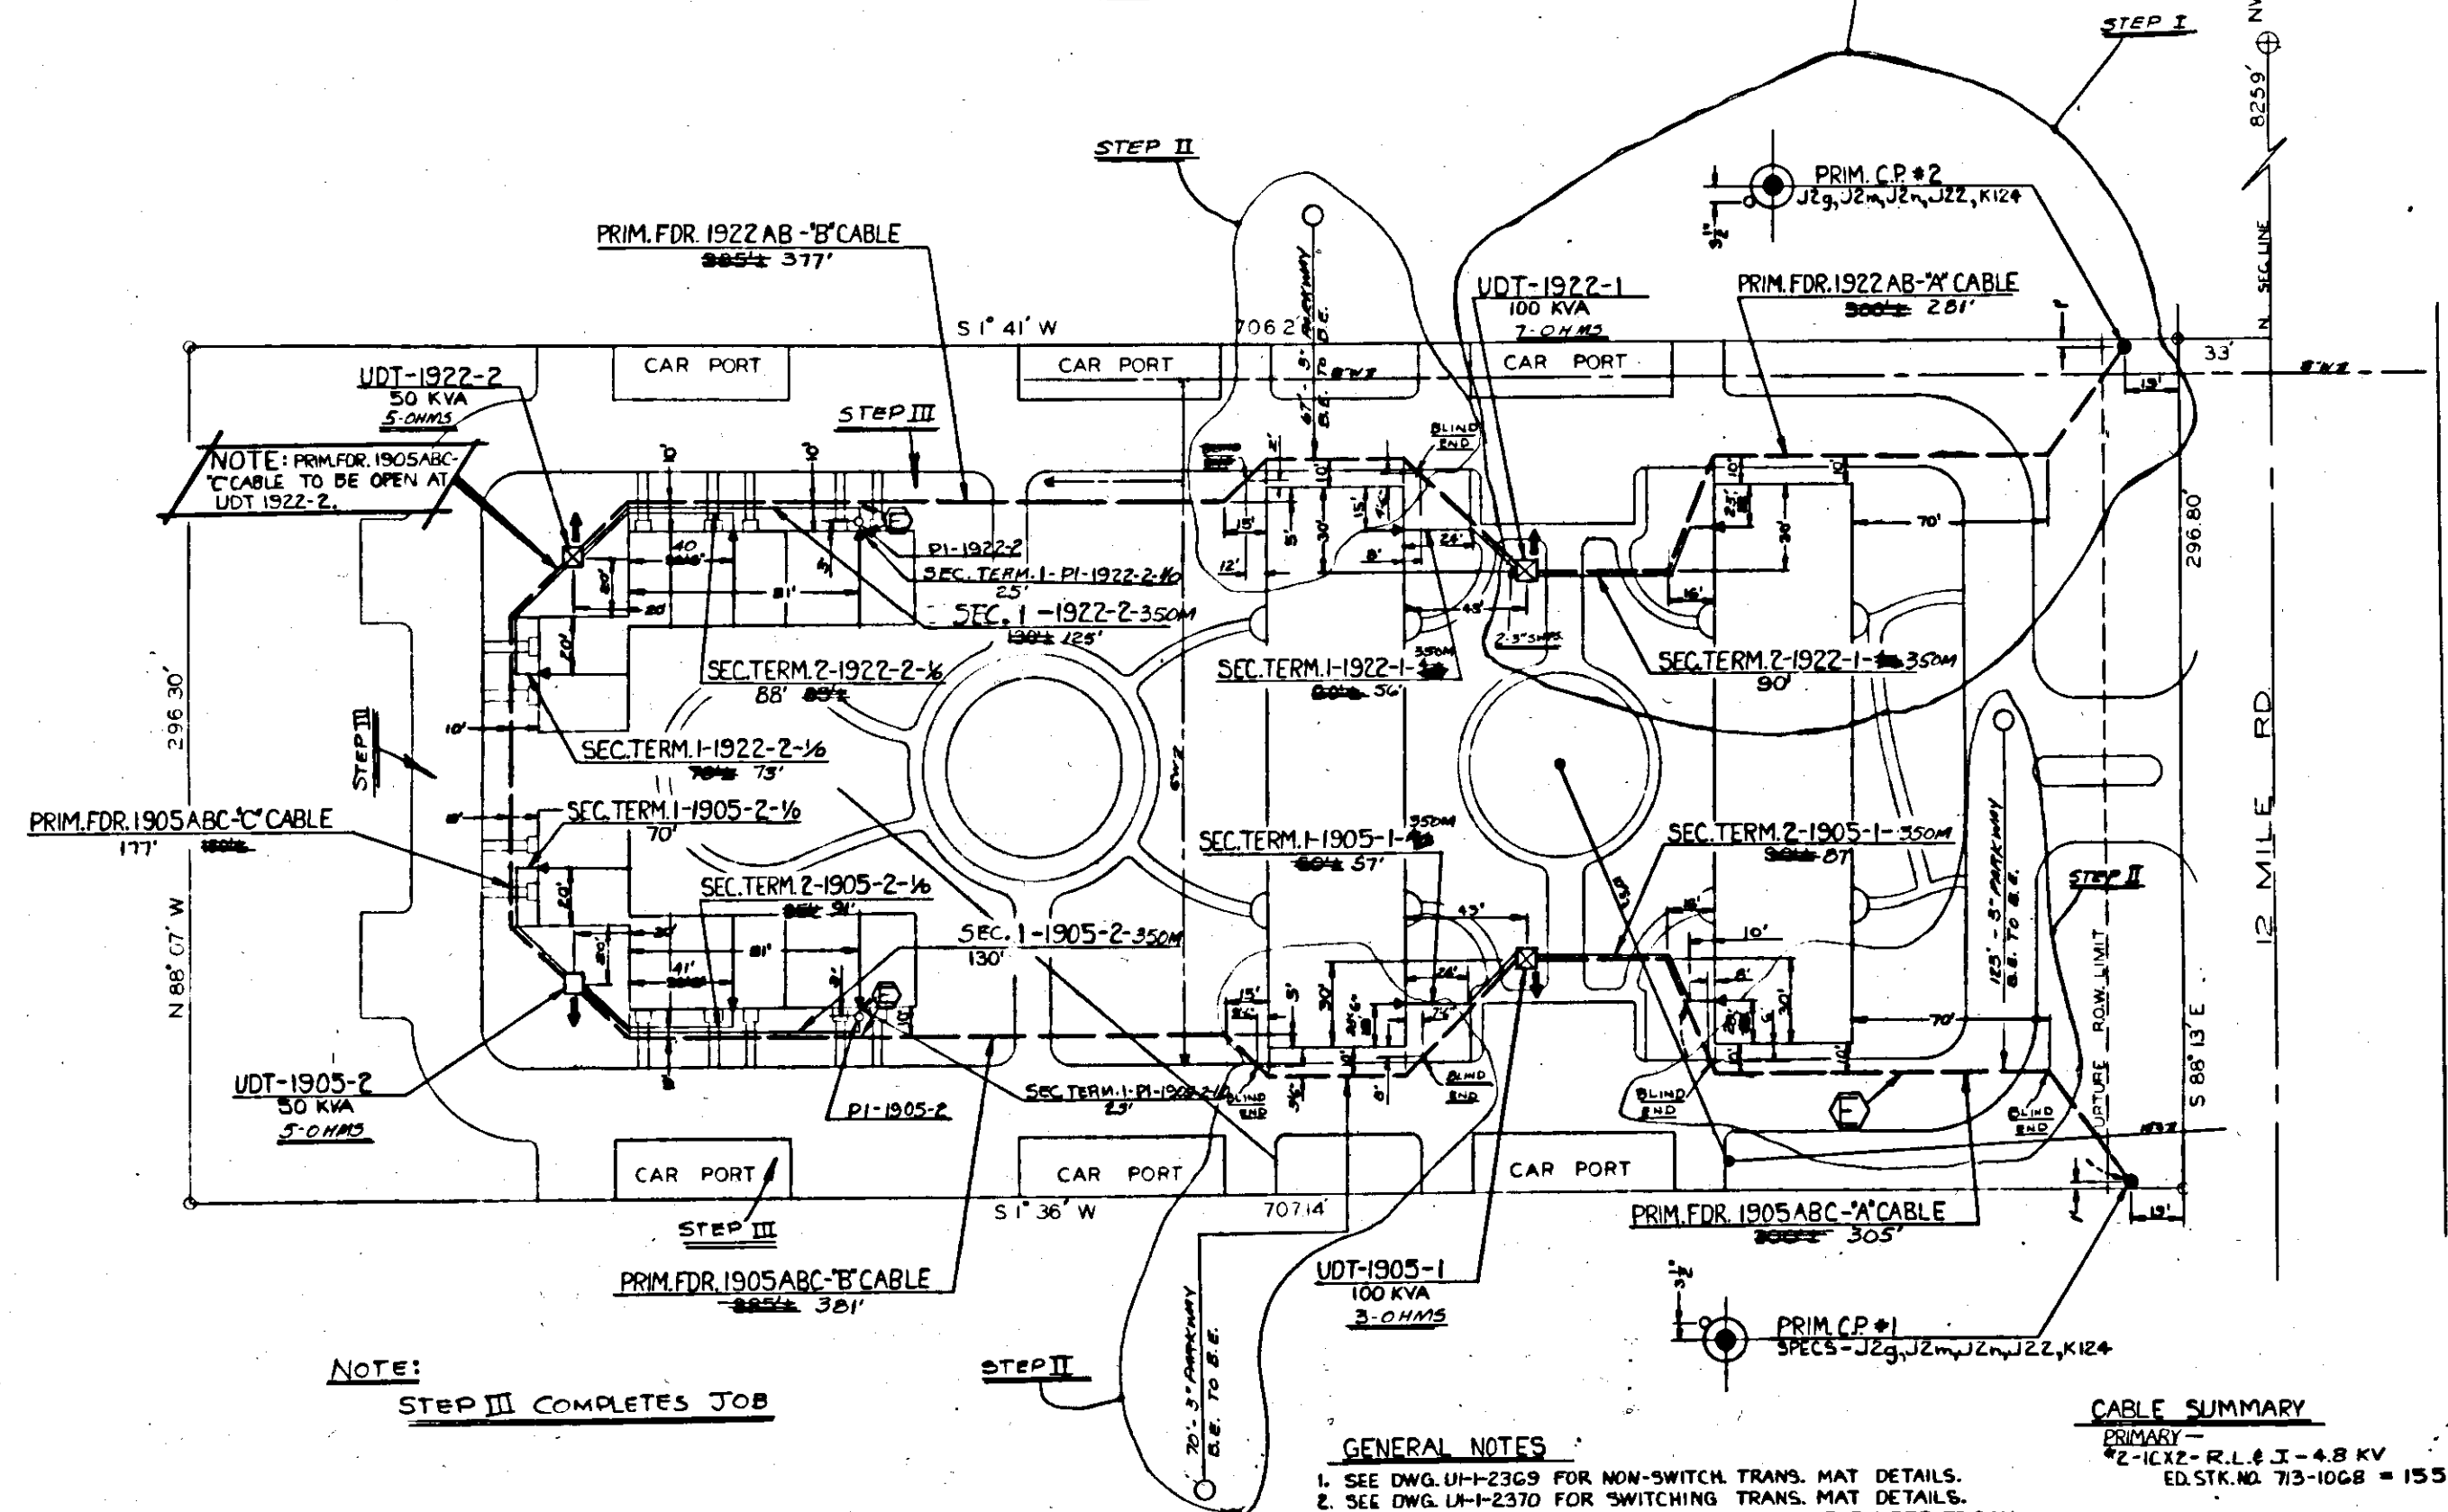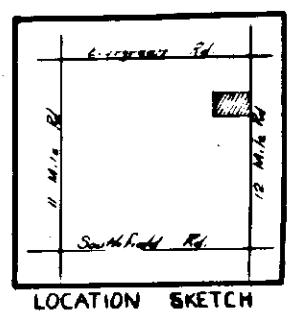

TRENCH SUMMARY
 D.E.CO. TRENCH ONLY = 215'
 JOINT TRENCH = 1215'

TRANSFORMER DATA

UDT NO.	SIZE	ED STR. NO.
*1905-1	100 KVA	713-0534
*1905-2	50 KVA	713-0537
*1922-1	100 KVA	713-0534
*1922-2	50 KVA	713-0537

* INDICATES SWITCHING TRANSFORMER
 SPECS: TRANSFORMER-R14, R25, K124
 TRANS. W SWITCH- R14b, R25, K124

- CODE**
- PAD MOUNT TRANSFORMER
 - PAD MOUNT TRANS. WITH SWITCHING
 - SECONDARY PEDESTAL
 - CABLE POLE
 - SECONDARY TERMINAL
 - 4.8 K.V. PRIMARY CABLE
 - SECONDARY CABLE
 - DETROIT EDISON TRENCH ONLY
 - SEWER
 - WATER
 - GAS
 - ← DIRECTION TRANS. DOOR OPENING

NOTE:
STEP III COMPLETES JOB

GENERAL NOTES

- SEE DWG. UH-2369 FOR NON-SWITCH TRANS. MAT DETAILS.
- SEE DWG. LH-2370 FOR SWITCHING TRANS. MAT DETAILS.
- ALL TRENCHING AND BACKFILLING TO BE DONE BY DET. EDISON.
- ALL TRENCH, CABLE, AND DUCT LENGTHS ARE APPROX.
- SEE DWG. CSD 675-2 DET. 'C' FOR ENTRANCE PT. DETAIL FOR APTS.
- M.B.T. ENG. - 808 ROWLEY - 26200 GREENFIELD RD. OAK PARK, MICH. PHONE - 542-9911
- GAS LINE INFO. NOT AVAILABLE AT THIS TIME - CALL CONSUMERS POWER - ENG. DIV. - TEL. 549-5000 PRIOR TO CONSTRUCTION.
- OWNER TO FURNISH SAND FOR BACKFILLING ALL TRENCH UNDER PAVEMENT.
- SEE DWG. CSD 675-1 DETAIL 'B' FOR ENTRANCE PTS. ON TOWNHOUSES.

CABLE SUMMARY

PRIMARY
 #2-1CX2-R.L.# J-4.8 KV
 ED. STR. NO. 713-1068 = 1550'

SECONDARY
 350M-1CX27 ALUM.
 #0-1CX1 ED. STR. NO. 713-0534 = 560±
 #0 KX27 POLY-COOV.
 #2 KX1 ED. STR. NO. 713-0533 = 310±

CONSTRUCTION SUPERVISORS

D.E.CO.
 CLAYTON GOERS
 RM. 136, 1501 2ND
 DETROIT, MICH.
 962-2100, EXT. 3071

M.B.T.CO.
 E. DINGER
 1330 CROOKS RD.
 CLAWSON, MICH.
 588-9970

DIST. CIRC. 1846 HICKORY
 4.8 K.V. INITIAL AND ULTIMATE

PERMITS REQ'D.
 CITY OF SOUTHFIELD (FOR NOTIFICATION ONLY)

REVISION REVISED TO SHOW AS INSTALLED IN FIELD STEP III. ALSO NAME CHANGED FROM R. ROSEN (ROAD CROSSINGS) AS SHOWN				REVISION REVISED TO SHOW AS INSTALLED STEP II AND ALSO STEP II (ROAD CROSSINGS) AS SHOWN				REVISION REVISED TO SHOW AS INSTALLED IN FIELD				REVISION REVISED TO SHOW AS INSTALLED IN FIELD			
MADE BY: [Signature] DATE: 8/22/68				MADE BY: [Signature] DATE: 8/22/68				MADE BY: [Signature] DATE: 8/22/68				MADE BY: [Signature] DATE: 8/22/68			

M.B.T. JOB NO 5066



STATION DIRECT BURIED SYSTEM VILLAGE GREEN APTS. LOTS 4 TO 8 INCL - L.32,P.17 NW 1/4, NW 1/4, SEC 14		SHEET NO. 68-288 OF 8 M.D. 018/124	
CITY OF SOUTHFIELD		OAKLAND CO.	

SFD 43-1



TITLE BLOCK
STEP II
 FOR ROAD CROSSINGS
 P.O. --- 205047
 N.O. --- 5678597
 FOREMAN --- CLARK
 LABORER --- DECO
 START --- 5-2-68
 FINISH --- 5-2-68
 NOTES --- CLARK
 SUPERVISOR --- GOERS
 RECORDS --- RAK

TITLE BLOCK
STEP I
 P.O. --- 202047
 N.O. --- 2678597
 FOREMAN --- CLARK
 LABORER --- DECO
 START --- 4-8-68
 FINISH --- 4-8-68
 NOTES --- CLARK
 SUPERVISOR --- GOERS
 RECORDS --- RAK

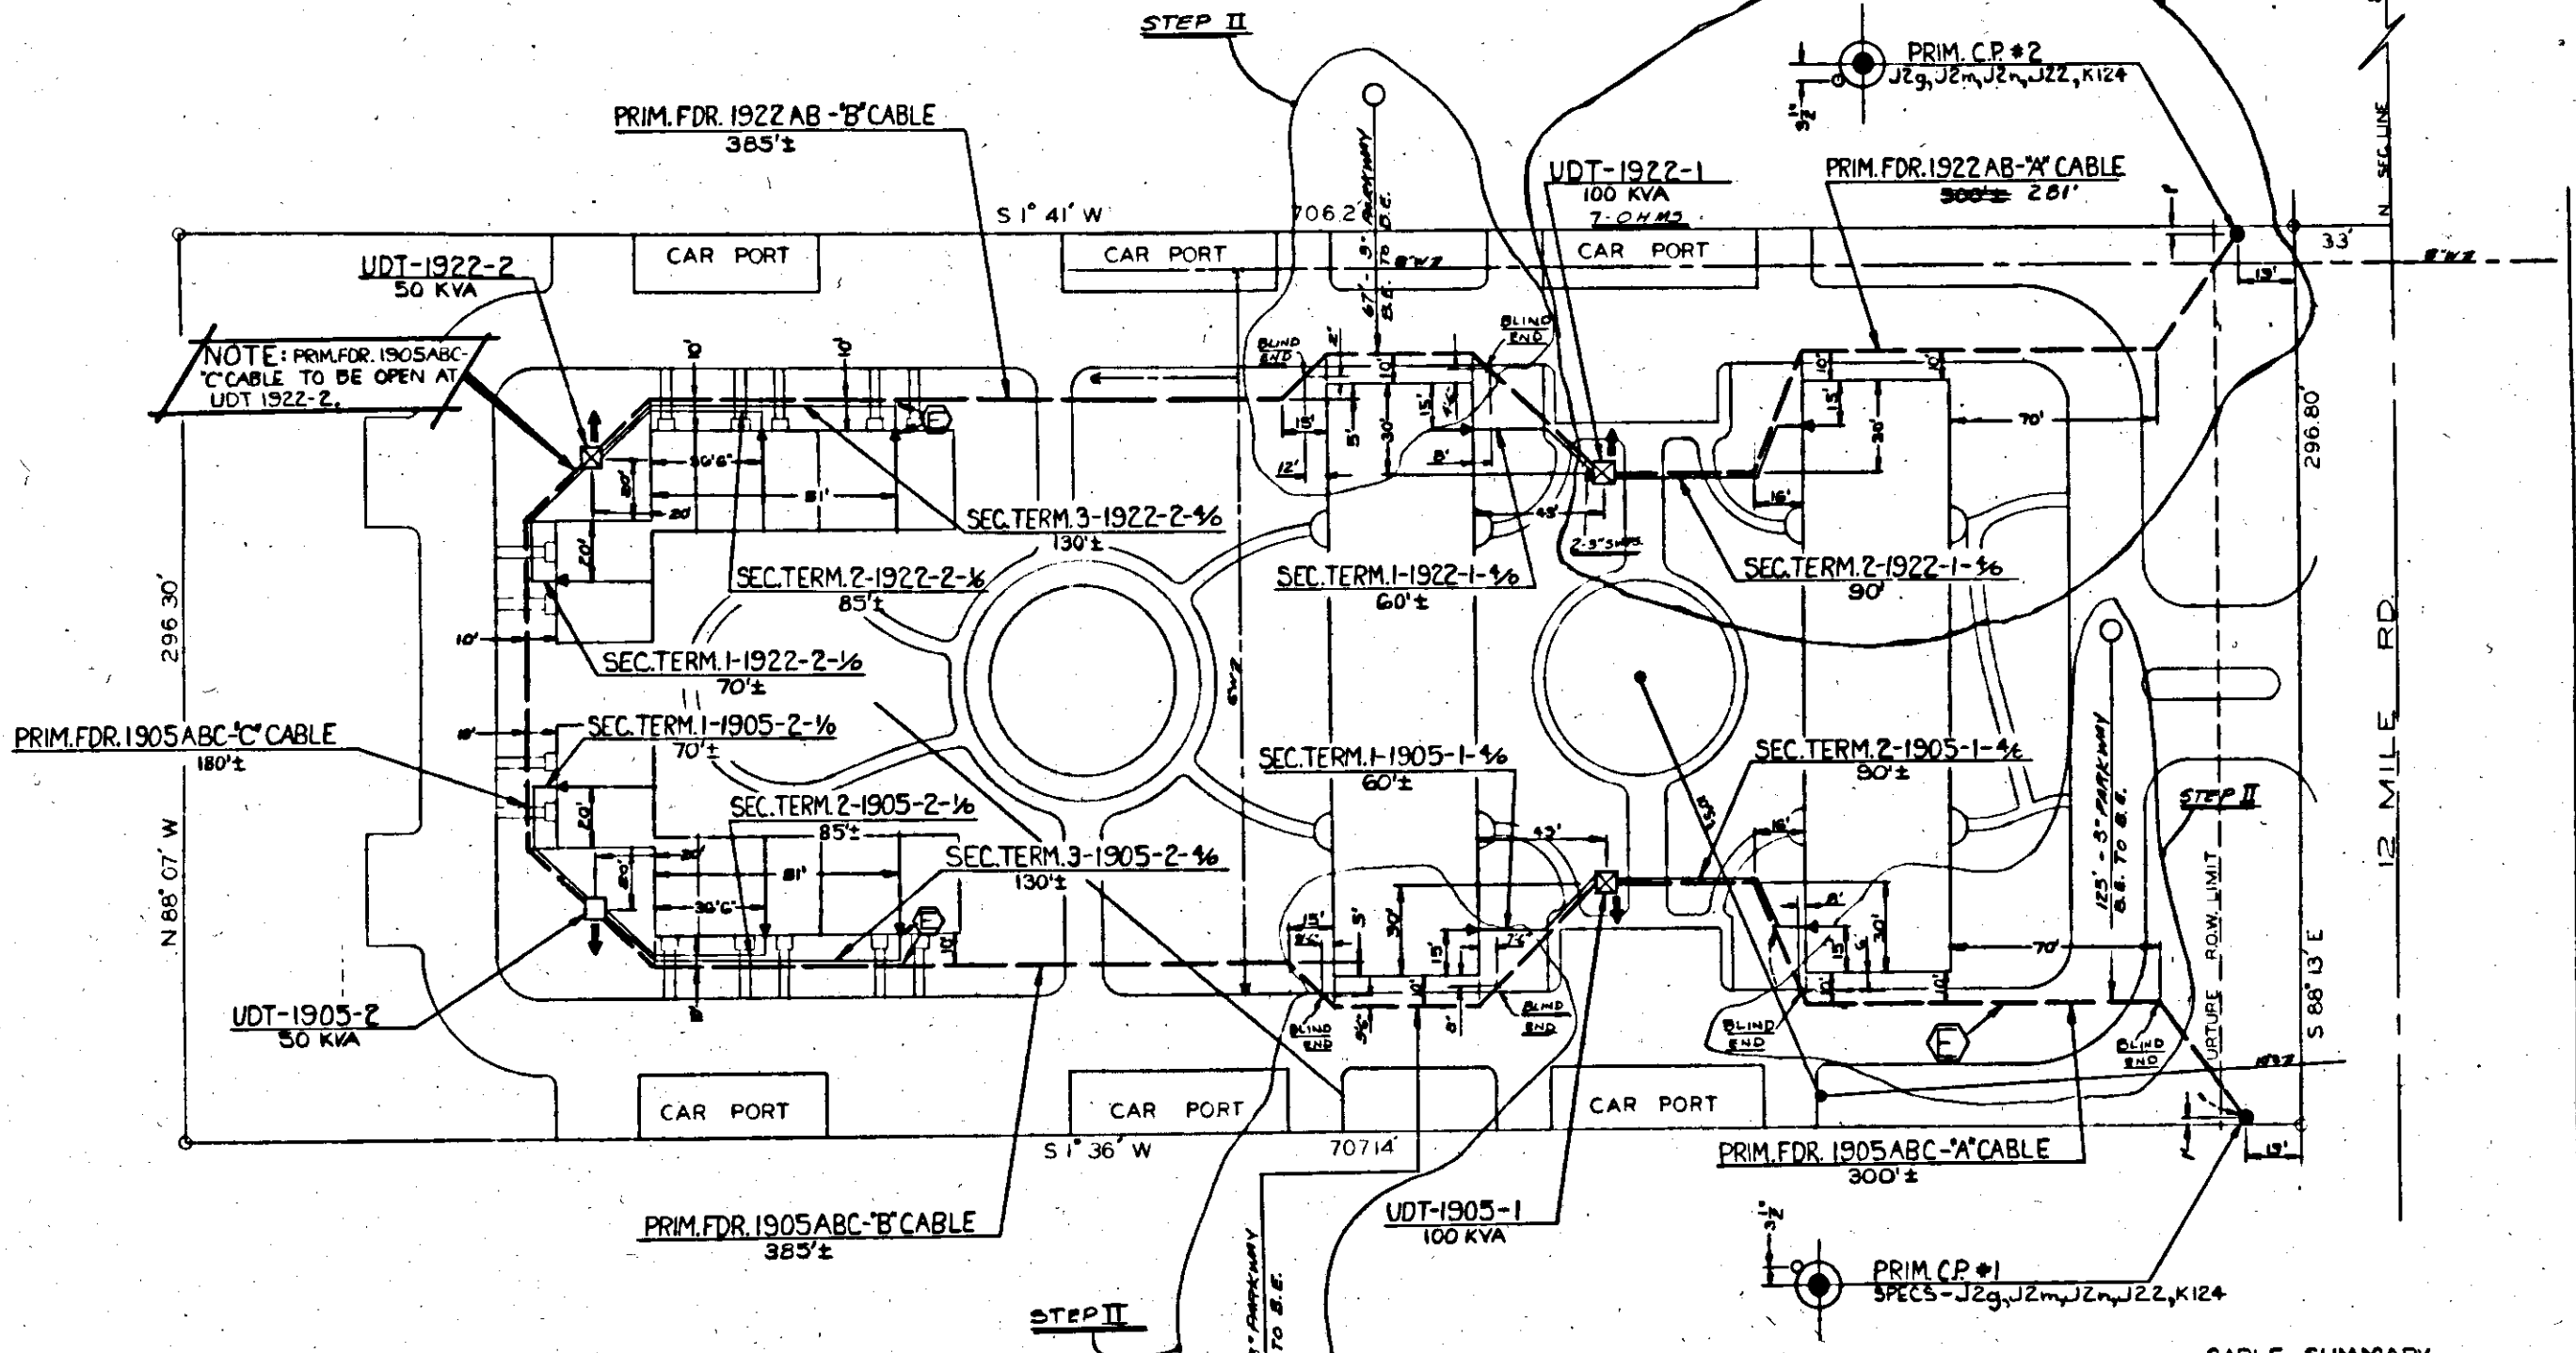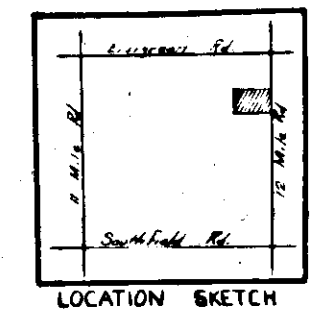

TRENCH SUMMARY
 D.E.CO. TRENCH ONLY = 215'
 JOINT TRENCH = 1215'
 TOTAL = 1430'

TRANSFORMER DATA

UDT NO.	SIZE	ED. STR. NO.
1905-1	100 KVA	713-0534
1905-2	100 KVA	713-0534
1922-1	100 KVA	713-0534
1922-2	100 KVA	713-0534

* INDICATES SWITCHING TRANSFORMER
 SPECS: TRANSFORMER - R14, R25, K124
 TRANS. W. SWITCH - R146, R25, K124

- CODE**
- PAD MOUNT TRANSFORMER
 - ⊗ PAD MOUNT TRANS. WITH SWITCHING
 - SECONDARY PEDESTAL
 - CABLE POLE
 - ▲ SECONDARY TERMINAL
 - 4.8 K.V. PRIMARY CABLE
 - SECONDARY CABLE
 - DETROIT EDISON TRENCH ONLY
 - SEWER
 - WATER
 - GAS
 - ← DIRECTION TRANS. DOOR OPENING

GENERAL NOTES

- SEE DWG. U-I-2369 FOR NON-SWITCH TRANS. MAT DETAILS.
- SEE DWG. U-I-2370 FOR SWITCHING TRANS. MAT DETAILS.
- ALL TRENCHING AND BACKFILLING TO BE DONE BY DET. EDISON.
- ALL TRENCH, CABLE, AND DUCT LENGTHS ARE APPROX.
- SEE DWG. CSD 675-2 DET. 'C' FOR ENTRANCE PT. DETAIL FOR APTS.
- M.B.T. ENG. - 808 ROWLEY - 26200 GREENFIELD RD. OAK PARK, MICH. PHONE - 542-9911
- GAS LINE INFO. NOT AVAILABLE AT THIS TIME - CALL CONSUMERS POWER - ENG. DIV. - TEL. 549-5000 PRIOR TO CONSTRUCTION.
- OWNER TO FURNISH SAND FOR BACKFILLING ALL TRENCH UNDER PAVEMENT.
- SEE DWG. CSD 675-1 DETAIL 'B' FOR ENTRANCE PTS. ON TOWNHOUSES.

CABLE SUMMARY

- PRIMARY -**
 #2-1CX2-R.L.#J-4.8 KV
 ED. STR. NO. 713-1068 = 1550'
- SECONDARY -**
 #6 1CX2 POLY COOV.
 #6 1CX1 ED. STR. NO. 713-0534 = 560±
 #0 1CX2 POLY-COOV.
 #2 1CX1 ED. STR. NO. 713-0533 = 310±

CONSTRUCTION SUPERVISORS

DECO - CLAYTON GOERS
 RM. 136, 1501 2ND
 DETROIT, MICH.
 962-2100, EXT. 3071

M.B.T. CO. - E. DINGER
 1330 CROOKS RD.
 CLAWSON, MICH.
 588-9970

PERMITS REQ'D.
 CITY OF SOUTHFIELD (FOR NOTIFICATION ONLY)

DIST. CIRC. 1846 HICKORY
 4.8 K.V. INITIAL AND ULTIMATE

M.B.T. JOB NO 5066

NO.	REVISION	DATE	BY	APPROVED
1	REVISED TO SHOW AS INSTALLED STEP I AND ALSO STEP II (ROAD CROSSINGS) AS SHOWN	2-12-68	GEORGE GEHRING	R. ROSIN
2		2-18-68	PAUL	
3		2/18/68	R. Rosin	
4		2/18/68	R. Rosin	
5		2-21-68	Edmund	

OTHER APPROVAL

PROJECT: DIRECT BURIED SYSTEM
 R. ROSIN APTS
 LOTS 4 TO 8 INCL - L.32,P.17
 NW 1/4, NW 1/4, SEC 14

SCALE: 1" = 30'

PROJECT NO: 8 M D O 18 / 124

DRAWING NUMBER: 002-4-2112

CITY OF SOUTHFIELD OAKLAND CO

SFD 43-1