is hereby agreed:

AGREEMENT - EASEMENT - RESTRICTIONS

This instrument made this John day of Johnson, 1977 by and between the undersigned Owners and THE DETROIT EDISON COMPANY, a corporation organized and existing concurrently under the laws of the states of Michigan and New York, of 2000 Second Avenue, Detroit, Michigan, 48226, hereinafter called "EDISON", and MICHIGAN BELL TELEPHONE COMPANY, a Michigan Corporation, of 1365 Cass Avenue, Detroit, Michigan, 48226, hereinafter called "BELL".

WITNESSETH:

WHEREAS, Owners are erecting apartments known as Knottinches Apartments
on land in the Torontin of Clinton
County of, State of Michigan, as described in Appendix "A", attached hereto and made a part hereof, and EDISON and BELL will install their
electric and communication facilities underground except necessary above ground
equipment.
NOW, THEREFORE, in consideration of the mutual promises and covenants
for the installation of underground utility service made by the parties hereto, it

- (1) The installation, ownership and maintenance of electric services and the charges to be made therefor shall be subject to and in accordance with the Orders and Rules and Regulations adopted from time to time by the Michigan Public Service Commission.
- (2) Owners must certify to EDISON and BELL that the easements are graded to within four (4") inches of final grade before the underground facilities are installed.
- (3) Owners further agree that if subsequent to the installation of the utility facilities of EDISON and BELL, it is necessary to repair, move, modify, rearrange or relocate any of their facilities to conform to a new plot plan or change of grade or for any cause or changes attributable to public author_ty having jurisdiction or to Owners action or request, Owners will pay the cost and expense of repairing, moving, rearrangement or relocating said facilities to EDISON and BELL upon receipt of a statement therefor. Further, if the lines or facilities of EDISON and BELL are damaged by acts of negligence on the part of the Owners or by contractors engaged by Owners, repairs shall be made by the utilities named herein at the cost and expense of the Owners and shall be paid to EDISON or BELL upon receiving a statement therefor. Owners are defined as those persons owning the land at the time damage occurred.
- (4) Owners hereby grant to EDISON and BELL easement for electric and communication underground services in land herein described. When utility lines are installed, this instrument shall be re-recorded with an "as installed" drawing showing the location of utility facilities in relation to building lines and indicating the easements by their centerlines. Easements herein granted shall be six (6') feet in width unless otherwise indicated on said drawing. However, secondary electric service and communication entrance line locations, as shown on an "as installed" drawing are not guaranteed; actual locations can be determined after contact with utilities.
- (5) Owners to pay the cost of conduit for electric and/or communication facilities to accommodate patios or similar site conditions.
- (6) Easements herein granted are subject to the following restrictions and additional conditions:
- a. Said easements shall be subject to Orders of and the Rules and Regulations adopted from time to time by the Michigan Public Service Commission.
- b. Owners will place survey stakes indicating <u>building plot</u> lines and property lines before trenching.

Minter Jun N.C. 133 Medasury Sub., 1.11-16 (Sustan James)

HECORDED RIGHT OF WAY NO. 3586

- c. No shrubs or foliage shall be permitted on Owners land within five (5') feet of front door of transformers or switching cabinet enclosures.
- d. Sanitary sewers shall be installed prior to installation of electric and communication lines. Sewer, water and gas lines may cross easements granted for electric and communication lines, but shall not be installed parallel within said easements.
- e. Owners shall make no excavations nor erect any structures within the easements identified on the "as installed" drawing. No <u>excavations</u> for fences shall be allowed within the limits of the utility easements provided for electric and communication lines unless prior written approval is secured from the utilities.
- f. Owners to provide for clearing the easements of trees, large stumps, and obstructions sufficiently to allow trenching equipment to operate. Owners to pay to utility concerned the extra trenching costs involved if trenching is required while ground is frozen.
- g. EDISON and BELL shall have the right of access at all times upon premises for the purposes of contructing, repairing and maintaining their electric and communication lines and facilities.
- h. Any of the undersigned who are vendors on land contracts wherein a portion of the lands described herein are being sold shall not be liable to BELL or EDISON unless and until the interest of the vendees, under any such contracts, have been forfeited and damage to utility lines and equipment occurs after such forfeiture.

The provisions of this instrument shall run with the land and shall be binding upon and inure to the benefit of the respective heirs, administrators, executors, personal representatives, successors and assigned of the parties hereto.

IN WITNESS WHEREOF, the parties hereto have set their hands and seals on the day and year first above written.

IN THE PRESENCE OF:

THE DETROIT EDISON COMPANY

Hazel L. Brandau

IRENE C. KATA

Fal Fatate and Rights of Way Dept.

mace Survivo

MICHIGAN BELL TELEPHONE COMPANY

Sinda M. Soffman

Marcha Paulka

William F. Murray, Jr.
Acting Staff Supervisor, Right of Way

f Supervisor, Right of Way (Authorized Signature)

KNOTTINGHAM APARTMENTS A Michigan Limited Partnership 18660 V. Ten Mile Road Southfield, Michigan

Robert Alderton

nna Martin

Donna Martin

RECORDED RIGHT OF WAY NO.

TO Engineering Goordinate To Engineering Goordinate To Engineering Goordinate	G. DATE 2-14-72
RE: Underground Service	- Enettingham Apts., Clinton Tup., Messub Count
Agreements and Essem	ests obtained - OK to preceed with senstruction
DPIESTO: Z. Miles - Mt. Clemens Office	SIGNED ROCKET CONTROLLES
PORT #16	Bobart W. Boolie: jpm Staff Attorney

.

State of Michigan

County of

day of EBRUARY. _, 1972, before me, a Notary Public, personally appeared Harold Blumenstein to me personally known, who being by me sworn, did say that he is a member of the partnership known as Knottingham Apartments, a Michigan Limited Partnership which executed the within instrument and that he acknowledged said instrument to be the free act and deed of the said partnership.

My Commission expires:

County, Michigan

APPENDIX "A"

Knottingham Apartments

The East 1 of Lots 11, 12, 13, 14, 15 and 16 of "The Meadows Subdivision" as recorded in Liber 20 of Plats on Page 6, Macomb County Records, and part of Private Claim 138, all in T2N, R13E, Clinton Township, Macomb County, Michigan, more particularly described as follows: Commencing at the Northeast corner of Lot 1 of said "The Meadows Subdivision" and thence extending N 3° 51' 30" E, 116.83 feet; thence S 48° 53' 30" E, 161.88 feet along the Northerly side line of Wellington Crescent Blvd., thence S 3° 51' 30" W, 340.78 feet; thence S 86° 08' 30" E, 105.44 feet; thence S 3° 51' 30" W, 1262.69 feet along the Easterly line of P.C. 138, thence N 86° 29' 30" W, 414.30 feet along the centerline of Iroquois Drive (60 ft. wide); thence N 3° 51' 30" E, 630.0 feet; thence S 86° 29' 30" E, 180.0 feet along the Northerly line of said Lot 11, thence N 3° 51' 30" E, 956.05 feet along the Easterly line of "The Meadows Subdivision" to the point of beginning and containing a total of 10.552 acres of land.

Reserving the Southerly 30 feet for Iroquois Drive and the recorded easement for Wellington Crescent Blvd. on the North and the recorded 30 foot easement for the Ingleside Radde Drain along the Easterly most side of the above described parcel and also subject to any other easements of record. Reserving the Southerly 30 feet for Iroquois Drive and the recorded easement for


STATE OF ATCHTGAN /		
COUNTY OF WAYNE)		
On this 17th day of February	, 19 <u>72</u> , before me, the	
subscriber, a Notary Public in and for said Cou		
فبعطفياطلة والمناف المناز مستجدال بثيث فاستعدا ويوسد ويزور موسيف فالمساببة	llian J.H. Carroll	
to me personally known, who being by me duly sw	•	
the Director, RE & R/W Dept. and an Au of THE DETROIT EDISON COMPANY, a corporation or		 cently
under the laws of Michigan and New York, and the	•	
instrument is the corporate seal of the said co.	rporation, and that said ins	trument
was signed in behalf of said corporation by aut	-	tors:
	an J.H. Carroli	<u> </u>
acknowledged said instrument to be the free act	and deed of said Corporation	m.
My Commission expires: june 24, 1972	had O Ket	
	Notary Public IREAR C. KATA	_
	Wayne Count	y, Michigan
•	· · · · · · · · · · · · · · · · · · ·	
	•	
•		
•		
STATE OF MICHIGAN)		
COUNTY OF OAKLAND)		
On this 10th day of February	, 1972, before me, th	е
subscriber, a Notary Public in and for said Cou	nty, appeared William F. Mu	rray,
Jr. to me personally known, who being by me dul;	y sworn, did say that he is	
Acting Staff Supervisor of Right of Way, author:		
TELEPHONE COMPANY, a Michigan Corporation, and		
signed in behalf of said Corporation, by author:	ity of its Board of Directo:	rs,
and William F. Murray, Jr. acknowledged said ins		
and deed of said Corporation.		RECORDED RIGHT
Mrt Cormingian Duni-	muland Harten	, CEC
My Commission Expires:	Mulford Hartman	RIGH
	- <i> </i> /	Ŧ


MELFORD HARTMAN
Notary Public, Wayne County, Michigan
Acting In Cakland County
My Commission Expires Sept. 15, 1975


RECORDED RIGHT OF WAY NO. 27

County, Michigan

) r

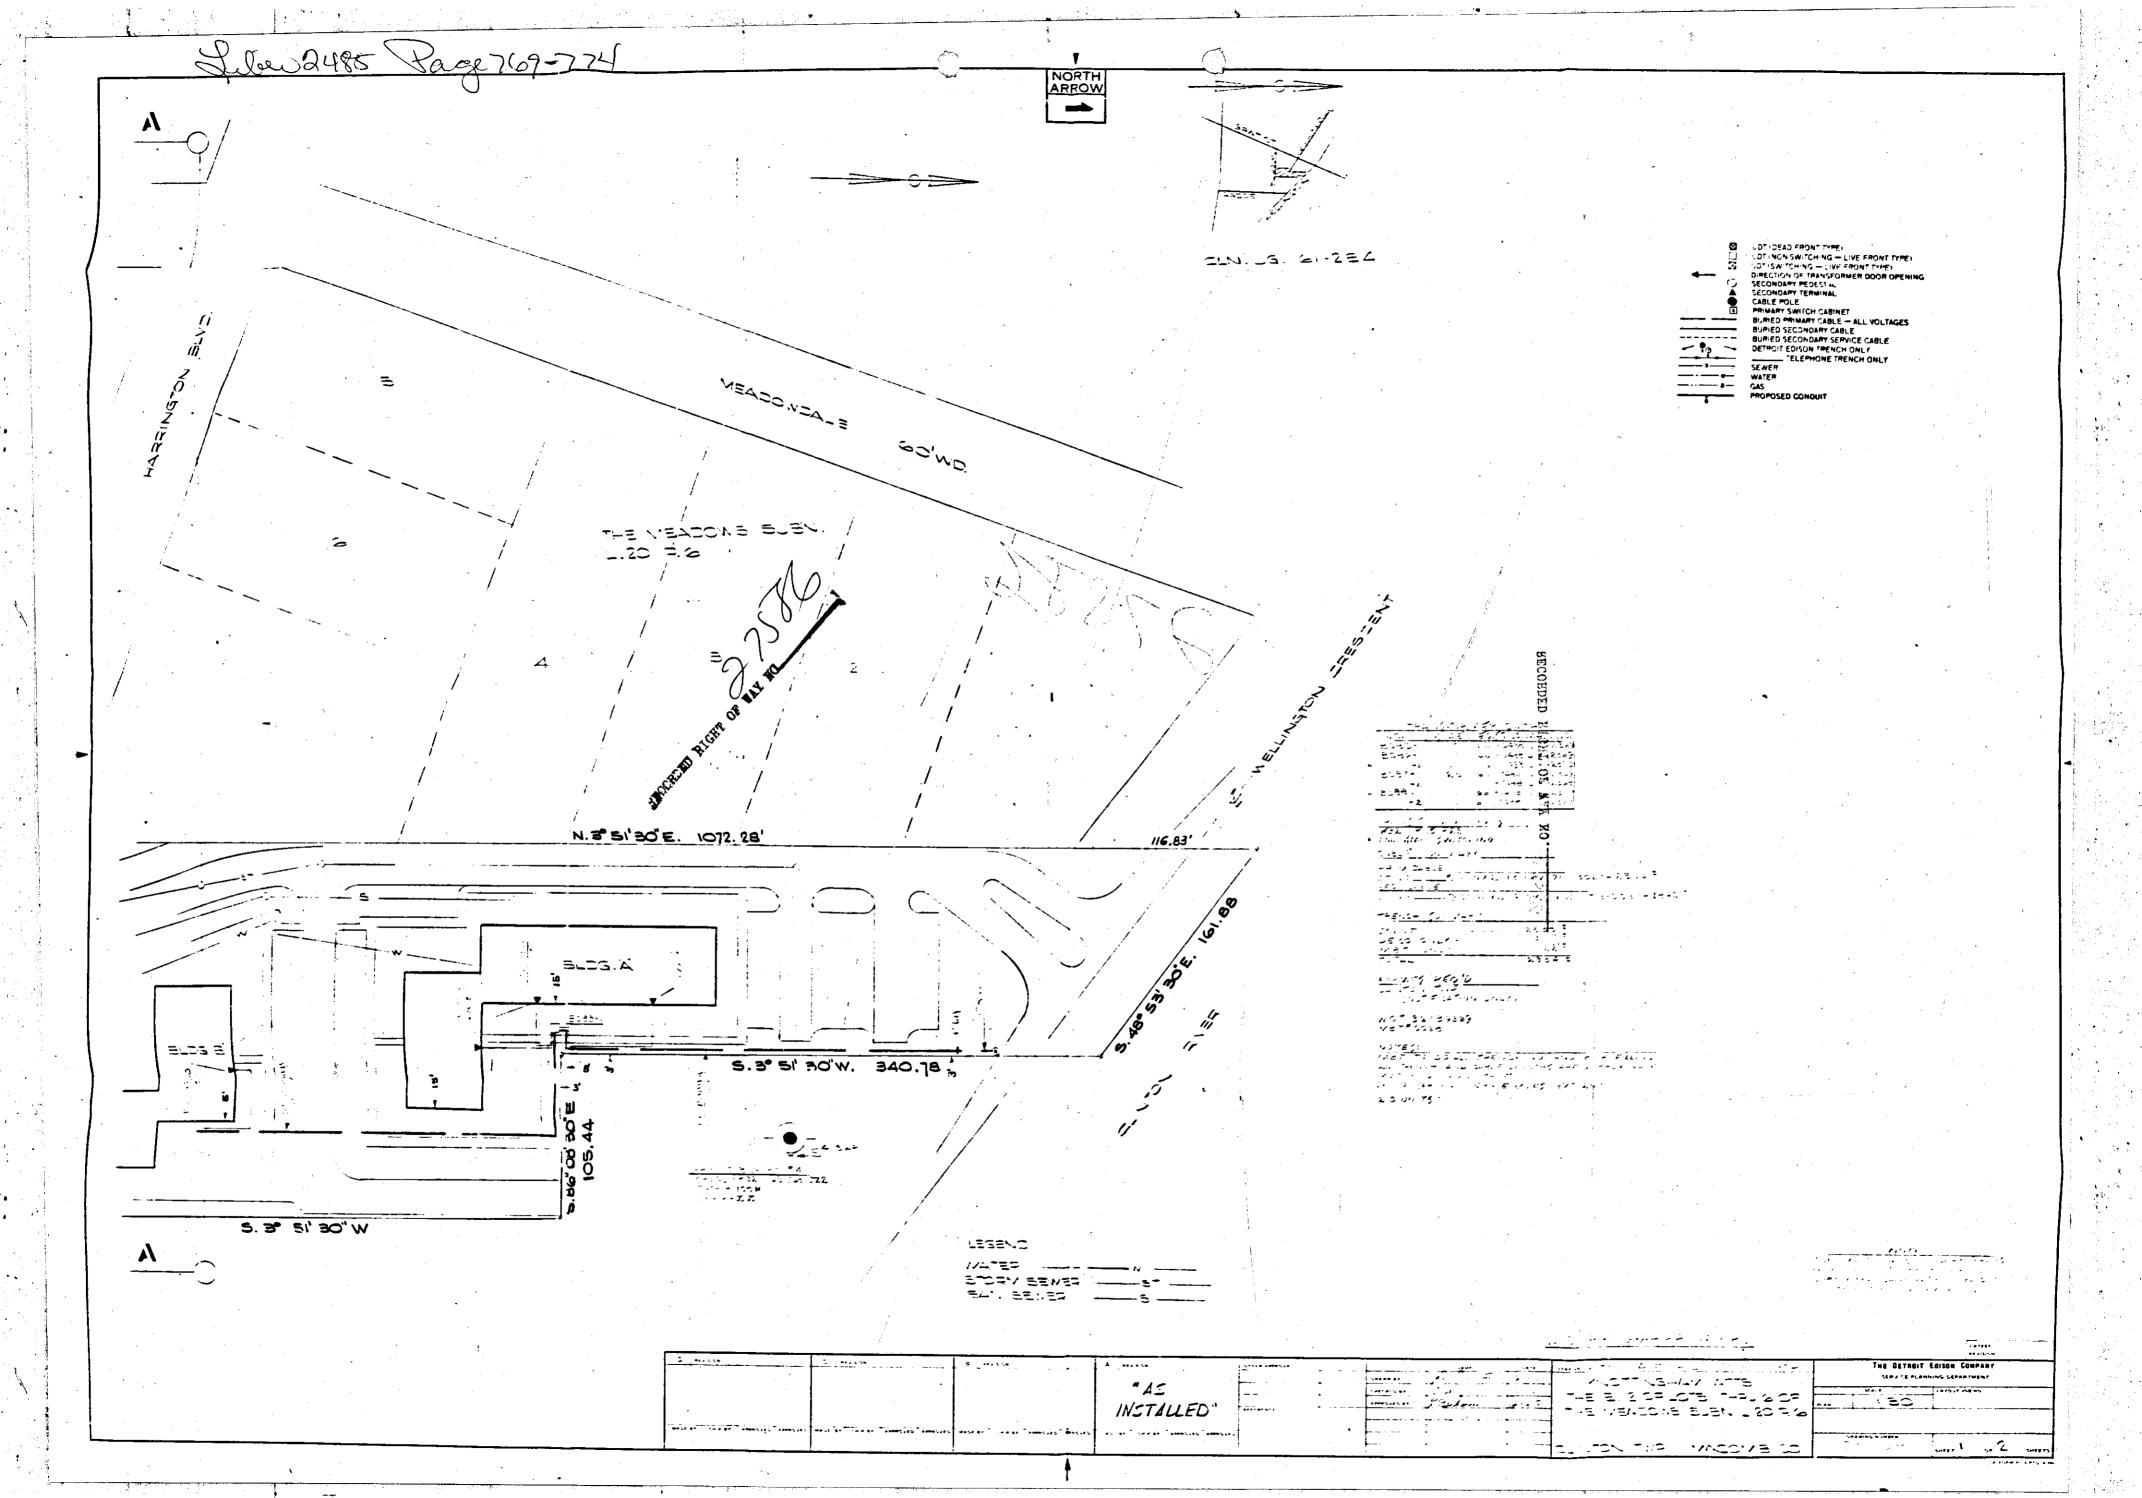

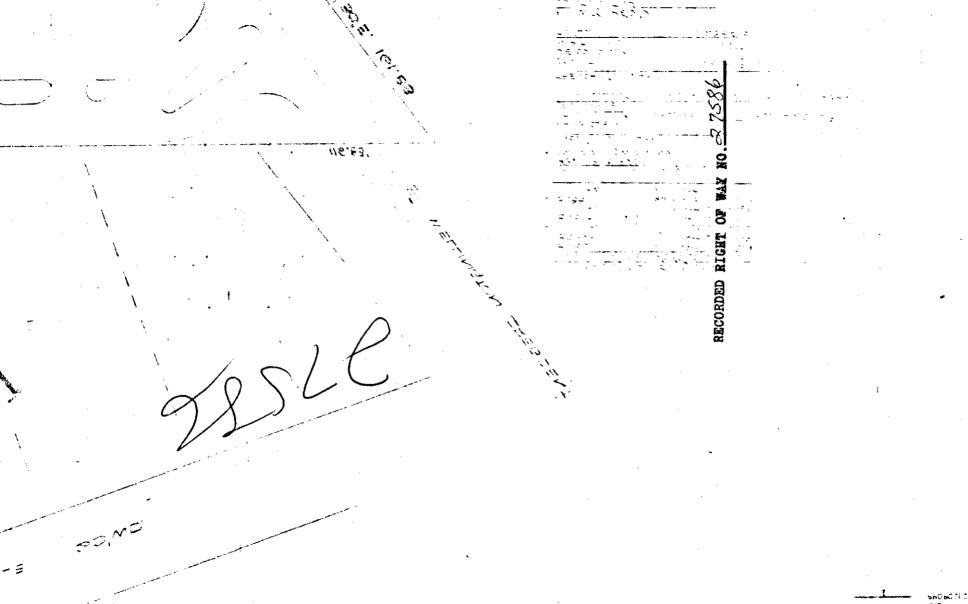

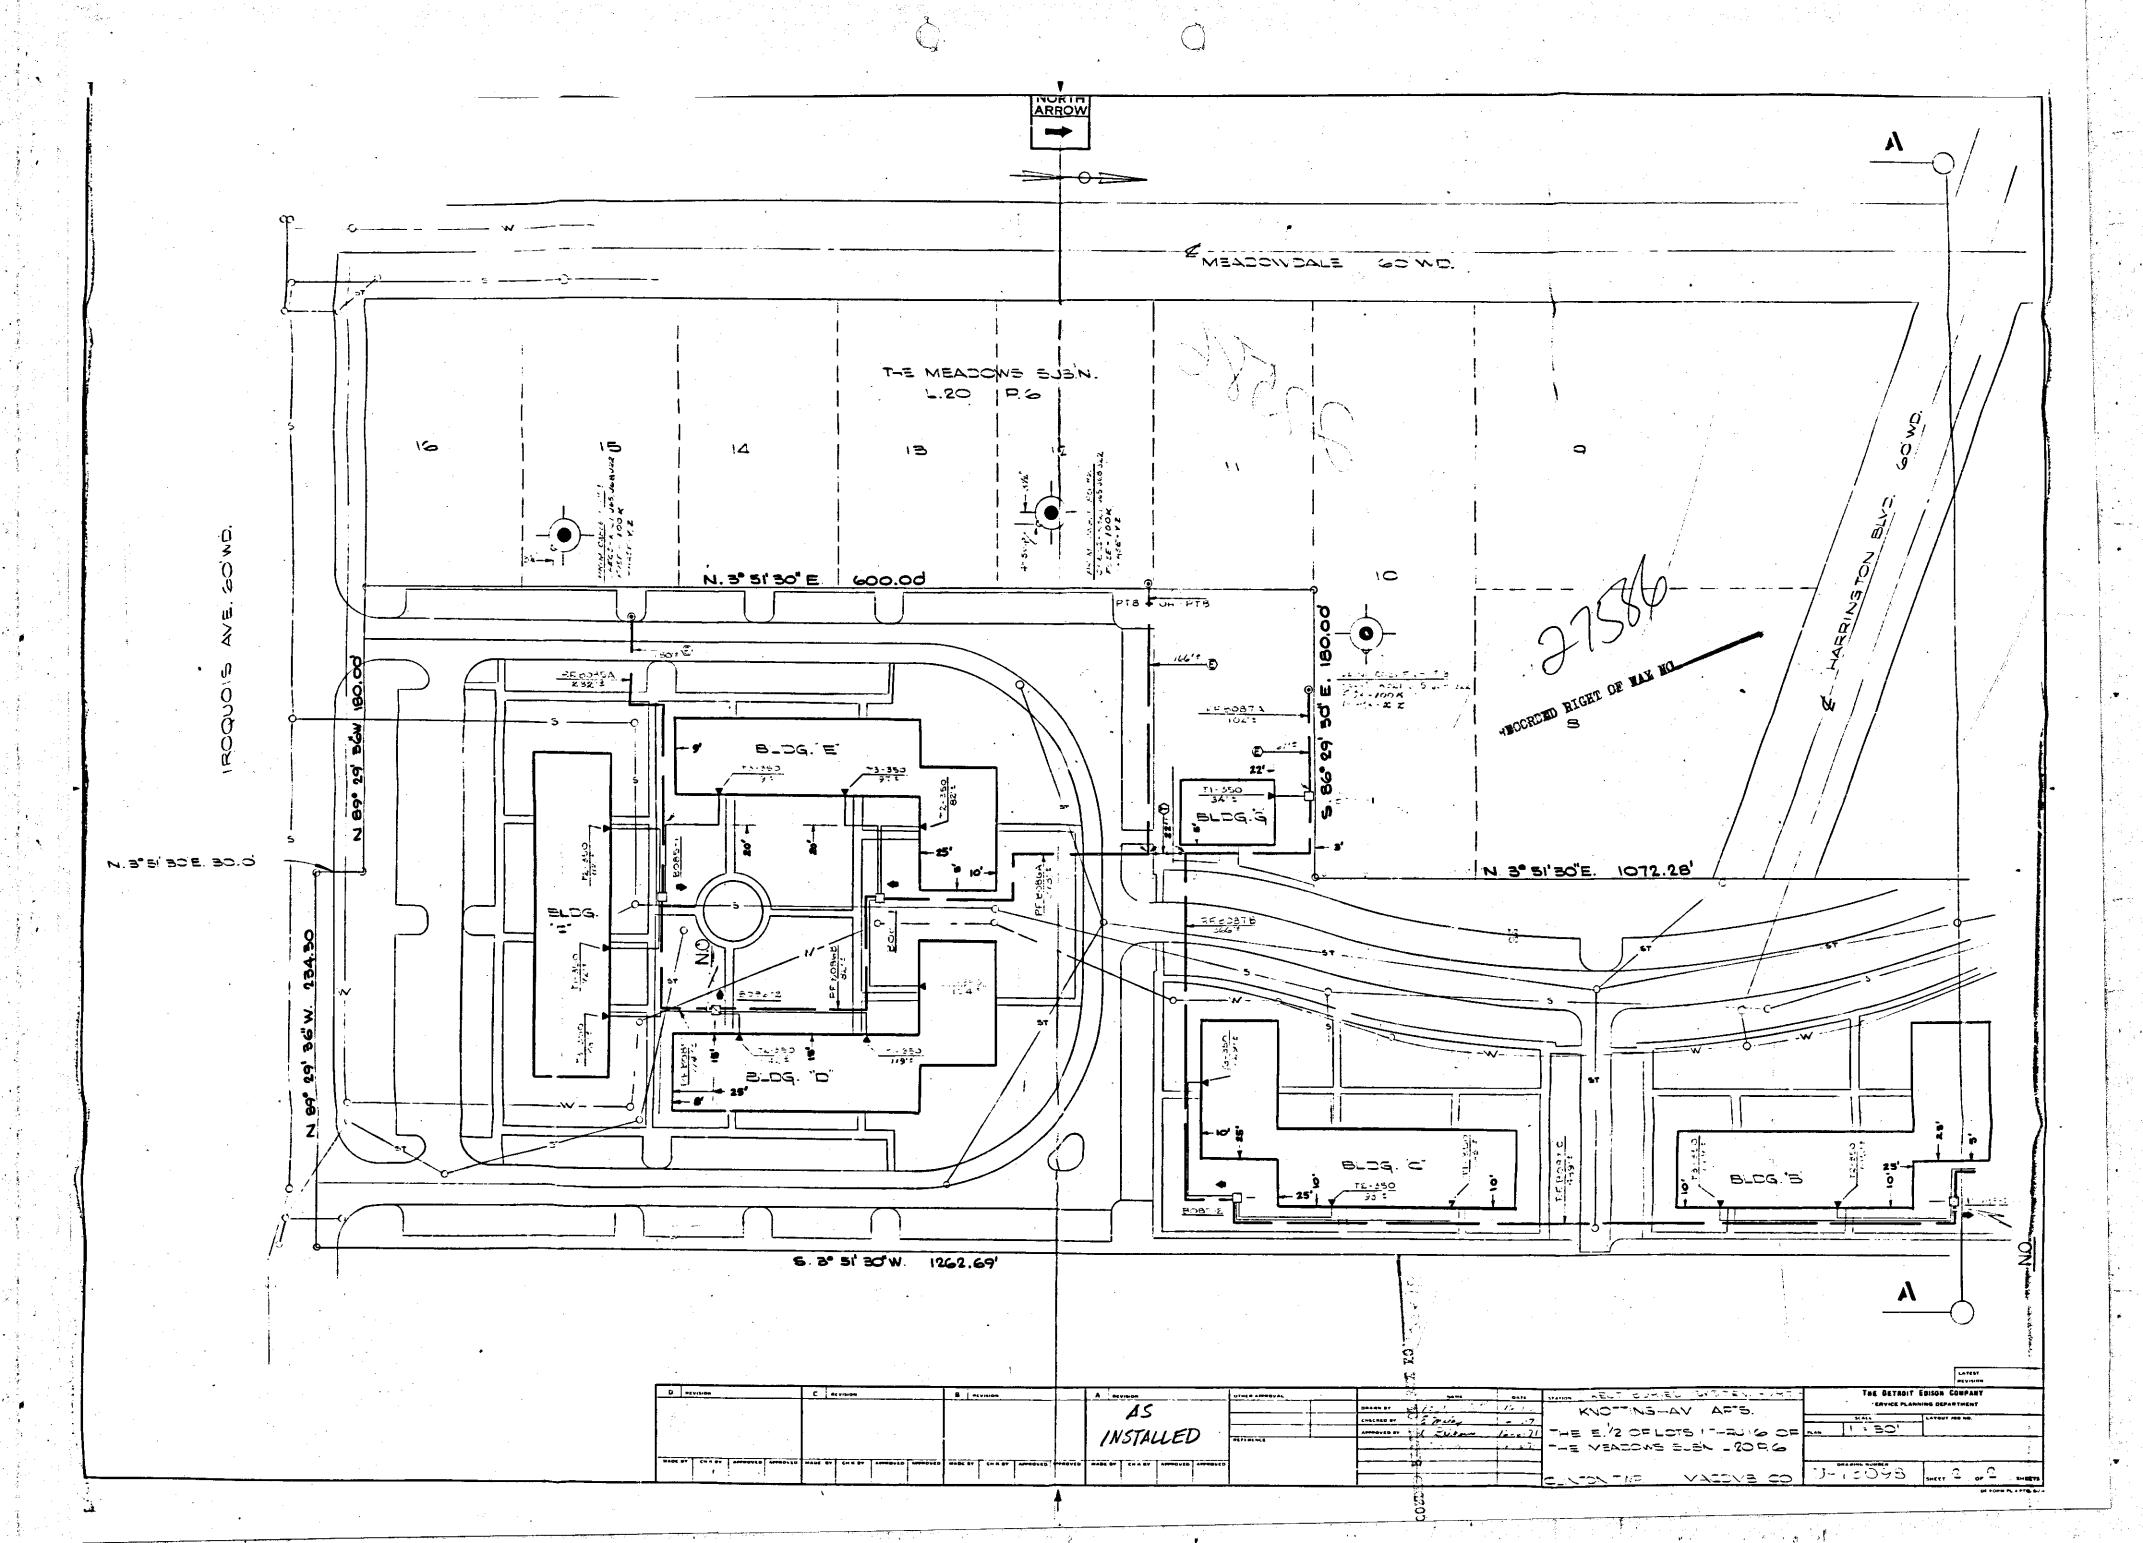

45 INSTALLED