


# THE DETROIT EDISON COMPANY

2000 SECOND AVENUE  
DETROIT, MICHIGAN 48226

November 19, 1969

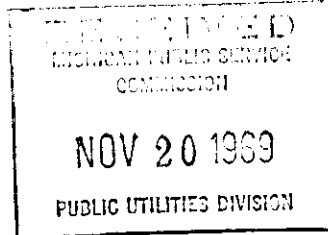

Permit No. ED-8-6072

Michigan Public Service Commission  
Lansing 13, Michigan

Gentlemen:

I, Martin F. Wiler, Superintendent of Transmission Division of The Detroit Edison Company, Detroit, Michigan, hereby certify that the wire crossing, covered by Wire Crossing Permit No. ED-8-6072, issued June 29, 1967, has been constructed in accordance with specifications of the Michigan Public Service Commission and construction standards of The Detroit Edison Company, approved by Michigan Public Service Commission on July 19, 1939, file ED 2-9.01, and that this crossing will be maintained as provided in such specifications and construction standards.

Yours very truly,

*Martin F. Wiler*

RECORDED RIGHT OF WAY NO. 30192  
629

RX No. 3812

Location Honguagen Township,

Section 18, Wayne County

Railroad Detroit, Toledo

and Ironston Railroad

Subscribed and sworn to before me this

19th day of November, 1969.


*Joseph V. Strouse*

Notary Public, Wayne


County, Michigan.

My Commission expires 1-23-71


R. R. File No. L-4845

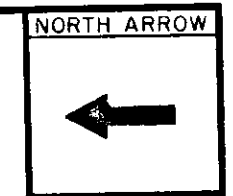



TRENTON CHANNEL-McLOUTH-JEFFERSON #2.  
TRENTON CHANNEL-JEFFERSON  
120KV. LINE.

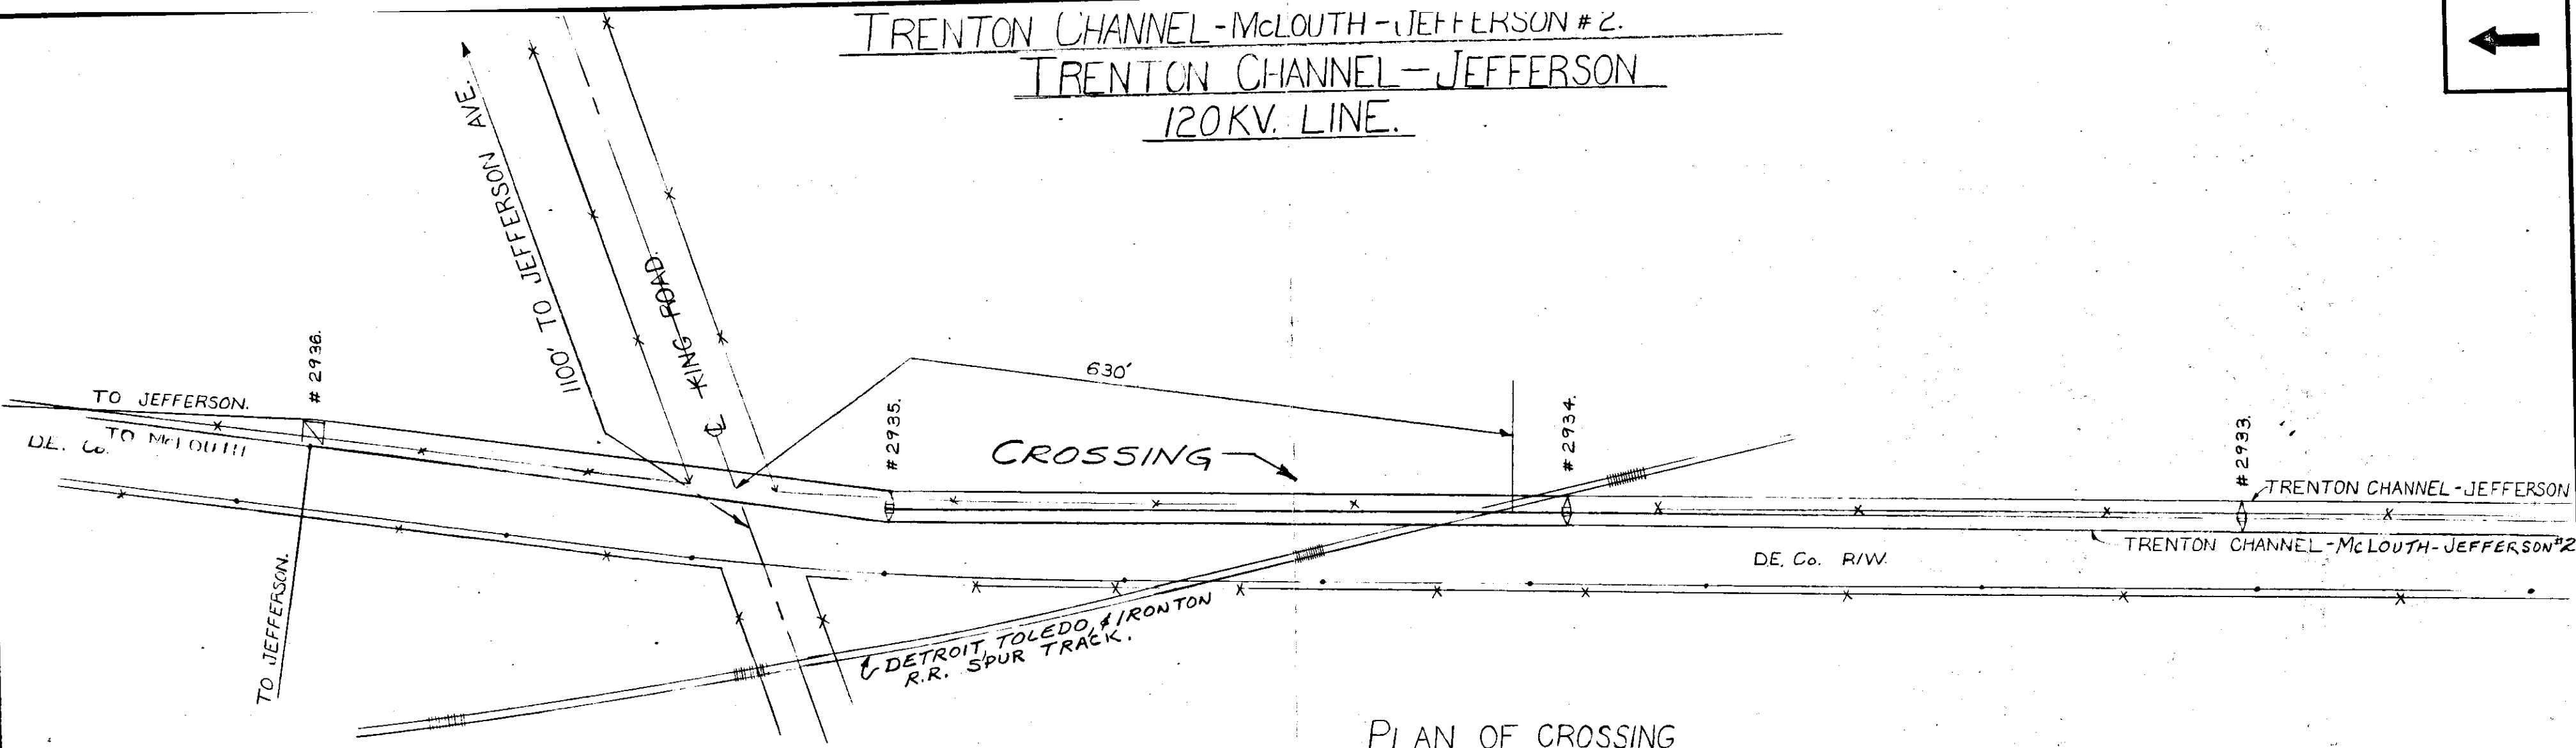

PLAN OF CROSSING  
SCALE: 1" = 100'

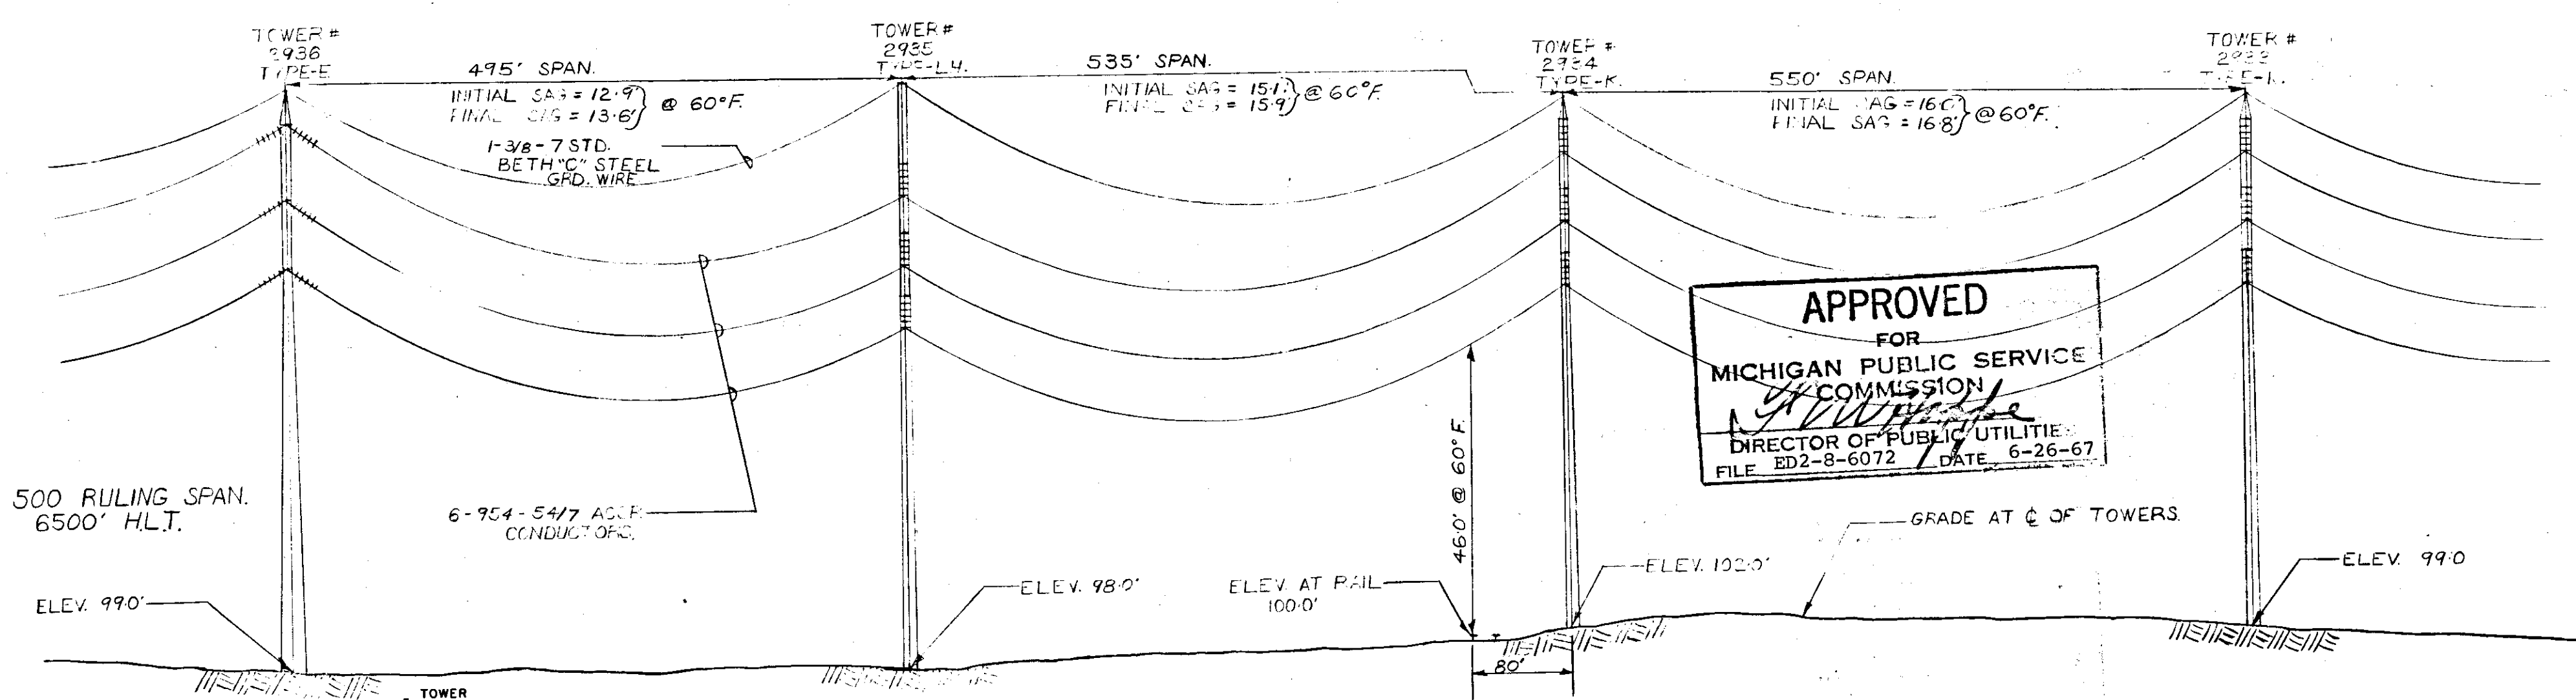

APPROVED  
FOR  
MICHIGAN PUBLIC SERVICE  
COMMISSION  
*[Signature]*  
DIRECTOR OF PUBLIC UTILITIES  
FILE ED2-8-6072 DATE 6-26-67

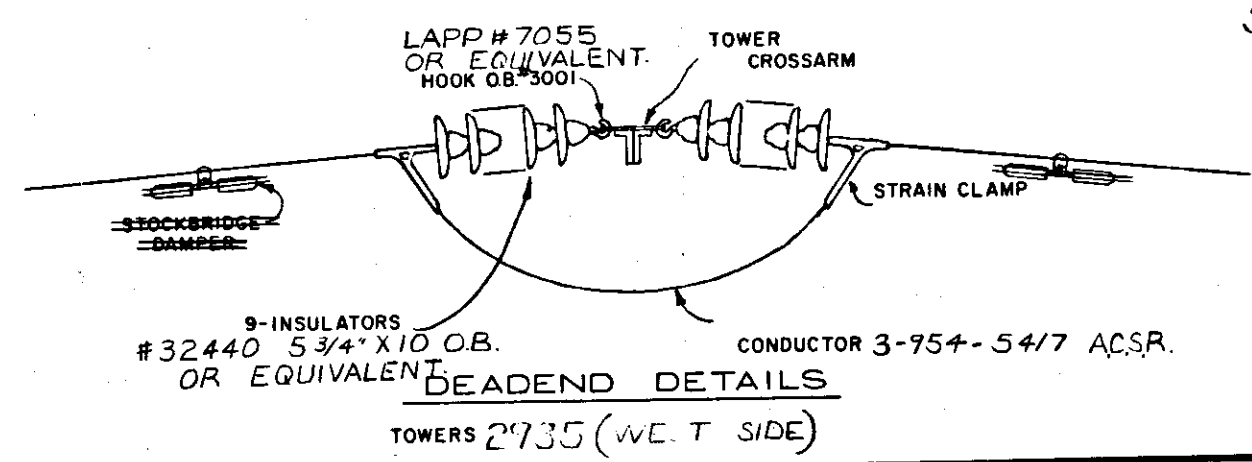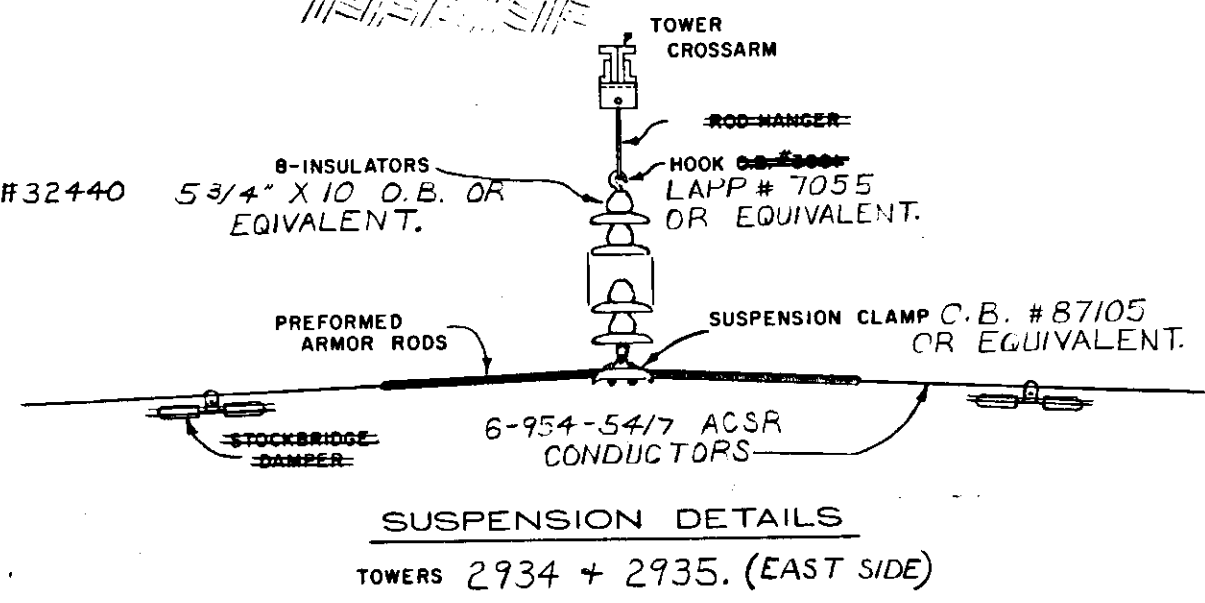

ELEVATION OF CROSSING  
SCALE: HOR. 1" = 100'  
VER. 1" = 20'

CITY TRENTON  
COUNTY WAYNE  
TOWNSHIP MONGUAGON  
S4S. R.11E  
SECTION NO. 18

THE DETROIT EDISON COMPANY  
PLAN SUBMITTED TO  
MICHIGAN PUBLIC SERVICE COMMISSION  
FOR 120,000 VOLT CROSSING  
OVER DETROIT, TOLEDO, & IRONTON R.R.  
DRAWN BY N.H. & M.L.F. DATE 4-25-67  
APPROVED BY *[Signature]* DATE 4-25-67  
PERMIT NO. ED  
DRAWING NO. RX-3812.

PROCESSED RIGHTS OR WEA NO 30190p64

RECORDED RIGHT OF WAY NO. 30/90 964