

STATE OF MICHIGAN

BX 3523
RC 30278



TRANSPORTATION
COMMISSION
WILLIAM C. MARSHALL
LAWRENCE C. PATRICK JR.
HANNES MEYERS, JR.
CARL V. PELLONPAA
WESTON E. VIVIAN
RODGER D. YOUNG

JAMES J. BLANCHARD, GOVERNOR

DEPARTMENT OF TRANSPORTATION

TRANSPORTATION BUILDING, 425 WEST OTTAWA PHONE 517-373-2090
POST OFFICE BOX 30050, LANSING, MICHIGAN 48909

JAMES P. PITZ, DIRECTOR

February 7, 1985

Mr. Les G. Sundstrom
Public Agency Coordinator
Real Estate & R/W Department
Detroit Edison Co.
406 G.O.
2000 Second Avenue
Detroit, MI 48226

Dear Mr. Sundstrom:

Penn Central Corporation Purchase

This letter is to notify you of the acquisition of certain Penn Central Corporation railroad properties by the Michigan Department of Transportation on February 15, 1984. Included in the purchase was the assumption of leases and agreements on the effected lines.

Enclosed are copies of a portion of 29 agreements which were assumed by the department. The Michigan Department of Transportation will be invoicing you for these agreements. In order to establish the amount due, it will be necessary for us to know through what period of time you have paid on each agreement.

Your cooperation would be most appreciated.


Sincerely,

Larry E. Tibbits, Manager
Capital Development Section
Rail Freight and
Water Transportation Division

Enclosure

373-6494


RECORDED RIGHT OF WAY NO. 30278

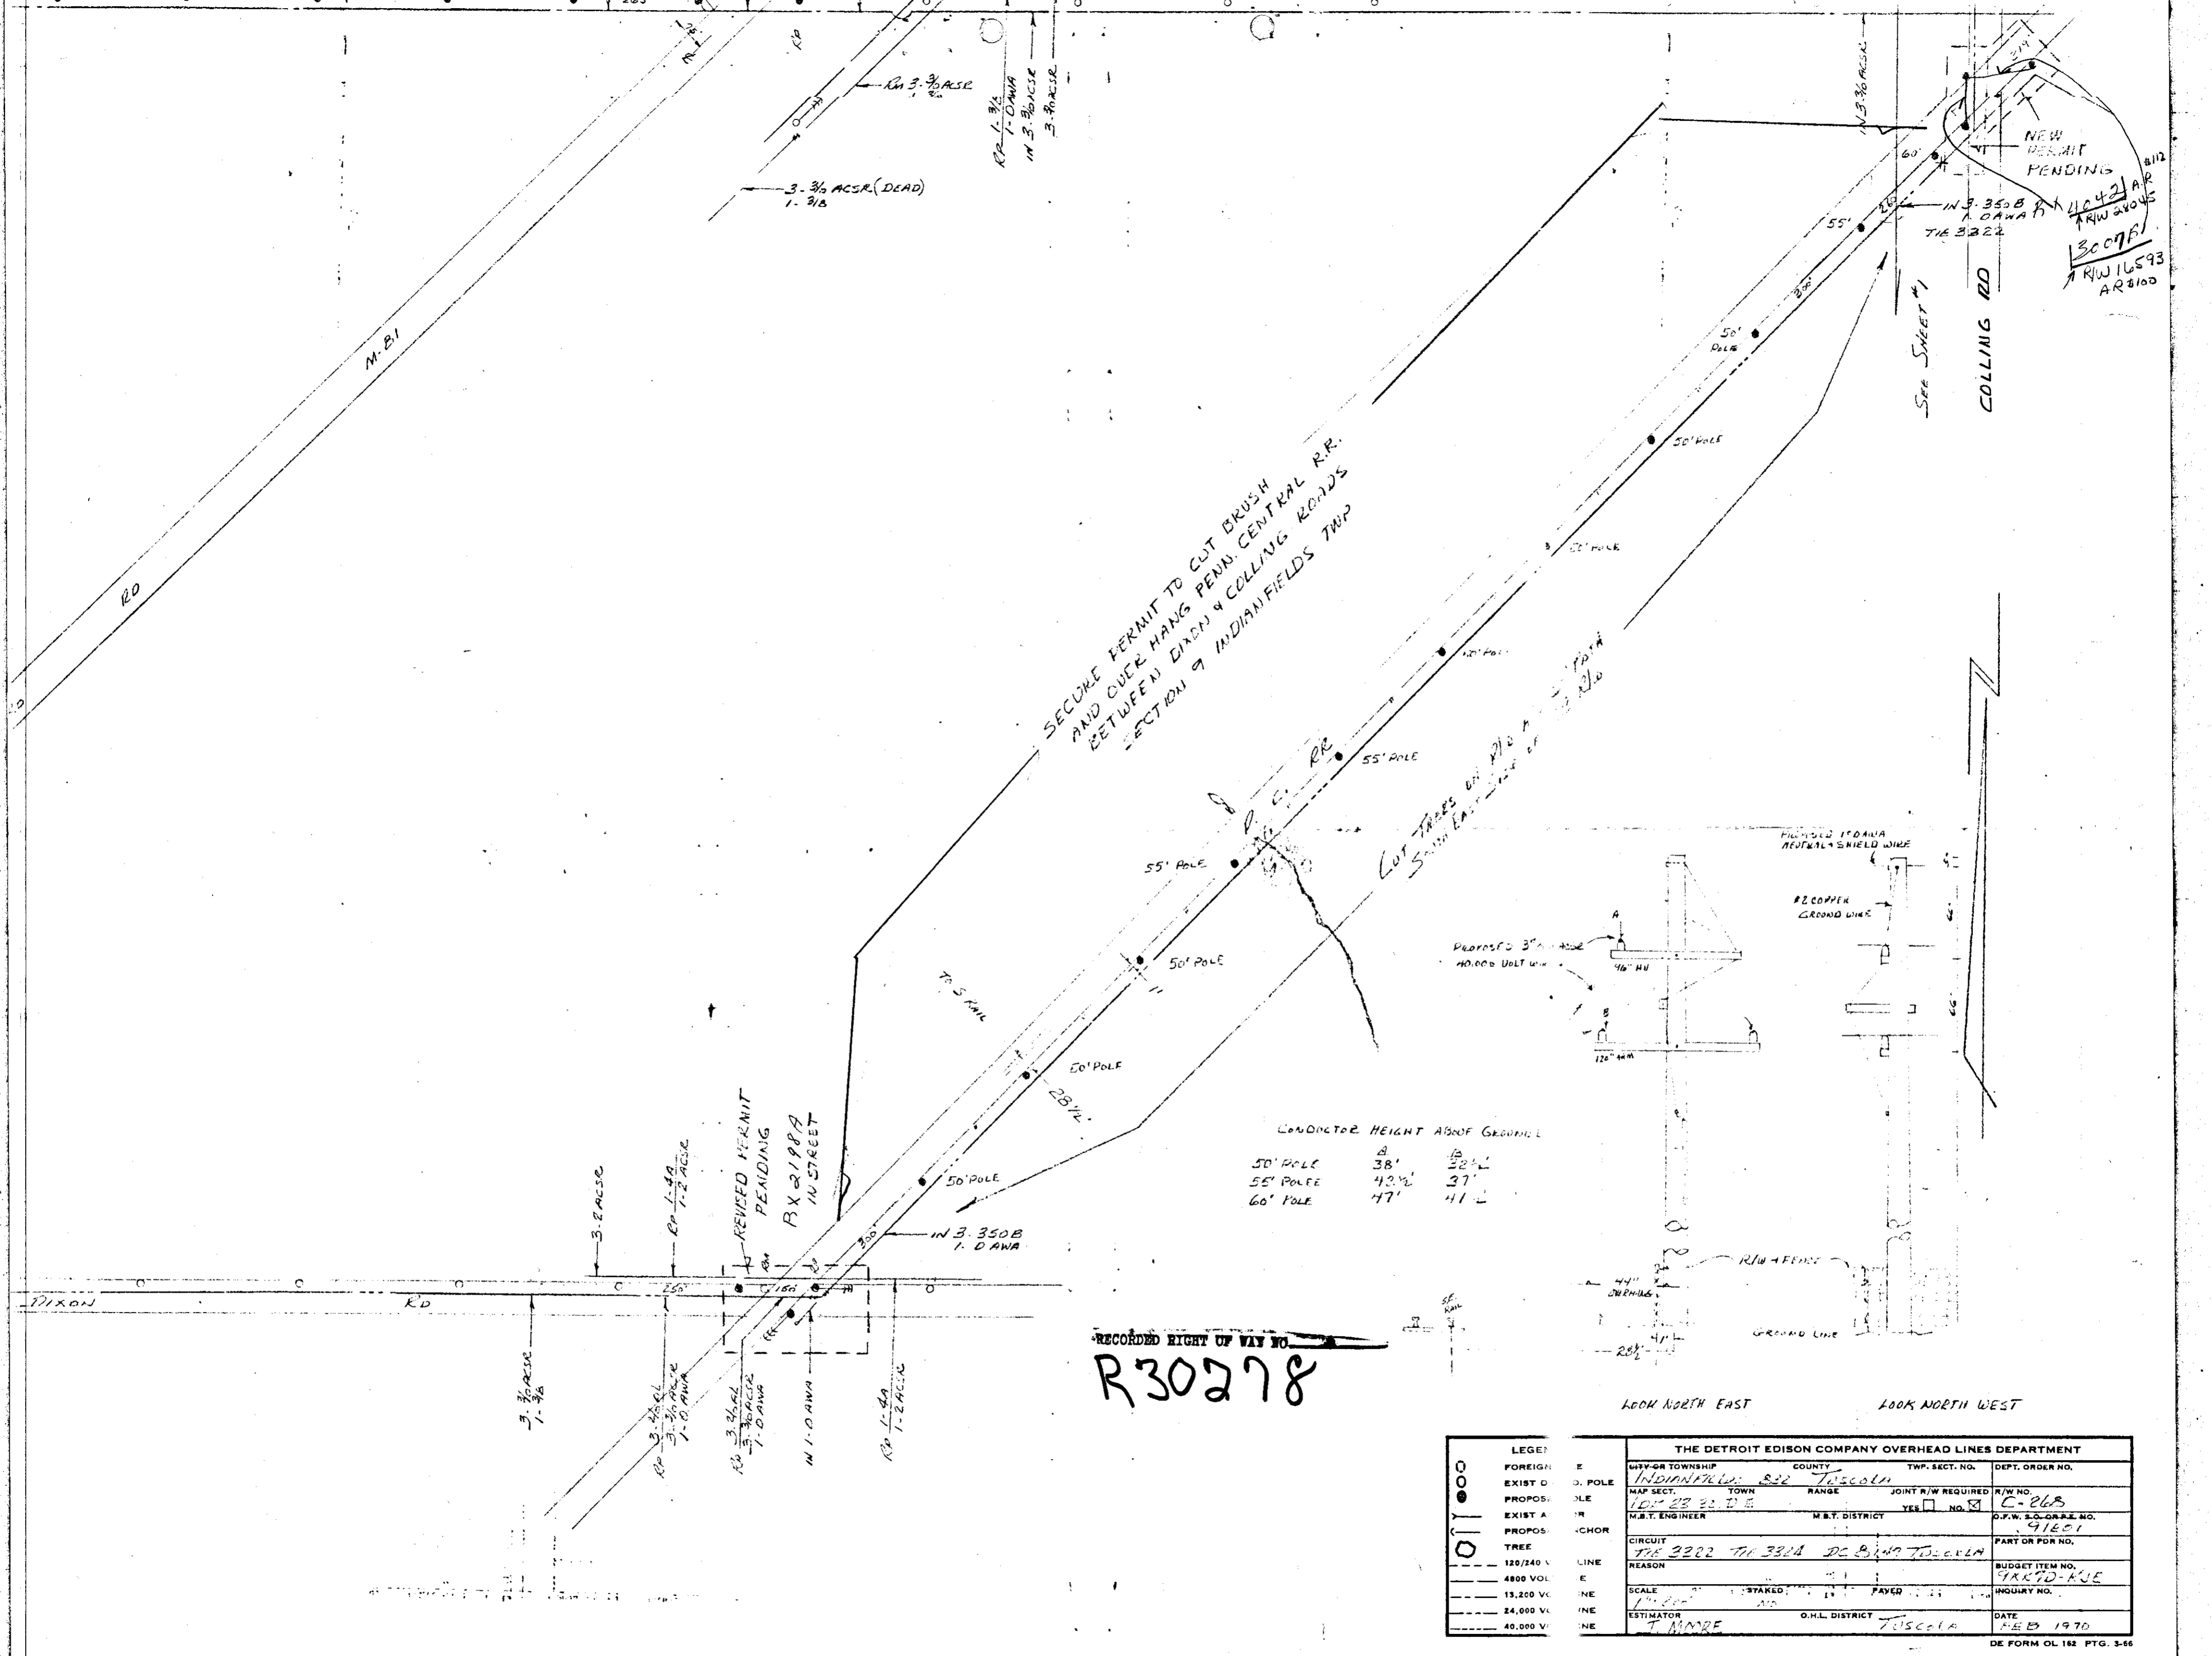

SECURE PERMIT TO CUT BRUSH
AND CUT HANG PENN. CENTRAL R.R.
BETWEEN DIXON & COLLING ROADS
SECTION 9 INDIANFIELDS TWP

CONDUCTOR HEIGHT ABOVE GROUND

50' POLE	38'	32'
55' POLE	42'	37'
60' POLE	47'	41'

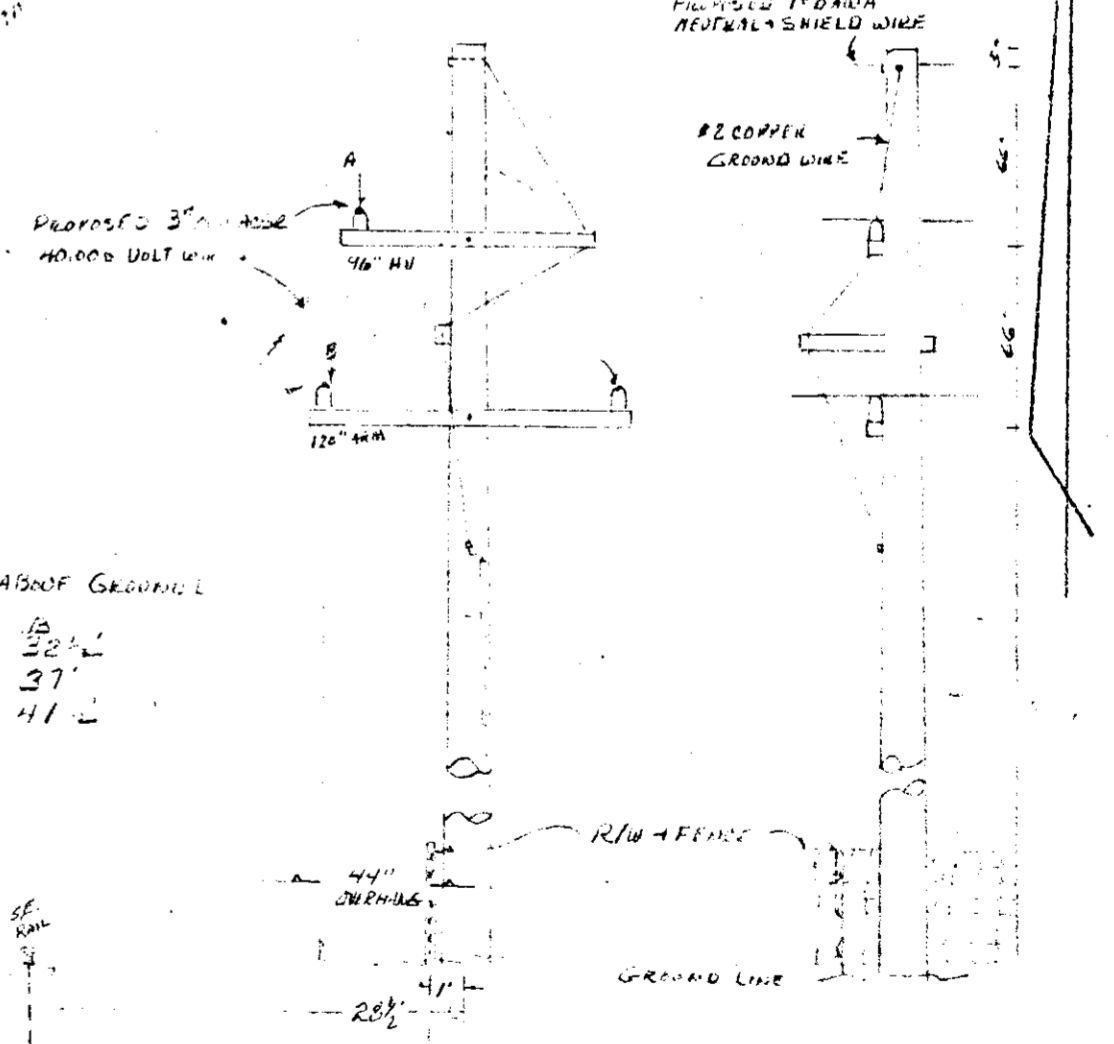

RECORDED RIGHT OF WAY NO.
R30278

THE DETROIT EDISON COMPANY OVERHEAD LINES DEPARTMENT			
CITY OR TOWNSHIP	COUNTY	TWP. SECT. NO.	DEPT. ORDER NO.
Indianfields 832	Tuscola		
MAP SECT.	TOWN	RANGE	JOINT R/W REQUIRED
100 23 32 D E			YES <input type="checkbox"/> NO <input checked="" type="checkbox"/>
M.B.T. ENGINEER	M.B.T. DISTRICT		R/W NO.
			E-268
			D.P.W. S.O. OR.F.E. NO.
			91551
CIRCUIT			PART OR PDR NO.
THE 3322 TO 3324 DC BOND TO COLLING			
LINE	REASON		BUDGET ITEM NO.
120/240 V			TRKTD-ASE
4800 VOL			INQUIRY NO.
15,200 V			
24,000 V			
40,000 V			
ESTIMATOR	O.H.L. DISTRICT		DATE
T. MOORE	TUSCOLA		FEB 1970

RECORDED RIGHT OF WAY NO. 30278