

5-11/14

For good and valuable considerations, the right is hereby granted to The Detroit Edison Company, 2000 Second Avenue, Detroit, Michigan 48226, its successors and assigns, to construct line facilities for the purpose of providing electric service and Company communication service including the necessary poles, guys, anchors, wires and equipment upon, over and across the property described hereinafter. The rights hereby granted include the right of access to and from the said premises, the right to construct, reconstruct, modify, operate and maintain said line facilities, and to trim or cut down any trees belonging to the grantor, either within said right of way or upon the lands of the grantor adjoining said right of way, which, in the opinion of the grantee, at any time interfere with the construction and operation of said line facilities. It is expressly understood and agreed that the grantee shall, at no time, trim or cut down any trees unless, in the grantee's opinion, it is absolutely necessary to do so. Upon the written consent of the grantee, buildings or structures may be placed within said right of way. This grant shall be binding upon the successors and assigns of the grantors. Before construction is completed, the Company shall pay the sum of Five and 00/100 (\$5.00) Dollars for each pole and for each anchor, or the sum of Five and 00/100 (\$5.00) Dollars if no poles or anchors are installed. The Company shall reimburse the grantors and assigns for all damage caused by its men, vehicles and equipment in entering said property for the purposes set forth herein.

The property over which this grant is conveyed is situated in the Township of Addison, County of Oakland, State of Michigan and further described as follows:

The West 1/2 of the Southwest 1/4 of the Northeast 1/4, except the East 290 feet of Section 14, T5N, R11E,

The route of said lines shall be as follows: In a Easterly and Westerly direction across said land, approximately ~~200~~ ^{38'} feet North of the South property line.

38' FEA

RECORDED
OAKLAND COUNTY RECORDS
REGISTER OF DEEDS
1916 MAR 30 PM 1:14
Lynn D. Allen
CLERK-REGISTER OF DEEDS

RECORDED RIGHT OF WAY NO. 30280

Witness: Michael J. Mc Cabe
Michael J. Mc Cabe

(Signed) Ethel E. Arnold
Ethel E. Arnold

x Robert H. Rehe
Robert H. Rehe

Prepared By:
M. Mc Cabe
76 S. Gratiot Avenue
Mt. Clemens, Michigan 48043

3740 Rochester Road
Leonard, Michigan

STATE OF MICHIGAN)
) SS.
COUNTY OF Oakland)

On this 29th day of June A.D. 19 75, before the under-
signed, a Notary Public in and for said County, personally appeared Ethel E. Arnold, survivor of her-
self and of her deceased husband Horace Richard Arnold

known to me to be the person _____ who executed the foregoing instrument and acknowledged the same to be her free act and deed.

Michael J. Mc Cabe
Michael J. Mc Cabe
Notary Public, Macomb County, Michigan

My Commission Expires: 2-10-76

APPROVED AS TO FORM: 02-75 DATE
LEGAL DEPARTMENT: [Signature]

3.00

HIGH VOLTAGE TRANSMISSION PAYMENT AGREEMENT
DE FORM PD 148 10-56X

6-17-75

Dated _____

THE UNDERSIGNED, on the date hereof granted to THE DETROIT EDISON COMPANY, its successors and assigns, a right of way over land in the _____ Township _____ of _____ Addison _____, County of Oakland and State of Michigan, described as follows:

The West 1/2 of the Southwest 1/4 of the Northeast 1/4, except the East 290 feet of Section 14, T5N, R11E.

In the event of the construction of its lines in said right of way, it is understood and agreed that THE DETROIT EDISON COMPANY, its successors and assigns, shall be obligated to pay to the undersigned the sum of One Thousand Dollars and no/100 (\$1,000)----- Dollars as payment in full for said right of way. Payment of the sum herein stated shall be made before actual line construction is commenced in said right of way.

The right to receive the sum herein stated shall be personal to the undersigned grantors of said right of way and shall not pass with a conveyance of the premises which are subject to the right of way herein referred to. The right to receive said sum shall not pass from the undersigned except after an assignment of the right to receive said sum has been made and actual notice of said assignment has been received by THE DETROIT EDISON COMPANY in writing.

(signed)

x *Philip E Arnold*


(ACCEPTED)

THE DETROIT EDISON COMPANY

By X _____

RECORDED
30280

- R.W. NOTES:**
1. THIS LINE TO BE 120 K.V. CONSTRUCTION ON WOOD POLES.
 2. POLE SIZES AND LOCATIONS AS SHOWN.
 3. DE CO. WILL REQUIRE 60' AT ALL ANG. SLOTS.
 4. DE CO. WILL REQUIRE EASEMENTS AS SHOWN.
 5. CUT 40' SWATH THRU ANY AND ALL TREES (NOT SHOWN) THAT FALL IN EASEMENTS REQUIRED BY DE. CO.
 6. ALL TREES ADJACENT TO NEW LINE TO BE TRIMMED TO 20' CLEARANCE.

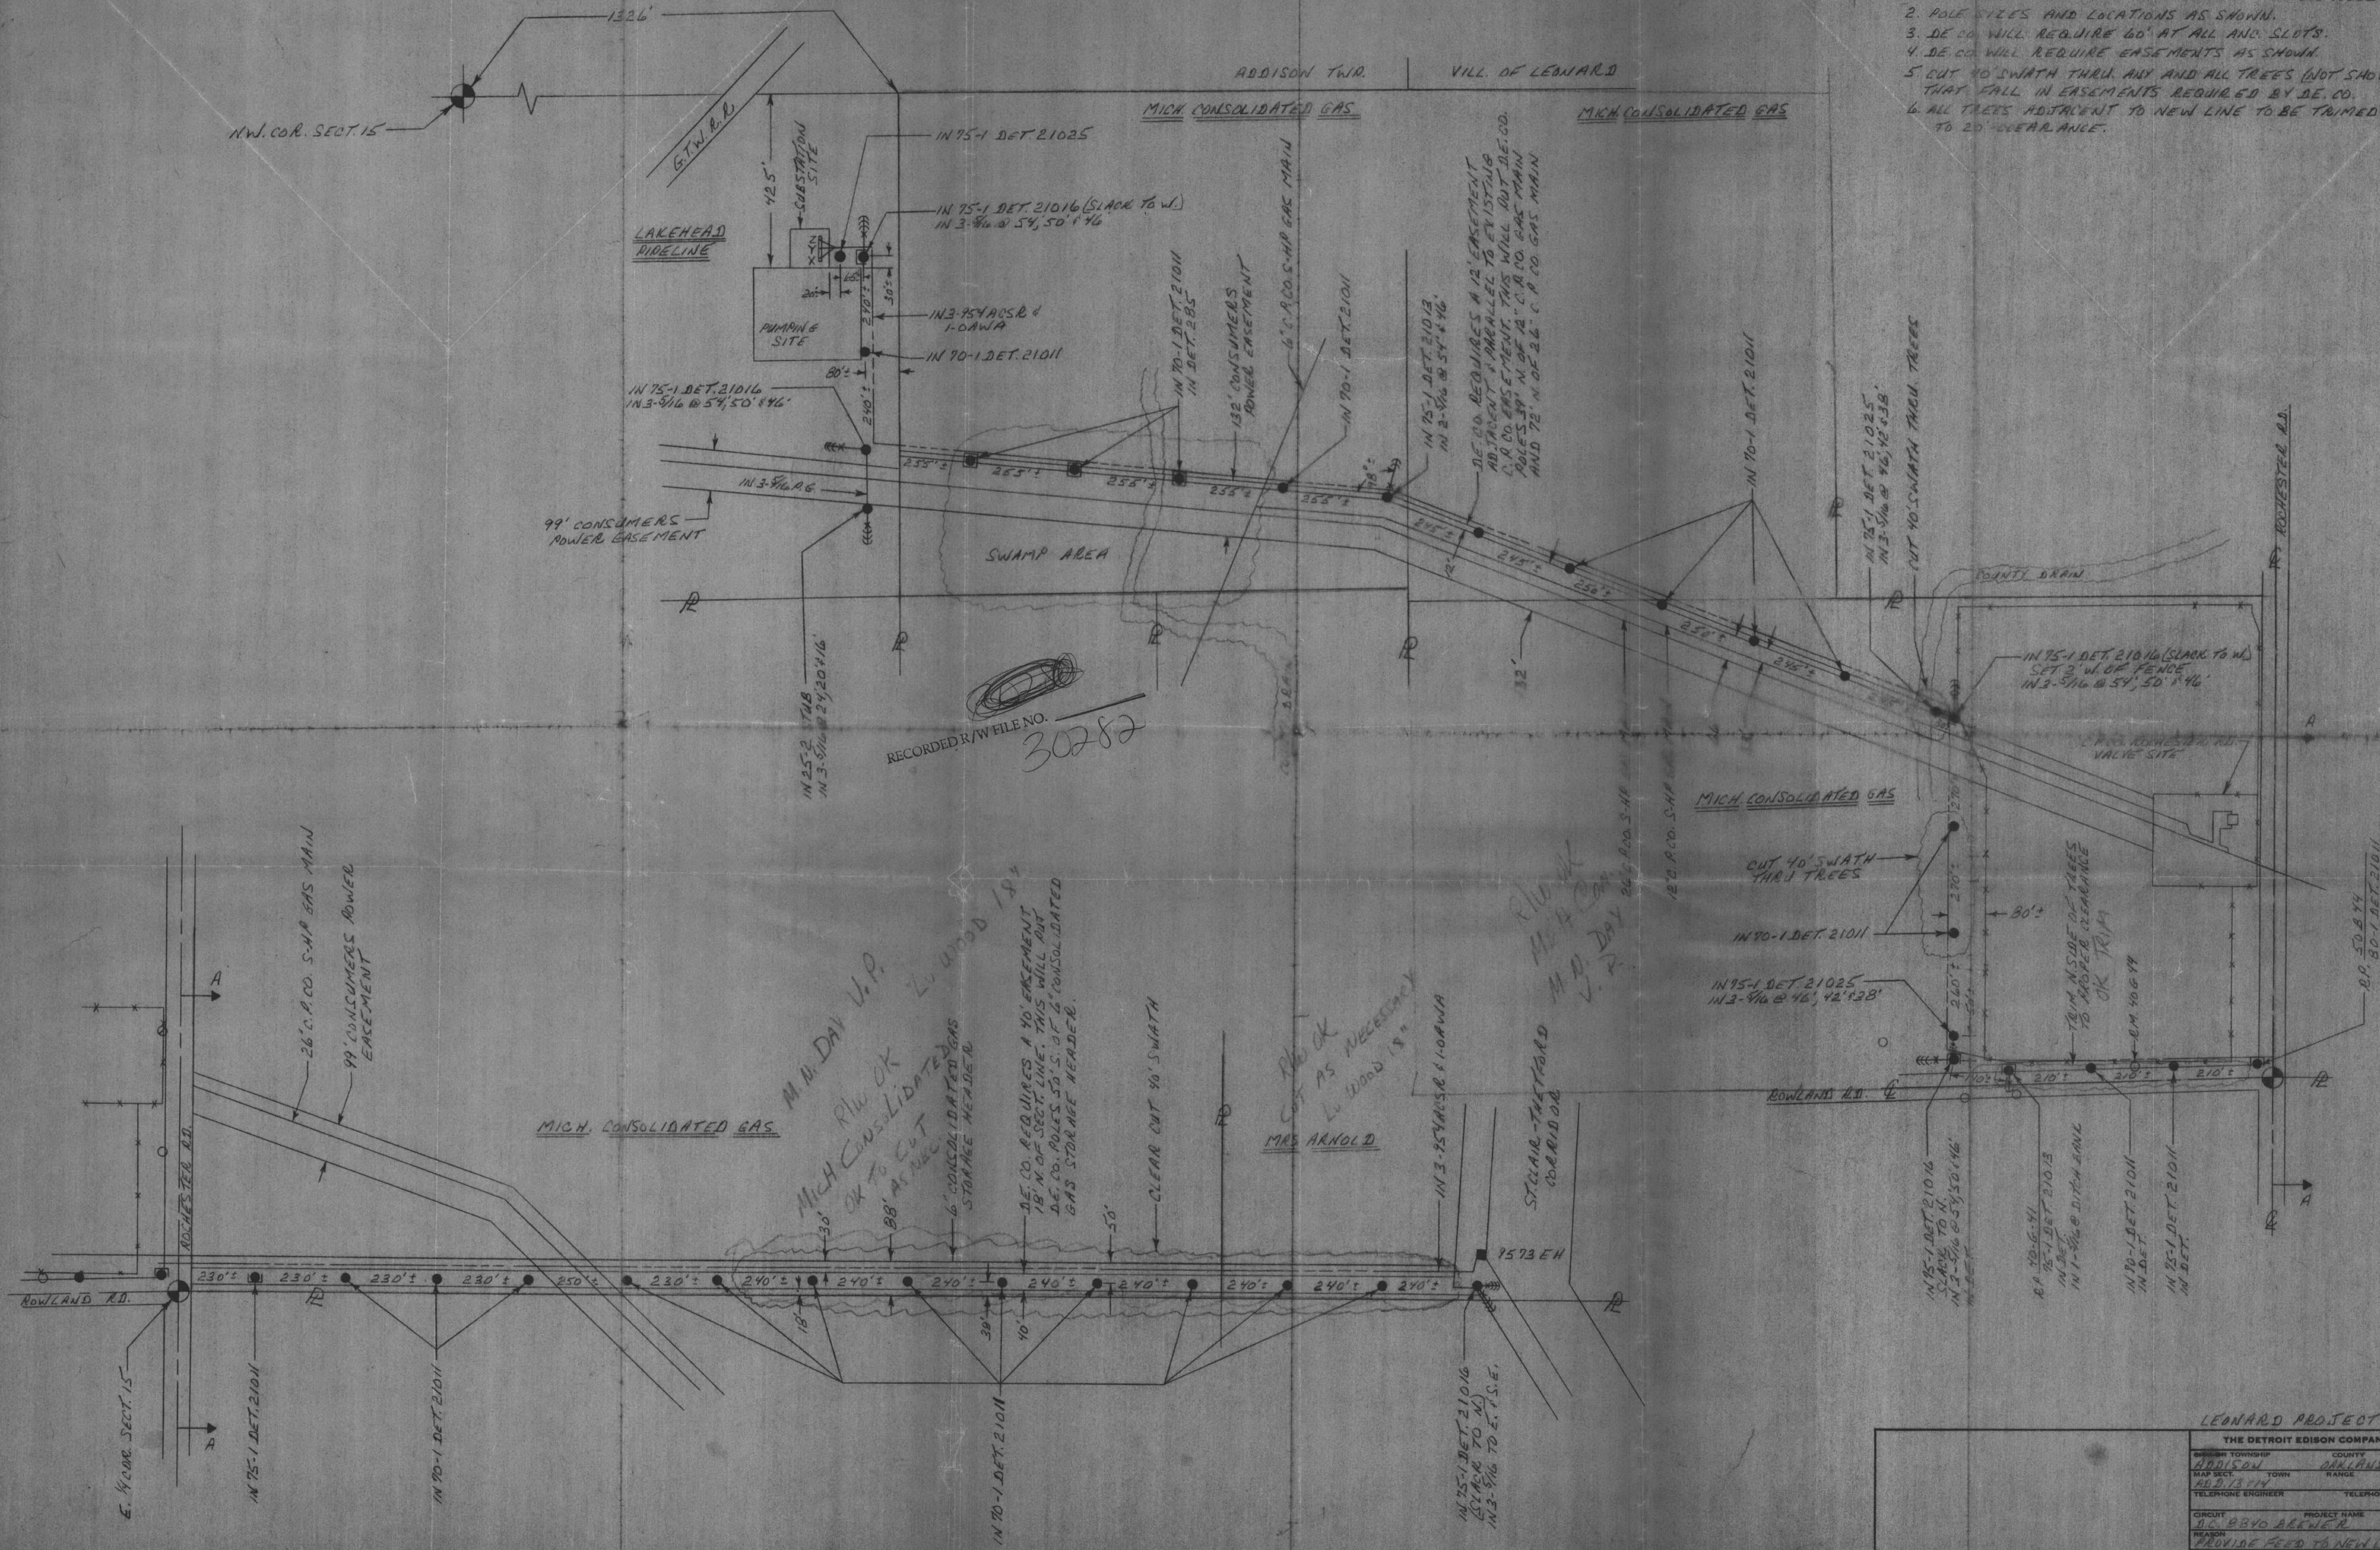

RECORDED R/W FILE NO. 30282

MICH. CONSOLIDATED GAS

MICH. CONSOLIDATED GAS

LEONARD PROJECT #469A

THE DETROIT EDISON COMPANY SERVICE PLANNING DEPARTMENT			
ADDISON TOWNSHIP	COUNTY	TWP. SECT. NO.	DEPT. ORDER NO.
ADDISON	DARLAND	14+15	
ADD. SECT.	RANGE	JOINT R/W REQUIRED	R/W NO.
40+15/16		YES [] NO []	40+167 "A"
TELEPHONE ENGINEER	TELEPHONE DISTRICT		BUDGET ITEM NO.
			469A-1401
CIRCUIT	PROJECT NAME		SCALE
46 8840 BLENCH	ROWLAND FEED TO NEW LEONARD SUB.		1" = 200'
REASON			DATE
LAYOUT BY			2-6-75

RECORDED RICHIE DE MAY NO. 30280 30282

~~30280~~

30282