LIBER 1522 PAGE 485

LIBER 1637 PAGE 519 RECEIVED FOR RECORD

ALC 26 10 34 AM '75

PATRICIA NEWKIRK HARDY REGISTER OF DEEDS WASHTENAW COUNTY, MICH. Re- Recorded

XAPABEMBNEXXX TOWNHOUSES

AGREEMENT - EASEMENT - RESTRICTIONS

PATRICIA NEWKIRK HARDY RECISTER OF DEEDS WASHTENAW COUNTY, MICH.

This instrument made this 144 day of + AUG , 19<u>.75</u>, by and between the undersigned Owners and THE DETROIT EDISON COMPANY, a corporation organized and existing concurrently under the laws of the states of Michigan and New York, of 2000 Second Avenue, Detroit, Michigan, 48226, hereinafter called "EDISON", and MICHIGAN BELL TELEPHONE COMPANY, a Michigan corporation, of 1365 Cass Avenue, Detroit, Michigan, 48226, hereinafter called "BELL."

## WITNESSETH:


townhouses WHEREAS, Owners are erecting apartments known as Mill Creek , on land in the TOWNISMAXEMENT City of Ann Arbor	<del></del> ,
county of Washtenaw, State of Michigan, as described in Appendix "A", attached hereto and made a part hereof, and EDISON and BELL will install their electric and communication facilities underground except necessary above ground	
equipment.	RI.CC

NOW, THEREFORE, in consideration of the mutual promises and covenants for the installation of underground utility service made by the parties hereto, it is hereby agreed:

- (1) The installation, ownership and maintenance of electric services and the charges to be made therefor shall be subject to and in accordance with the Orders and Rules and Regulations adopted from time to time by the Michigan Public Service Commission.
- (2) Owners must certify to EDISON and BELL that the easements are graded to within four (4") inches of final grade before the underground facilities are installed.
- (3) Owners further agree that if subsequent to the installation of the utility facilities of EDISON and BELL, it is necessary to repair, move, modify, rearrange or relocate any of their facilities to conform to a new plot plan or change of grade or for any cause or changes attributable to public authority having jurisdiction or to Owners action or request, Owners will pay the cost and expense of repairing, moving, rearragement or relocating said facilities to EDISON or BELL upon receipt of a statement therefor. Further, if the lines or facilities of EDISON and BELL are damaged by acts of negligence on the part of the Owners or by contractors engaged by Owners, repairs shall be made by the utilities named herein at the cost and expense of the Owners and shall be paid to EDISON or BELL upon receiving a statement therefor. Owners are defined as those persons owning the land at the time damage occurred.
- (4) Owners hereby grant to EDISON and BELL easement for electric and communication underground services in land herein described. When utility lines are installed, this instrument shall be re-recorded with an "as installed" drawing showing the location of utility facilities in relation to building lines and indicating the easements by their centerlines. Easements herein granted shall be six (6') feet in width unless otherwise indicated on said drawing. However, secondary electric service and communication entrance line locations, as shown on an installed drawing are not guaranteed; actual locations can be determined after contact with utilities.
- (5) Owners to pay the cost of conduit for electric and/or communication facilities to accomodate patios or similar site conditions.
- Easements herein granted are subject to the following restrictions (6) and additional conditions:
  - Said easements shall be subject to Order of and the Rules and Regulations adopted from time to time by the Michigan Public Service Commission.

This instrument is re-recorded to show "as installed" drawing as stipulated in paragraph 4 above, and attached hereto and made a part hereof.

DE FORM LE 11 11 71 CS

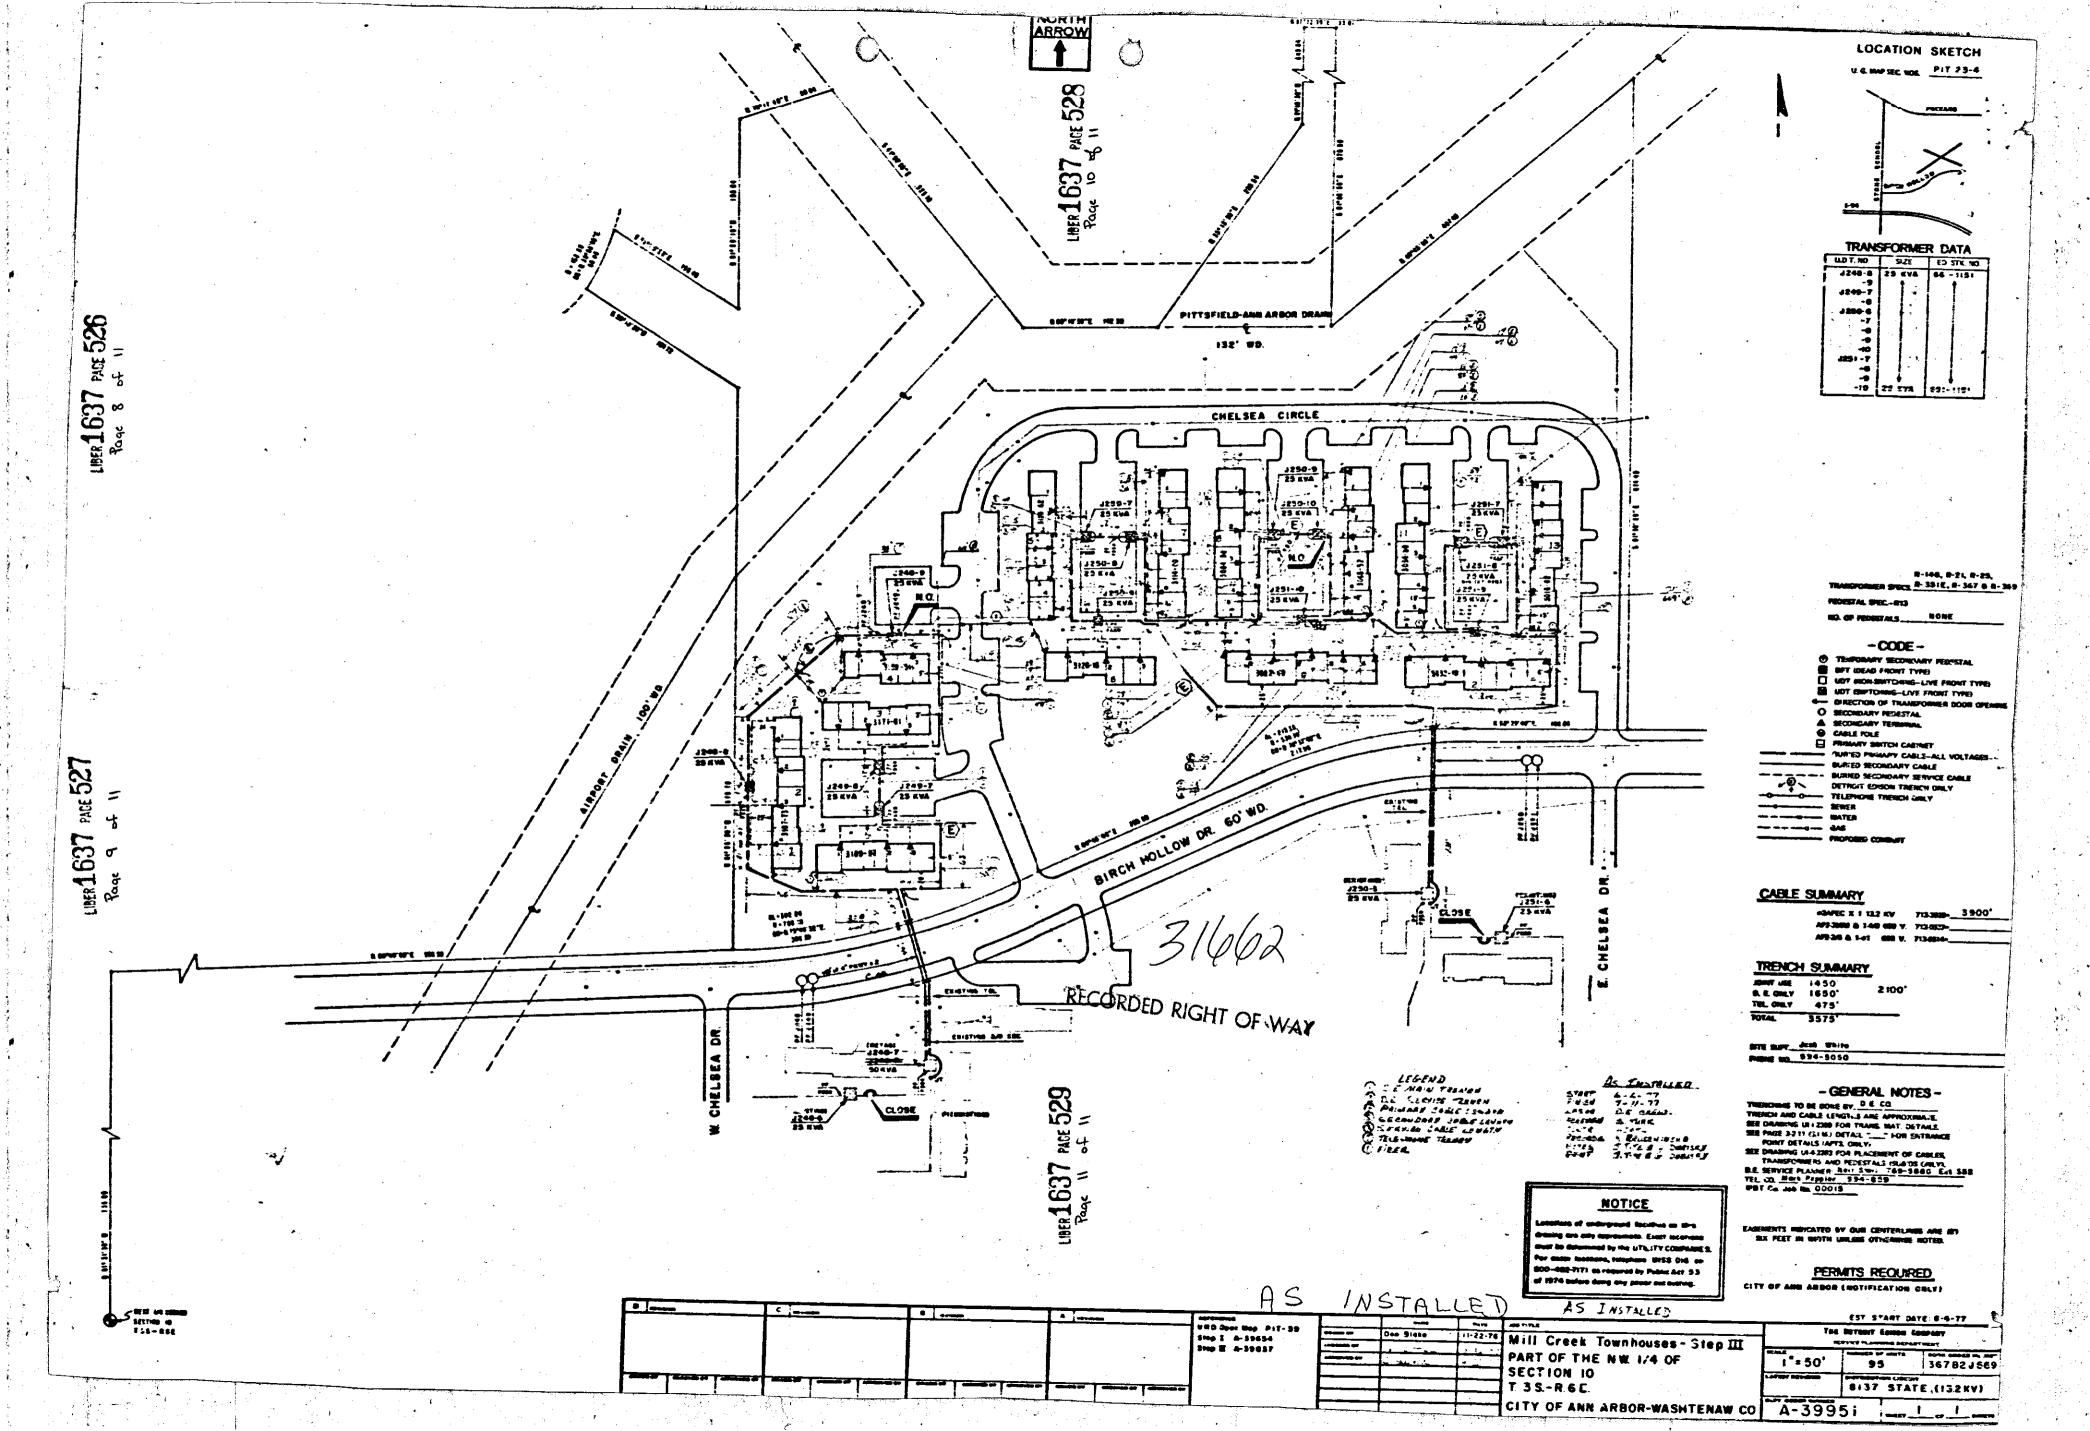

93.00

15 E 29972 \*c 02300 . 1907

RECEIVED FOR RECORD FEB 15 10 11 AM '78 PATRICIA NEWKIRK HARDY REGISTER OF DEEDS WASHTENAW COUNTY, MICH.

R.J. Ort
The Detroit Edison Company
2929 Plymouth Rd., Room 210
Ann Arbor, MI 48105

 $\bigcirc$