

RE-RECORD

G598968

LI 21191 PA 545

Detroit Edison

G675760

Right of Way Agreement

LI 21437 PA 757

JUNE 23<sup>RD</sup>, 19 81

For valuable consideration, the receipt of which is hereby acknowledged, the undersigned hereby grant and convey to THE DETROIT EDISON COMPANY, a corporation organized and existing concurrently under the laws of the States of Michigan and New York, of 2000 Second Avenue, Detroit, Michigan 48226 and the MICHIGAN BELL TELEPHONE COMPANY, a Michigan corporation, of 444 Michigan Avenue, Detroit, Michigan 48226 hereinafter referred to as "UTILITIES", the easement and right to erect, lay, maintain, reconstruct and replace underground facilities consisting of wires, cables, conduits, fixtures and appurtenances including the necessary above ground equipment, connections, poles and accessories which may from time to time be required in, under, upon, over and across the land located in the City of Detroit, WAYNE County, Michigan, and more particularly described on the attached Appendix "A", with the full right to the UTILITIES of ingress and egress upon said land for the purposes of this grant, and the further right to trim, cut down or otherwise control brush and trees within the easements herein described.

Said easements shall be Six (6') feet in width unless otherwise indicated and their route is described as follows:

The exact location of said easements will be shown on an "As Installed Drawing" to be recorded within 90 days after construction.

In order to provide for the proper maintenance and protection of UTILITIES, the undersigned covenant and agree that:

1. The easements will be graded to within four (4) inches of final grade before the UTILITIES lines are installed and this ground elevation must be maintained after installation of utilities to avoid the pooling of water in, on or around above ground UTILITIES' equipment.

2. No buildings or structures other than UTILITIES equipment are to be placed within the easements herein granted. No excavation is to be permitted within said easement without approval of UTILITIES.

3. No shrubs of foliage shall be planted or grown within five (5) feet of the front door of transformers or switching cabinet enclosures. UTILITIES shall not be responsible to Owners for damages to or removal of trees or plant life planted in front of said door or within the easement causing an interference with UTILITIES maintenance of their equipment.

4. If the lines of facilities of UTILITIES are damaged by the acts of Owners, their agents, employes or contractors, repairs shall be made by the Utility company so damaged at the cost and expense of Owners. Owners are defined as those persons owning the land at the time the damage occurred.

THIS GRANT is declared to be binding upon the heirs, successors, lessees, licenses and assigns of the parties hereto.

WITNESS WHEREOF, the undersigned have hereunto set their hand and seal on this date.

RE-RECORD

Witnesses:

Grantors: NEW CENTER DEVELOPMENT PARTNERSHIP, A Michigan Limited Partnership

V. D. Register (Signature)

BY: NEW CENTER COMMUNITY CORPORATION (Signature)

RECORDED JUL 15 1982 AT 11:03 O'CLOCK AM

D. J. FOURNIER (Signature)

FOREST E. YOUNGBLOOD, Register of Deeds WAYNE COUNTY, MICHIGAN 48226

BY: A. T. HASTINGS Vice President (Signature)

MARGUERITE ROMZICK Secretary (Signature)

Prepared By: C. George Williams

Address: 3044 West Grand Boulevard

8001 S. Haggerty Rd., Belleville, MI., 48111

Detroit, Michigan, 48202

THIS EASEMENT IS RE-RECORDED FOR PURPOSES OF SHOWING THE PLANNED "AS INSTALLED" CENTERLINES OF EASEMENTS GRANTED AS SHOWN ON DRAWING ATTACHED HERETO. RECORDED JUL 14 1981 AT 12:06 P M FOREST E. YOUNGBLOOD, Register of Deeds WAYNE COUNTY, MICHIGAN 48226


G675760

G598968

RECORDED RIGHT OF WAY NO. 33855

LI 21191 PA 546

LI 21437 PA 758

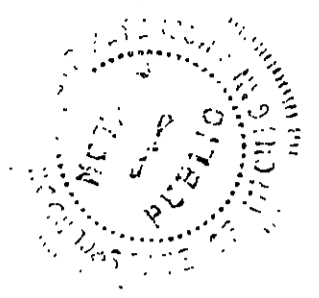

STATE OF MICHIGAN )  
 ) ss.  
COUNTY OF WAYNE )

The foregoing instrument was acknowledged before me this *23rd* day of *June*, A. D. 1981, by A. T. HASTINGS and MARGUERITE ROMZICK, Vice President and Secretary of NEW CENTER COMMUNITY CORPORATION, General Partner of NEW CENTER DEVELOPMENT PARTNERSHIP, a Limited Partnership, on behalf of the said Partnership.

*Acting as*

*Gordon Philip Peterson*

Notary Public, Wayne County, Michigan

GORDON PHILIP PETERSON  
My Commission Expires: Notary Public, Oakland County, Mich.  
My Commission Expires July 11, 1983

RECORDED RIGHT OF WAY NO. 33855

Property located in the City of Detroit,  
County of Wayne and State of Michigan,  
more particularly described as follows:

Lots 26, 27, 28, 30, 31, 32, and 34  
inclusive, all excepting the South 5.50  
feet thereof as deeded for alley widen-  
ing, of "Stone, Todd & Co.'s Subdivision  
of Lots 1, 2 and 3 of Plat of center  
part of 1/4 Sections 55 and 56 of the  
10,000 Acre Tract, and Lots 41, 42, 43,  
and 44 of Henry Weber's Subdivision of  
1/4 Sections 55 and 56 of the 10,000  
Acre Tract", City of Detroit, Wayne  
County, Michigan, as recorded in Liber  
18 of Plats on Page 99, Wayne County  
Records. Commonly known as 659, 667,  
675, 691, 701, 707, and 723 Delaware.

A N D

That part of Lot 6, Block 4, of "Henry  
Weber's Subdivision of part of Sections  
55 and 56, 10,000 Acre Tract", City of  
Detroit, Wayne County, Michigan, as  
recorded in Liber 2 of Plats on Page  
40, Wayne County Records, lying North  
of the East-West public alley, 20 feet  
wide (the North 10 feet of which was  
opened through said Lot), excepting the  
South 5.50 feet of the above described  
parcel deeded for the widening of the  
East-West public alley, also that part  
of the vacated public alley lying between  
the North line of Lot 6, Block 4, and  
South of the South line of Delaware Avenue,  
all being located in the City of Detroit,  
Wayne County, Michigan. Commonly known as  
747-53 Delaware.

A N D

That part of Lot 5, Block 4, of "Henry  
Weber's Subdivision of part of Sections  
55 and 56, 10,000 Acre Tract", City of  
Detroit, Wayne County, Michigan, as re-  
corded in Liber 2 of Plats on Page 40,  
Wayne County Records, lying North of the  
East-West public alley 20 feet wide (the  
North 10 feet of which was opened through  
said Lot), excepting the South 5.50 feet  
of the above described parcel, deeded for  
the widening of the East-West public alley,  
also that part of the vacated public alley  
lying between the North line of Lot 5,  
Block 4, and South of the South line of  
Delaware Avenue, all being located in the  
City of Detroit, Wayne County, Michigan.  
Commonly known as 739-41 Delaware.

A N D

The West 10 feet of Lot 1 and the East  
40 feet of Lot 2, all excepting the South  
11.00 feet thereof as deeded for alley

RECORDED RIGHT OF WAY NO. 33855

widening, of "Leggett and Miller Subdivision of part of Lots 10 to 30 of Henry Weber's Subdivision of part of 1/4 Sections 55 and 56, 10,000 Acre Tract", as recorded in Liber 28 of Plats, Page 3, Wayne County Records. Commonly known as 811-13 Delaware

A N D

The West 30 feet of the North 117.96 feet of Lot 38, Block 4, and the East 3 feet of the West 33 feet of the North 8.50 feet of said Lot 38, Block 4, also including the South 13 feet of vacated Parkman Avenue, lying in the rear of and adjoining the West 33 feet of said Lot 38, all being part of "Henry Weber's Subdivision of part of Sections 55 and 56, 10,000 Acre Tract", City of Detroit, Wayne County, Michigan, as recorded in Liber 2 of Plats, Page 40, Wayne County Records. Commonly known as 818 Delaware

A N D

The West 10 feet of Lot 2, and the East 25 feet of Lot 3, all excepting the South 11.00 feet thereof as deeded for alley widening, of "Leggett and Miller Subdivision of part of Lots 10 to 30 of Henry Weber's Subdivision of part of 1/4 Sections 55 and 56, 10,000 Acre Tract", City of Detroit, Wayne County, Michigan, as recorded in Liber 28 of Plats, Page 3, Wayne County Records. Commonly known as 819-21 Delaware.

A N D

The West 25 feet of Lot 3 and the East 30 feet of Lot 4, all excepting the South 11.00 feet thereof as deeded for alley widening, of "Leggett and Miller Subdivision of part of Lots 10 to 30 of Henry Weber's Subdivision of part of 1/4 Sections 55 and 56, 10,000 Acre Tract", City of Detroit, Wayne County, Michigan, as recorded in Liber 28 of Plats, Page 3, Wayne County Records. The above described parcel of land is possibly subject to easements per Deed Liber 19336, Page 729, Wayne County Records. Commonly known as 827-31 Delaware.

A N D

The East 20 feet of the North 117.96 feet of Lot 38, Block 4, excepting therefrom the West 3 feet of the North 8.50 feet of said parcel; and the West 15 feet of the North 117.96 feet of Lot 39, Block 4, also including the South 13 feet of vacated Parkman Avenue, lying in the rear of and

RECORDED RIGHT OF WAY NO. 33855

adjoining the East 17 feet of said Lot 38, and said West 15 feet of Lot 39, Block 4, all being part of "Henry Weber's Subdivision of part of Sections 55 and 56, 10,000 Acre Tract", City of Detroit, Wayne County, Michigan, as recorded in Liber 2 of Plats, Page 40, Wayne County Records. Commonly known as 810-12 Delaware.

A N D

The North 20.25 feet of the South 40.65 feet of the North 102.54 feet of the West 30 feet of Lot 9, Block 4, of "Henry Weber's Subdivision of part of Sections 55 and 56, 10,000 Acre Tract", City of Detroit, Wayne County, Michigan, as recorded in Liber 2 of Plats, Page 40, Wayne County Records; also the North 20.25 feet of the South 40.65 feet of the East 40 feet of Lot 1 of "Leggett and Miller Subdivision of part of Lots 10 to 30 of Henry Weber's Subdivision of part of 1/4 Sections 55 and 56, 10,000 Acre Tract", City of Detroit, Wayne County, Michigan, as recorded in Liber 28 of Plats, Page 3, Wayne County Records. The above described parcel of land is possibly subject to an easement over and across the West 26.50 feet thereof to provide ingress and egress to a public alley, together with an easement to provide ingress and egress to Delaware Avenue, also possibly subject to a party wall agreement along part of the North and South property line. Commonly known as 7743 Third.

A N D

The South 20.40 feet of the North 102.54 feet of the West 30 feet of Lot 9, Block 4, "Henry Weber's Subdivision of part of Sections 55 and 56, 10,000 Acre Tract", City of Detroit, Wayne County, Michigan, as recorded in Liber 2 of Plats, Page 40, Wayne County Records. Also, the South 20.40 feet of the East 40 feet of Lot 1 of Leggett and Miller Subdivision of part of Lots 10 to 30 of Henry Weber's Subdivision of part of 1/4 Sections 55 and 56, 10,000 Acre Tract", as recorded in Liber 28 of Plats, Page 3, Wayne County Records, City of Detroit, Wayne County, Michigan. The above described parcel of land is possibly subject to an easement over and across the West 26.50 feet thereof to provide ingress and egress to a public alley, together with an easement to provide ingress and egress to Delaware Avenue, also possibly subject to a party wall agreement along part of

RECORDED IN LIBER 2 OF PLATS, PAGE 40, WAYNE COUNTY RECORDS. 33855

the North property line. Commonly known as 7741 Third.

A N D

The East 35 feet of the North 117.96 feet of Lot 39, and West 30 feet of North 117.96 feet of Lot 40, Block 4, together with the Southerly 13 feet of vacated Parkman Avenue, lying Northerly of and adjoining said parcel, Henry Weber's Subdivision as recorded in Liber 2 of Plats, Page 40, Wayne County Records. Commonly known as 8001-8021 Third.

A N D

The East 40 feet of that part of Lot 7, Block 4, of "Henry Weber's Subdivision of part of Sections 55 and 56, 10,000 Acre Tract", as recorded in Liber 2 of Plats, Page 40, Wayne County Records, lying North of the East-West public alley (20 feet wide), excepting the South 5.50 feet of the East 9.00 feet of the above described parcel as deeded for alley widening, also that part of the vacated public alley lying between the North line of the East 40 feet of Lot 7, Block 4, and South of the South line of Delaware Avenue, City of Detroit, Wayne County, Michigan. Commonly known as 7740-7750 Third.

A N D

The West 35 feet of Lot 37 of "Lothrop and Duffield's Subdivision of part of 1/4 Sections 55 and 56, 10,000 Acre Tract", City of Detroit, Wayne County, Michigan, as recorded in Liber 17 of Plats, Page 22, Wayne County Records. Commonly known as 756 Bethune.

A N D

The East 35 feet of Lot 71 and the West 5 feet of Lot 72, all excepting the South 11.00 feet thereof as deeded for alley widening, of "Lothrop and Duffield's Subdivision of part of 1/4 Sections 55 and 56, 10,000 Acre Tract", City of Detroit, Wayne County, Michigan, as recorded in Liber 17 of Plats, Page 22, Wayne County Records. Commonly known as 741 Bethune.

A N D

The East 35 feet of the West 40 feet of Lot 72, except the South 11.00 feet thereof as deeded for alley widening, of "Lothrop and Duffield's Subdivision

RECORDED RIGHT OF WAY NO. 33855

of part of 1/4 Sections 55 and 56, 10,000 Acre Tract, City of Detroit, Wayne County, Michigan, as recorded in Liber 17 of Plats, Page 22, Wayne County Records. Commonly known as 735 Bethune.

A N D

The East 10 feet of Lot 72 and the West 40 feet of Lot 73, all excepting the South 11.00 feet thereof as deeded for alley widening, of "Lothrop and Duffield's Subdivision of part of 1/4 Sections 55 and 56, 10,000 Acre Tract", City of Detroit, Wayne County, Michigan, as recorded in Liber 17 of Plats, Page 22, Wayne County Records. Commonly known as 725 Bethune.

A N D

The East 20 feet of Lot 74 and the West 15 feet of Lot 75, all excepting the South 11.00 feet thereof as deeded for alley widening, of "Lothrop and Duffield's Subdivision of part of 1/4 Sections 55 and 56, 10,000 Acre Tract", City of Detroit, Wayne County, Michigan, as recorded in Liber 17 of Plats, Page 22, Wayne County Records. Commonly known as 709 Bethune.

A N D

The West 40 feet of Lot 76, except the South 11.00 feet thereof as deeded for alley widening, of "Lothrop and Duffield's Subdivision of part of 1/4 Sections 55 and 56, 10,000 Acre Tract", City of Detroit, Wayne County, Michigan, as recorded in Liber 17 of Plats, Page 22, Wayne County Records. Commonly known as 693 Bethune.

A N D

The West 25 feet of Lot 77 and the East 10 feet of Lot 76, all excepting the South 11.00 feet thereof as deeded for alley widening, of "Lothrop and Duffield's Subdivision of part of 1/4 Sections 55 and 56, 10,000 Acre Tract", City of Detroit, Wayne County, Michigan, as recorded in Liber 17 of Plats, Page 22, Wayne County Records. Commonly known as 685 Bethune.

A N D

The West 10 feet of Lot 78 and the East 25 feet of Lot 77, all excepting the South 11.00 feet thereof as deeded for alley widening, of "Lothrop and Duffield's Subdivision of part of 1/4 Sections 55 and

RECORDED RIGHT OF WAY NO. 33855

56, 10,000 Acre Tract", City of Detroit, Wayne County, Michigan, as recorded in Liber 17 of Plats, Page 22, Wayne County Records. Commonly known as 675 Bethune.

A N D

The East 40 feet of Lot 78, except the South 11.00 feet thereof as deeded for alley widening, of "Lothrop and Duffield's Subdivision of part of 1/4 Sections 55 and 56, 10,000 Acre Tract", City of Detroit, Wayne County, Michigan, as recorded in Liber 17 of Plats, Page 22, Wayne County Records. Commonly known as 667 Bethune.

A N D

The West 33.33 feet of Lot 79, except the South 11.00 feet thereof as deeded for alley widening, of "Lothrop and Duffield's Subdivision of part of 1/4 Sections 55 and 56, 10,000 Acre Tract", City of Detroit, Wayne County, Michigan, as recorded in Liber 17 of Plats, Page 22, Wayne County Records. Commonly known as 661 Bethune.

A N D

Lot 31, except the South 11.00 feet thereof as deeded for alley widening, of "Leggett's Subdivision of part of Henry Weber's Subdivision of part of Sections 55 and 56, 10,000 Acre Tract", City of Detroit, Wayne County, Michigan, as recorded in Liber 21 of Plats, Page 53, Wayne County Records. Commonly known as 749 Pallister.

A N D

Lot 30 and the West 7.50 feet of Lot 29, all excepting the South 11.00 feet thereof as deeded for alley widening, of "Leggett's Subdivision of part of Henry Weber's Subdivision of part of Sections 55 and 56, 10,000 Acre Tract", City of Detroit, Wayne County, Michigan, as recorded in Liber 21 of Plats, Page 53, Wayne County Records. Commonly known as 741 Pallister.

A N D

The West 10 feet of Lot 25 and the East 35 feet of Lot 26, all excepting the South 11.00 feet thereof as deeded for alley widening, of "Leggett's Subdivision of part of Henry Weber's Subdivision of part of Sections 55 and 56, 10,000 Acre Tract", City of Detroit, Wayne County, Michigan, as recorded in Liber 21 of Plats, Page 53,

RECORDED AND INDEXED MAY 10. 1935



Wayne County Records. Commonly known as  
697 Pallister.

A N D

The West 20 feet of Lot 22 and the East  
40 feet of Lot 23, all excepting the South  
11.00 feet thereof as deeded for alley  
widening, of "Leggett's Subdivision of  
part of Henry Weber's Subdivision of part  
of Sections 55 and 56, 10,000 Acre Tract",  
City of Detroit, Wayne County, Michigan, as  
recorded in Liber 21 of Plats, Page 53,  
Wayne County Records. Commonly known as  
665 Pallister.

A N D

The Esat 8.50 feet of Lot 24, Block 8  
and the West 26.50 feet of the vacated  
street (66 feet wide, lying East of and  
adjacent to the East line of said Lot  
24), all excepting the South 11.00 feet  
thereof as deeded for alley widening,  
being part of "Beck's Subdivision of part  
of 1/4 Sections 55 and 56, 10,000 Acre  
Tract", City of Detroit, Wayne County,  
Michigan, as recorded in Liber 4 of  
Plats, Page 59, Wayne County Records.  
Commonly known as 837 Seward.

A N D

The East 35 feet of the West 61.50  
feet of the vacated street (66 feet  
wide) lying between Blocks 7 and 8,  
except the South 11.00 feet thereof as  
deeded for alley widening, of "Beck's  
Subdivision of part of 1/4 Sections 55  
and 56, 10,000 Acre Tract", City of  
Detroit, Wayne County, Michigan, as re-  
corded in Liber 4 of Plats on Page 59,  
Wayne County Records. Commonly known as  
829-31 Seward.

A N D

The West 30.50 feet of Lot 13, Block 7,  
and the East 4.50 feet of the vacated  
street (66 feet wide) lying between Blocks  
7 and 8, all excepting the South 11.00  
feet thereof as deeded for alley widening,  
being part of "Beck's Subdivision of part  
of 1/4 Sections 55 and 56, 10,000 Acre  
Tract", City of Detroit, Wayne County,  
Michigan, as recorded in Liber 4 of Plats  
on Page 59, Wayne County Records.  
Commonly known as 823 Seward.

A N D

The West 17 feet of Lot 14 and the East  
13 feet of Lot 13, Block 7, all excepting

RECORDED  
RIGHT OF WAY NO. 33855

LI 21191 PA 554  
LI 21437 PA 766


the South 11.00 feet thereof as deeded for alley widening, of "Beck's Subdivision of part of 1/4 Sections 55 and 56, 10,000 Acre Tract", City of Detroit, Wayne County, Michigan, as recorded in Liber 4 of Plats, on Page 59, Wayne County Records. Commonly known as 815 Seward.

A N D

The West 3.50 feet of Lot 16, all of Lot 15, and the East 33 feet of Lot 14, Block 7, excepting the South 11.00 feet of the West 21.50 feet thereof, deeded for alley widening, of "Beck's Subdivision of part of 1/4 Sections 55 and 56, 10,000 Acre Tract", City of Detroit, Wayne County, Michigan, as recorded in Liber 4 of Plats, Page 59, Wayne County Records. Commonly known as 801-807 Seward and 8043-8051 Third.

RECORDED RIGHT OF WAY NO. 33855

SEE SHEET -2

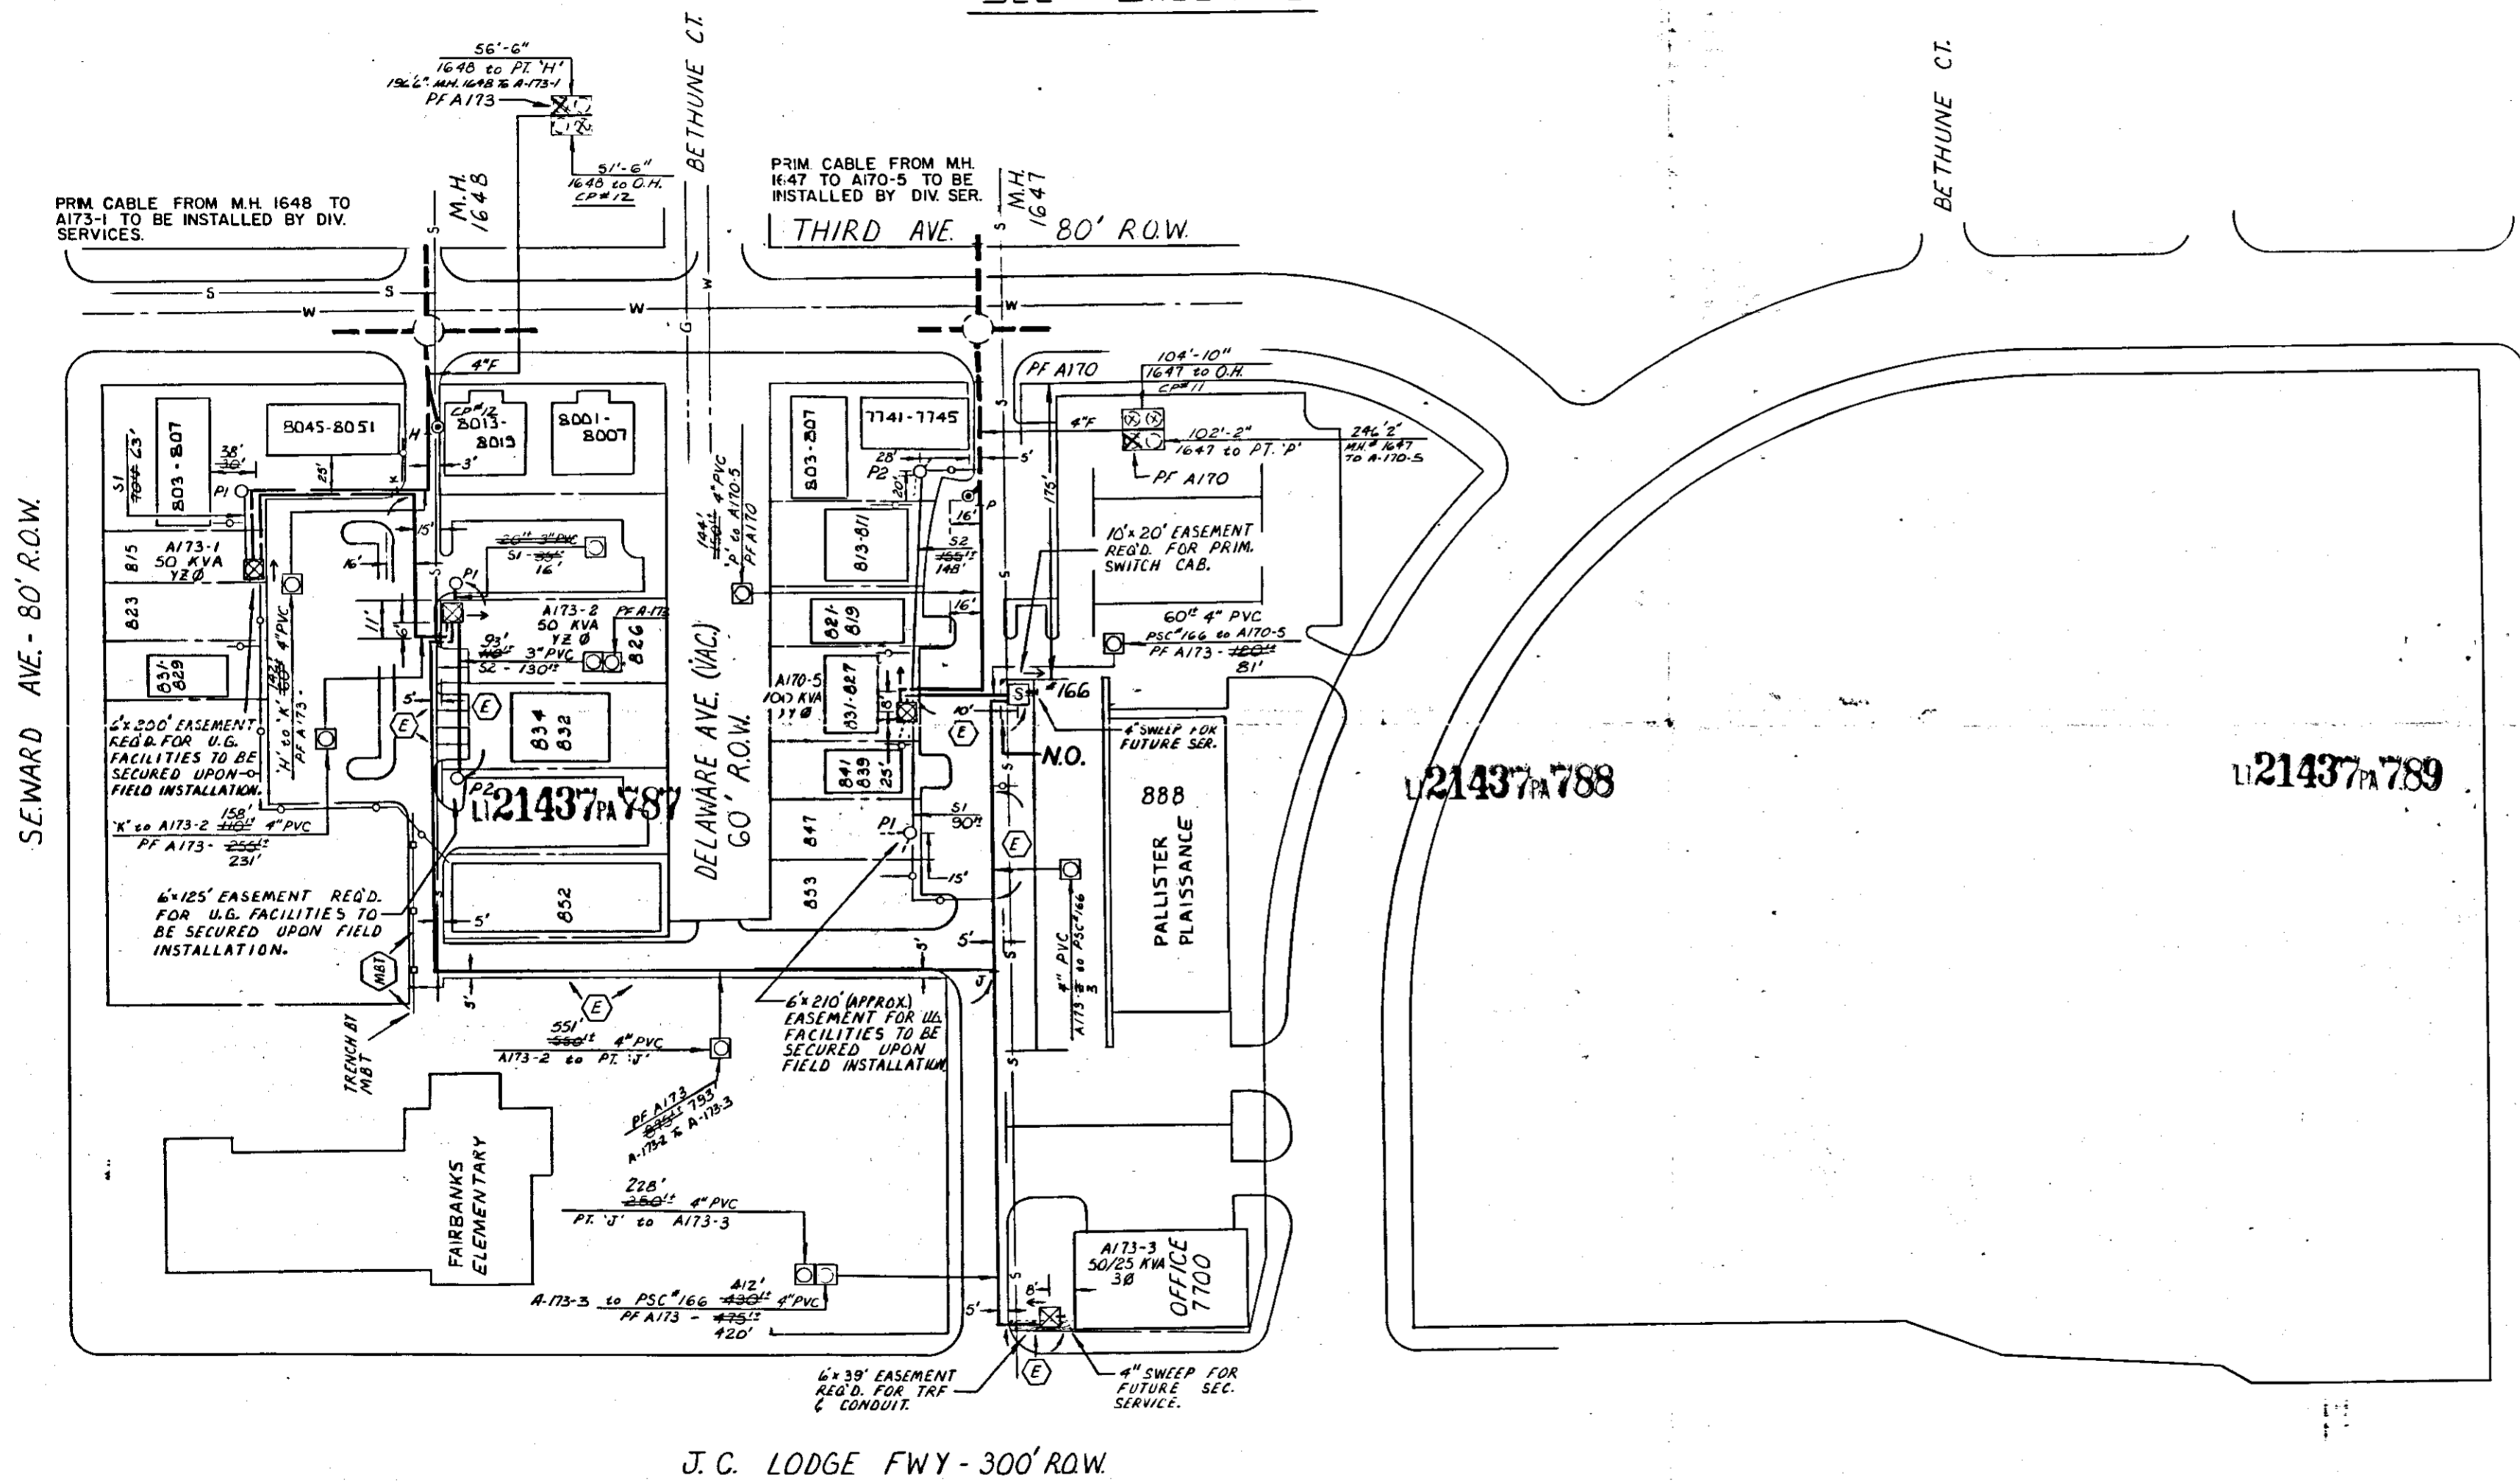

**TRANSFORMER DATA**

U.D.T. NO.	SIZE	ED. STK. NO.	CONN. NO.
A170-5	100	661-1158	#3
A173-1	50	661-1157	#2
A173-2	50	661-1157	#2
A173-3	50/25	661-0626	#13

TRANSFORMER SPECS. 1-17-222 1-17-223  
1-17-270 1-17-263  
1-2-231  
NO. OF PEDESTALS 5  
NO. OF TEMPORARY CABLE MARKERS  
TEMPORARY CABLE MARKER SPEC.  
SECONDARY CONNECTION BOX SPEC.

- CODE —**
- ⊙ TEMPORARY SECONDARY PEDESTAL/TEMPORARY CABLE MARKER
  - ⊠ DFT (HEAD FRONT TYPE)
  - ⊡ LOT (NON-SWITCHING—LIVE FRONT TYPE)
  - ⊞ LOT (SWITCHING—LIVE FRONT TYPE)
  - DIRECTION OF TRANSFORMER DOOR OPENING
  - SECONDARY PEDESTAL
  - ⊞ SECONDARY CONNECTION BOX
  - ⊞ CABLE POLE
  - ⊞ PRIMARY SWITCH CABINET
  - BURIED PRIMARY CABLE—ALL VOLTAGES
  - BURIED SECONDARY CABLE
  - BURIED SECONDARY SERVICE CABLE
  - DETROIT EDISON TRENCH ONLY
  - TELEPHONE TRENCH ONLY
  - SEWER
  - WATER
  - GAS
  - PROPOSED CONDUIT
  - SEP CONN CABINET

**CABLE SUMMARY**

ITEM # 458	170 XLPE 113.3 KV	713-3088 = 22-004
ITEM # 437	AP-300M 1-140 800 V.	713-3037 = 62-214
ITEM #	AP-220 1-141 800 V.	713-3114 =

**TRENCH SUMMARY**

JOINT USE	0
D.E. ONLY	1
TEL. ONLY	0
GAS ONLY	0
OTHERS	0
TOTAL	2-7-0-0-0-0
SITE Supt.	TOM SURPRISE PHONE NO. 871-7070

**— GENERAL NOTES —**

TRENCHING TO BE DONE BY D.E.Co. (SEE NOTE #1)

TRENCH AND CABLE LENGTHS ARE APPROXIMATE.

SEE SECTION 56 UG LINE CONSTRUCTION STANDARDS FOR TRANS. MAT. DETAILS.

SEE PAGE 32-11 (S.M.J) DETAIL "—" FOR ENTRANCE POINT DETAILS (APTS. ONLY)

SEE SECTION 43 UG LINE CONSTRUCTION STANDARDS FOR PLACEMENT OF CABLES, TRANSFORMERS AND PEDESTALS (SURTOS ONLY)

D.E. SERVICE PLANNER GEORGE FIGLOLI 237-9619  
TEL. CO. #208 HARRIS 223-8675 / FOREMAN Jim Smead 1-433-9964

GAS CO.:

OTHERS:

A.S. SEWARD, APPROX. 250' WEST OF THIRD (AS SHOWN ON THIS SKETCH).

CONTACT "MISS DIG" (800-482-7171) BEFORE DOING ANY EXCAVATION.

EASEMENTS INDICATED BY OUR CENTERLINE ARE SIX FEET IN WIDTH UNLESS OTHERWISE NOTED.

**NOTE #1**

MET WILL SUPPLY THEIR OWN TRENCH AT:

A.S. DELAWARE, BTWN PT. 'H' AND M.H. 1647.

A.S. SEWARD, BTWN PT. 'H' AND M.H. 1648

A.S. SEWARD, APPROX. 250' WEST OF THIRD (AS SHOWN ON THIS SKETCH).

**NOTE #2**

CABLE JOINT REQUIRED ON BYPASS PHASE AT ALL SINGLE PHASE TRANSFORMER LOCATIONS.

DETROIT DIVISION UNDERGROUND SYSTEMS

NOTE: AS INSTALLED DRAWING

RD. 61-20346 WD. 376-B1-1887

D.D. #24180

START 7:22 AM FINISH 10:40 AM

LABOR HERTZ ENERGY INC.

FOREMAN M. NELSEN

TECHNICIAN J. GLEESON

SUPERVISOR M. BARNHART

SERVICE PLANNER S. FISHER

PERMIT NO. CITY OF DETROIT L121437

J.C. LODGE FWY - 300' R.O.W.

D	C	B	A	REFERENCE FOR M.H. 1648	NAME	DATE	JOB TITLE
			REVISED TO SHOW AS INSTALLED.	SEE: F.B. 44 PP. 11, F.B. 879 PP. 146	CHRIS FULLER	6-16-81	NEW CENTER DEVELOPMENT AREA URD
				JOB 81-514 DRWG. 01-1-3319 US-2-9072	W.A. [Signature]	6-16-81	
				M.H. 1647 F.B. 44 P. 7 956 74			

THE DETROIT EDISON COMPANY SERVICE PLANNING	SCALE 1" = 50'	NUMBER OF SHEETS 367	WORK ORDER NUMBER B1J887
LATEST REVISION	DESCRIPTION OF REVISION	DATE	
	DC 1046 AMSTERDAM 4.8 KV		
	DC 2083 AMSTERDAM		
DEPT. ORDER NUMBER	A-24180	SHEET 3	OF 3 SHEETS

CITY OF DETROIT MICHIGAN

RETURN TO:  
DET. EDISON  
Real Estate, R/W & Claims  
8001 Haggerty Rd. South  
Belleville, Michigan 48111

RECORDED RIGHT OF WAY NO. 33855

RETURN TO: **DET. EDISON**  
Real Estate, R/W & Claims  
8001 Haggerty Rd. South  
Belleville, Michigan 48111 **Rm 34**

LI21437PA767


LI21437PA768

NORTH  
ARROW

LI21437PA769

LOCATION SKETCH  
MAP SEC. NOS.

LI21437PA770

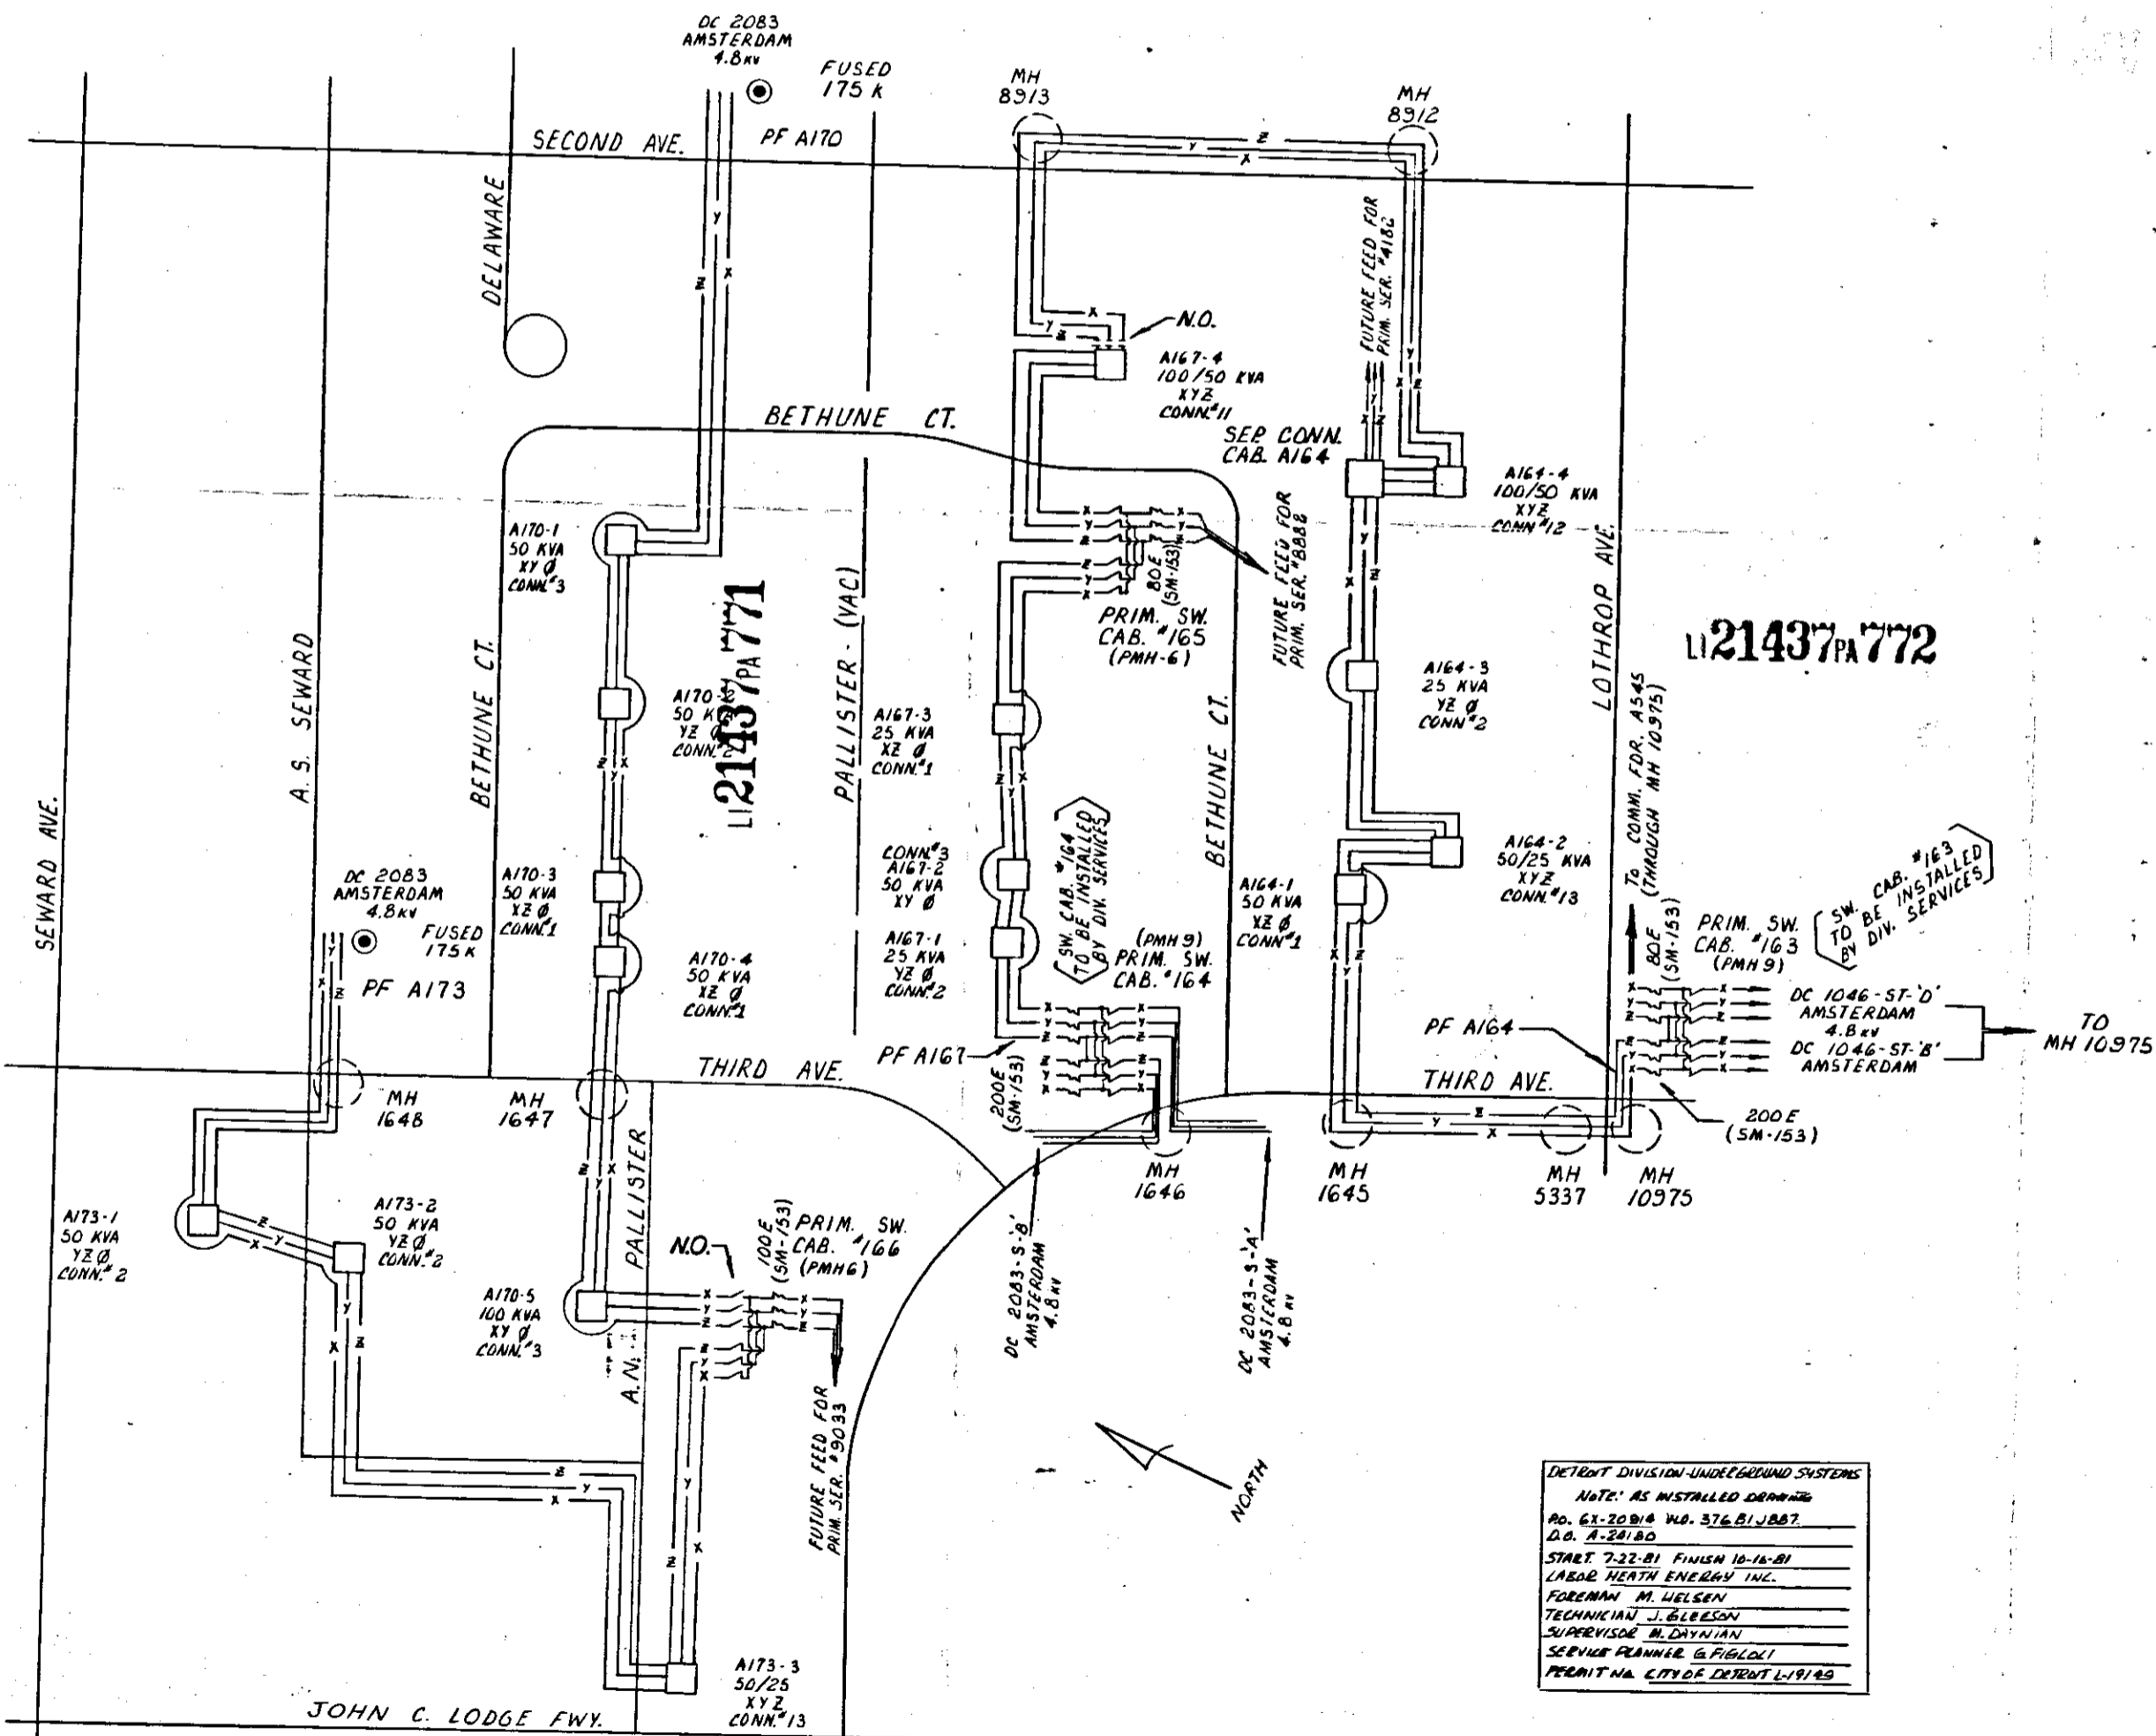

TRANSFORMER DATA

U.D.T. NO.	SIZE	ED. STK. NO.

TRANSFORMER SPECS. \_\_\_\_\_  
 PEDESTAL SPEC. \_\_\_\_\_  
 NO. OF PEDESTALS \_\_\_\_\_  
 NO. OF TEMPORARY CABLE MARKERS \_\_\_\_\_  
 TEMPORARY CABLE MARKER SPEC. \_\_\_\_\_  
 SECONDARY CONNECTION BOX SPEC. \_\_\_\_\_

- CODE —
- ⊙ TEMPORARY SECONDARY PEDESTAL/TEMPORARY CABLE MARKER
  - ⊠ DFT (DEAD FRONT TYPE)
  - ⊡ LUT (NON-SWITCHING—LIVE FRONT TYPE)
  - ⊣ LUT (SWITCHING—LIVE FRONT TYPE)
  - DIRECTION OF TRANSFORMER CONNECTION
  - ⊙ SECONDARY PEDESTAL
  - ⊠ SECONDARY CONNECTION BOX
  - ⊡ CABLE POLE
  - ⊣ PRIMARY SWITCH CABINET
  - ⊙ BURIED PRIMARY CABLE—ALL VOLTAGES
  - ⊠ BURIED SECONDARY CABLE
  - ⊡ BURIED SECONDARY SERVICE CABLE
  - ⊣ DETROIT EDISON TRENCH ONLY
  - ⊙ TELEPHONE TRENCH ONLY
  - ⊠ SEWER
  - ⊡ WATER
  - ⊣ GAS
  - ⊙ PROPOSED CONDUIT
  - ⊠ SEP CONN CABINET

CABLE SUMMARY

ITEM #	Q2A/PEC x 1 132 RV	713-3082 =
ITEM #	AP2-30M x 140 600 V.	713-557 =
ITEM #	AP2-30 x 141 600 V.	713-5814 =

TRENCH SUMMARY

JOINT USE	
D.E. ONLY	
TEL. ONLY	
GAS ONLY	
OTHERS	
TOTAL	
SITE SUPT	TOM SURPRISE
PHONE NO.	871-7070

— GENERAL NOTES —

TRENCHING TO BE DONE BY \_\_\_\_\_  
 TRENCH AND CABLE LENGTHS ARE APPROXIMATE.  
 SEE SECTION 48 (LUG LINE CONSTRUCTION STANDARDS FOR TRANS. MAT. DETAILS.  
 SEE PAGE 3-311 (LUG LINE CONSTRUCTION STANDARDS FOR PLACEMENT OF CABLES.  
 SEE SECTION 43 (LUG LINE CONSTRUCTION STANDARDS FOR PLACEMENT OF CABLES.  
 TRANSFORMERS AND PEDESTALS TO BE BURYED ONLY!  
 D.E. SERVICE PLANNER: GEORGE FILLOLI 237-9619  
 TEL. CO. BOB MARRIS 233-8675 / JOHN SURPRISE 1-453-9926  
 GAS CO. \_\_\_\_\_  
 OTHERS: \_\_\_\_\_  
 CONTACT "MISS DIG" (800-482-7171) BEFORE DOING ANY EXCAVATION.  
 EASEMENTS INDICATED BY OUR CENTERLINE ARE  
 IN WIDTH UNLESS OTHERWISE NOTED.

PERMITS REQUIRED


CITY OF DETROIT COUNTY, NOTIFICATION ONLY.  
STATE  YES  NO

D	C	B	A	REFERENCE

NAME	DATE	JOB TITLE
CHRIS FULLER	6-16-81	

NEW CENTER DEVELOPMENT  
 AREA URD  
 WAYNE CO. CITY OF DETROIT MICHIGAN

SCALE	NUMBER OF SHEETS	SHEET ORDER NUMBER
NONE		367 B1 J687
LATEST REVISION		

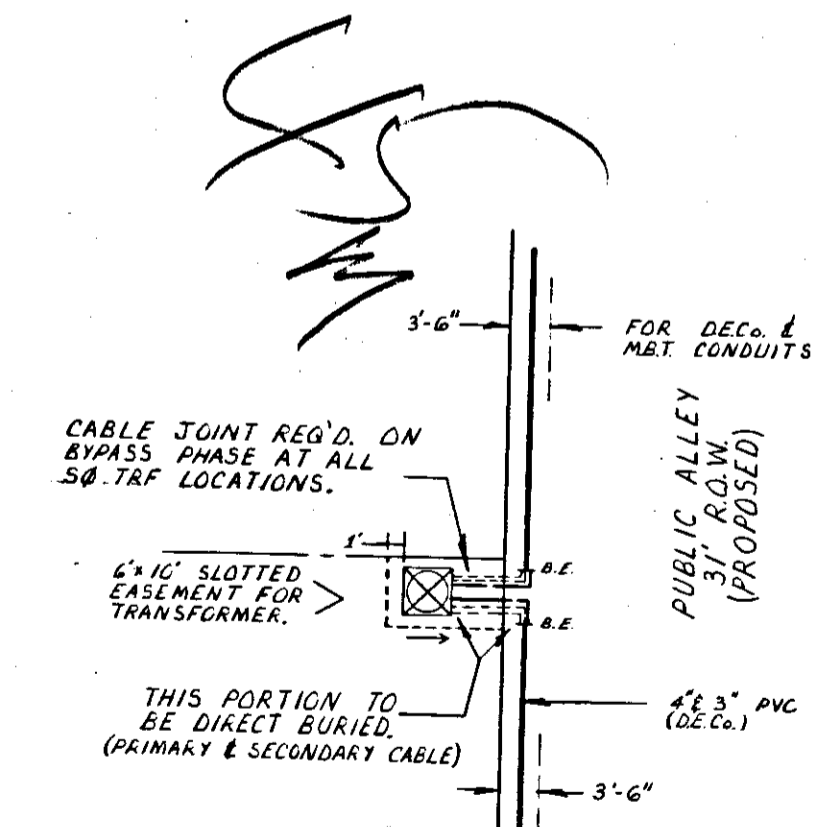

TYPICAL UNDERGROUND CONSTRUCTION PLAN

DETROIT DIVISION UNDERGROUND SYSTEMS  
 NOTE: AS INSTALLED DRAWING  
 PD. 61-20808 NO. 376 B1 J687  
 D.A. 8-28-80  
 START 7:32-81 FINISH 10-16-81  
 LARAB HEALTH ENERGY INC.  
 FOREMAN M. NELSEN  
 TECHNICIAN J. B. BROWN  
 SUPERVISOR J. B. BROWN  
 SERVICE PLANNER G. FILLOLI  
 PERMIT NO. CITY OF DETROIT L17143

RECEIVED  
 WAYNE COUNTY, MICH.  
 1982 JUL 15 AM 11 03

FOREST E. YOUNGBLOOD  
 REGISTER OF DEEDS

1-82-0525-100883


RECORDED RIGHT OF WAY NO. 33855

DET. EDISON  
RETURN TO: R/W & Claims RM134  
Real Estate, R/W & South  
8001 Haggerty Rd. South  
Belleville, Michigan 48114

DET. EDISON  
RETURN TO: R/W & Claims RM134  
Real Estate, R/W & South  
8001 Haggerty Rd. South  
Belleville, Michigan 48114

COPIES


COPIES

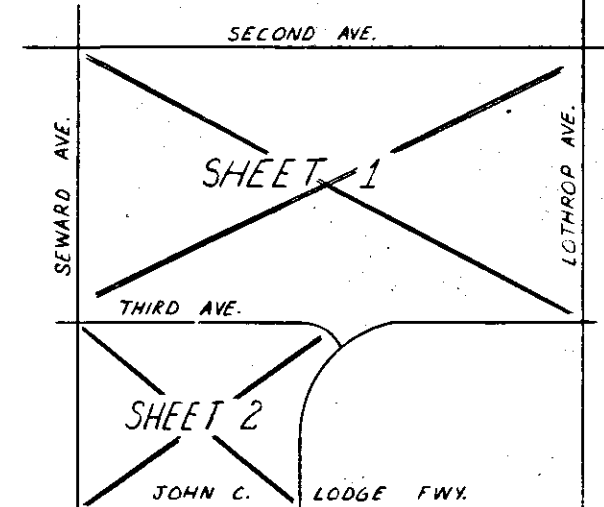

TERMINATE PER SECS:  
1-9-265-268.1,2  
1-52-326

SPECS: DET 2022 J  
LOC: AS. DELAWARE, IRE. SECOND  
QUAD: S.E.  
FUSE: 175 K  
PHASE: XYZ  
NEUTRAL HT.: 35'  
CIRCUIT: DC 2083-5  
AMSTERDAM

SPECS: DET 2022 J  
LOC: AS. SEWARD, IRE. THRU  
QUAD: N.E.  
FUSE: 175 K  
PHASE: XYZ  
NEUTRAL HT.: 35'  
CIRCUIT: DC 2083-5  
AMSTERDAM

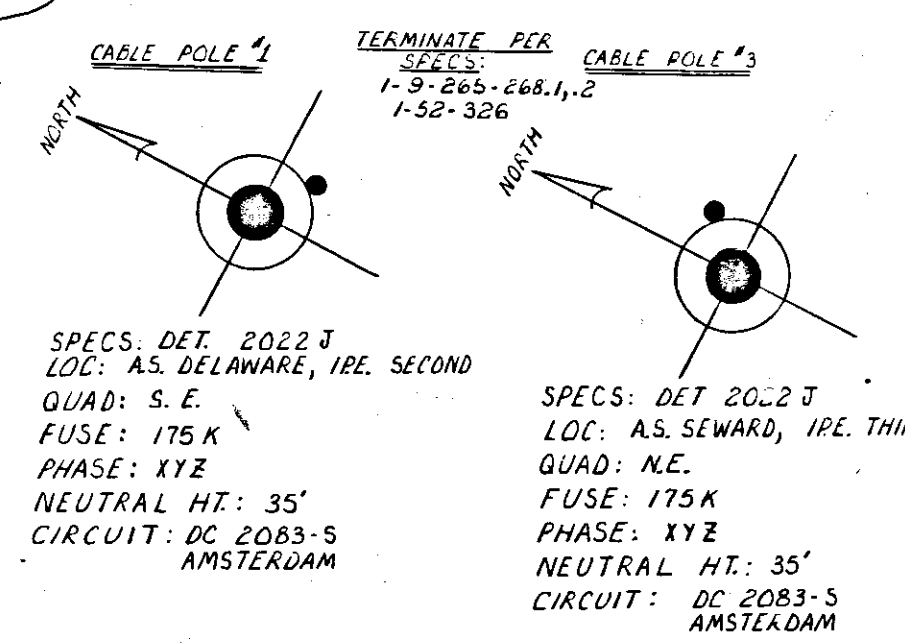

**TRANSFORMER DATA**

U.D.T. NO.	SIZE	ED. STK. NO.	CONN. NO.
A164-1	50	661-1157	1
A164-2	100/50	661-0628	4/3-12
A164-3	25	661-1156	2
A164-4	100/50	661-0628	1/2
A167-1	25	661-1156	2
A167-2	50	661-1157	2
A167-3	25	661-1156	2
A167-4	100/50	661-0628	1/1
A170-1	50	661-1157	2
A170-2	50	661-1157	2
A170-3	50	661-1157	2
A170-4	50	661-1157	1

- CODE —**
- TEMPORARY SECONDARY PEDESTAL
  - TEMPORARY CABLE MARKER
  - DFT (DEAD FRONT TYPE)
  - UDT (NON-SWITCHING—LIVE FRONT TYPE)
  - UDT (SWITCHING—LIVE FRONT TYPE)
  - DIRECTION OF TRANSFORMER DOOR OPENING
  - SECONDARY PEDESTAL
  - SECONDARY CONNECTION BOX
  - CABLE POLE
  - PRIMARY SWITCH CABINET
  - BURIED PRIMARY CABLE—ALL VOLTAGES
  - BURIED SECONDARY CABLE
  - BURIED SECONDARY SERVICE CABLE
  - DETROIT EDISON TRENCH ONLY
  - TELEPHONE TRENCH ONLY
  - SEWER
  - WATER
  - GAS
  - PROPOSED CONDUIT
  - SEP CONN CABINET

**CABLE SUMMARY**

ITEM	DESCRIPTION	QUANTITY
1	350 ALUM. 1/0 X 1/0 X 1/0	713-0884
2	170 ALUM. #1 X 3/2 K.V.	713-3064
3	APR 3000 X 140 800 V.	713-0537
4	APR 3000 X 140 800 V.	713-0537
5	200 Co. ALUM. #1 X 1/0 X 1/0	713-0537
6	200 Co. ALUM. #1 X 1/0 X 1/0	713-0537

**TRENCH SUMMARY**

ITEM	DESCRIPTION	QUANTITY
1	350 ALUM. 1/0 X 1/0 X 1/0	713-0884
2	170 ALUM. #1 X 3/2 K.V.	713-3064
3	APR 3000 X 140 800 V.	713-0537
4	APR 3000 X 140 800 V.	713-0537
5	200 Co. ALUM. #1 X 1/0 X 1/0	713-0537
6	200 Co. ALUM. #1 X 1/0 X 1/0	713-0537

**— GENERAL NOTES —**

TRENCHING TO BE DONE BY D.E.Co. (SEE NOTE #1)

TRENCH AND CABLE LENGTHS ARE APPROXIMATE.

SEE SECTION 56 UG LINE CONSTRUCTION STANDARDS FOR TRANS. MAT. DETAILS.

SEE PAGE 3-2-11 (S.I.M.) DETAIL " " FOR ENTRANCE POINT DETAILS (APTS. ONLY)

SEE SECTION 43 UG LINE CONSTRUCTION STANDARDS FOR PLACEMENT OF CABLES, TRANSFORMERS AND PEDESTALS (BUTTS ONLY)

D.E. SERVICE PLANNER: GEORGE FIDELL 237-9619

TEL. CO. 488 MARKS: 423-6078 / TELEPHONE JOHN STEWARD 1-453-2926

GAS CO.:

OTHERS:

CONTACT "MIS" DET. 800-483-7179 BEFORE DOING ANY EXCAVATION.

EASEMENTS INDICATED BY OUR CENTERLINE ARE SIX FEET IN WIDTH UNLESS OTHERWISE NOTED.

**PERMITS REQUIRED**

CITY OF DETROIT COUNTY: MOTIFICATION ONLY

STATE  YES  NO

**THE DETROIT EDISON COMPANY**  
SERVICE PLANNING

SCALE: 1" = 50'

NUMBER OF SHEETS: 3

WORK ORDER NUMBER: 367BJ887


DISTRIBUTION CIRCUIT: DC 1646 AMSTERDAM

DC 2083 AMSTERDAM 4.8 KV

DEPT. ORDER NUMBER: A-24180

WAYNE CO. CITY OF DETROIT MICHIGAN SHEET 2 OF 3

L21437PA782

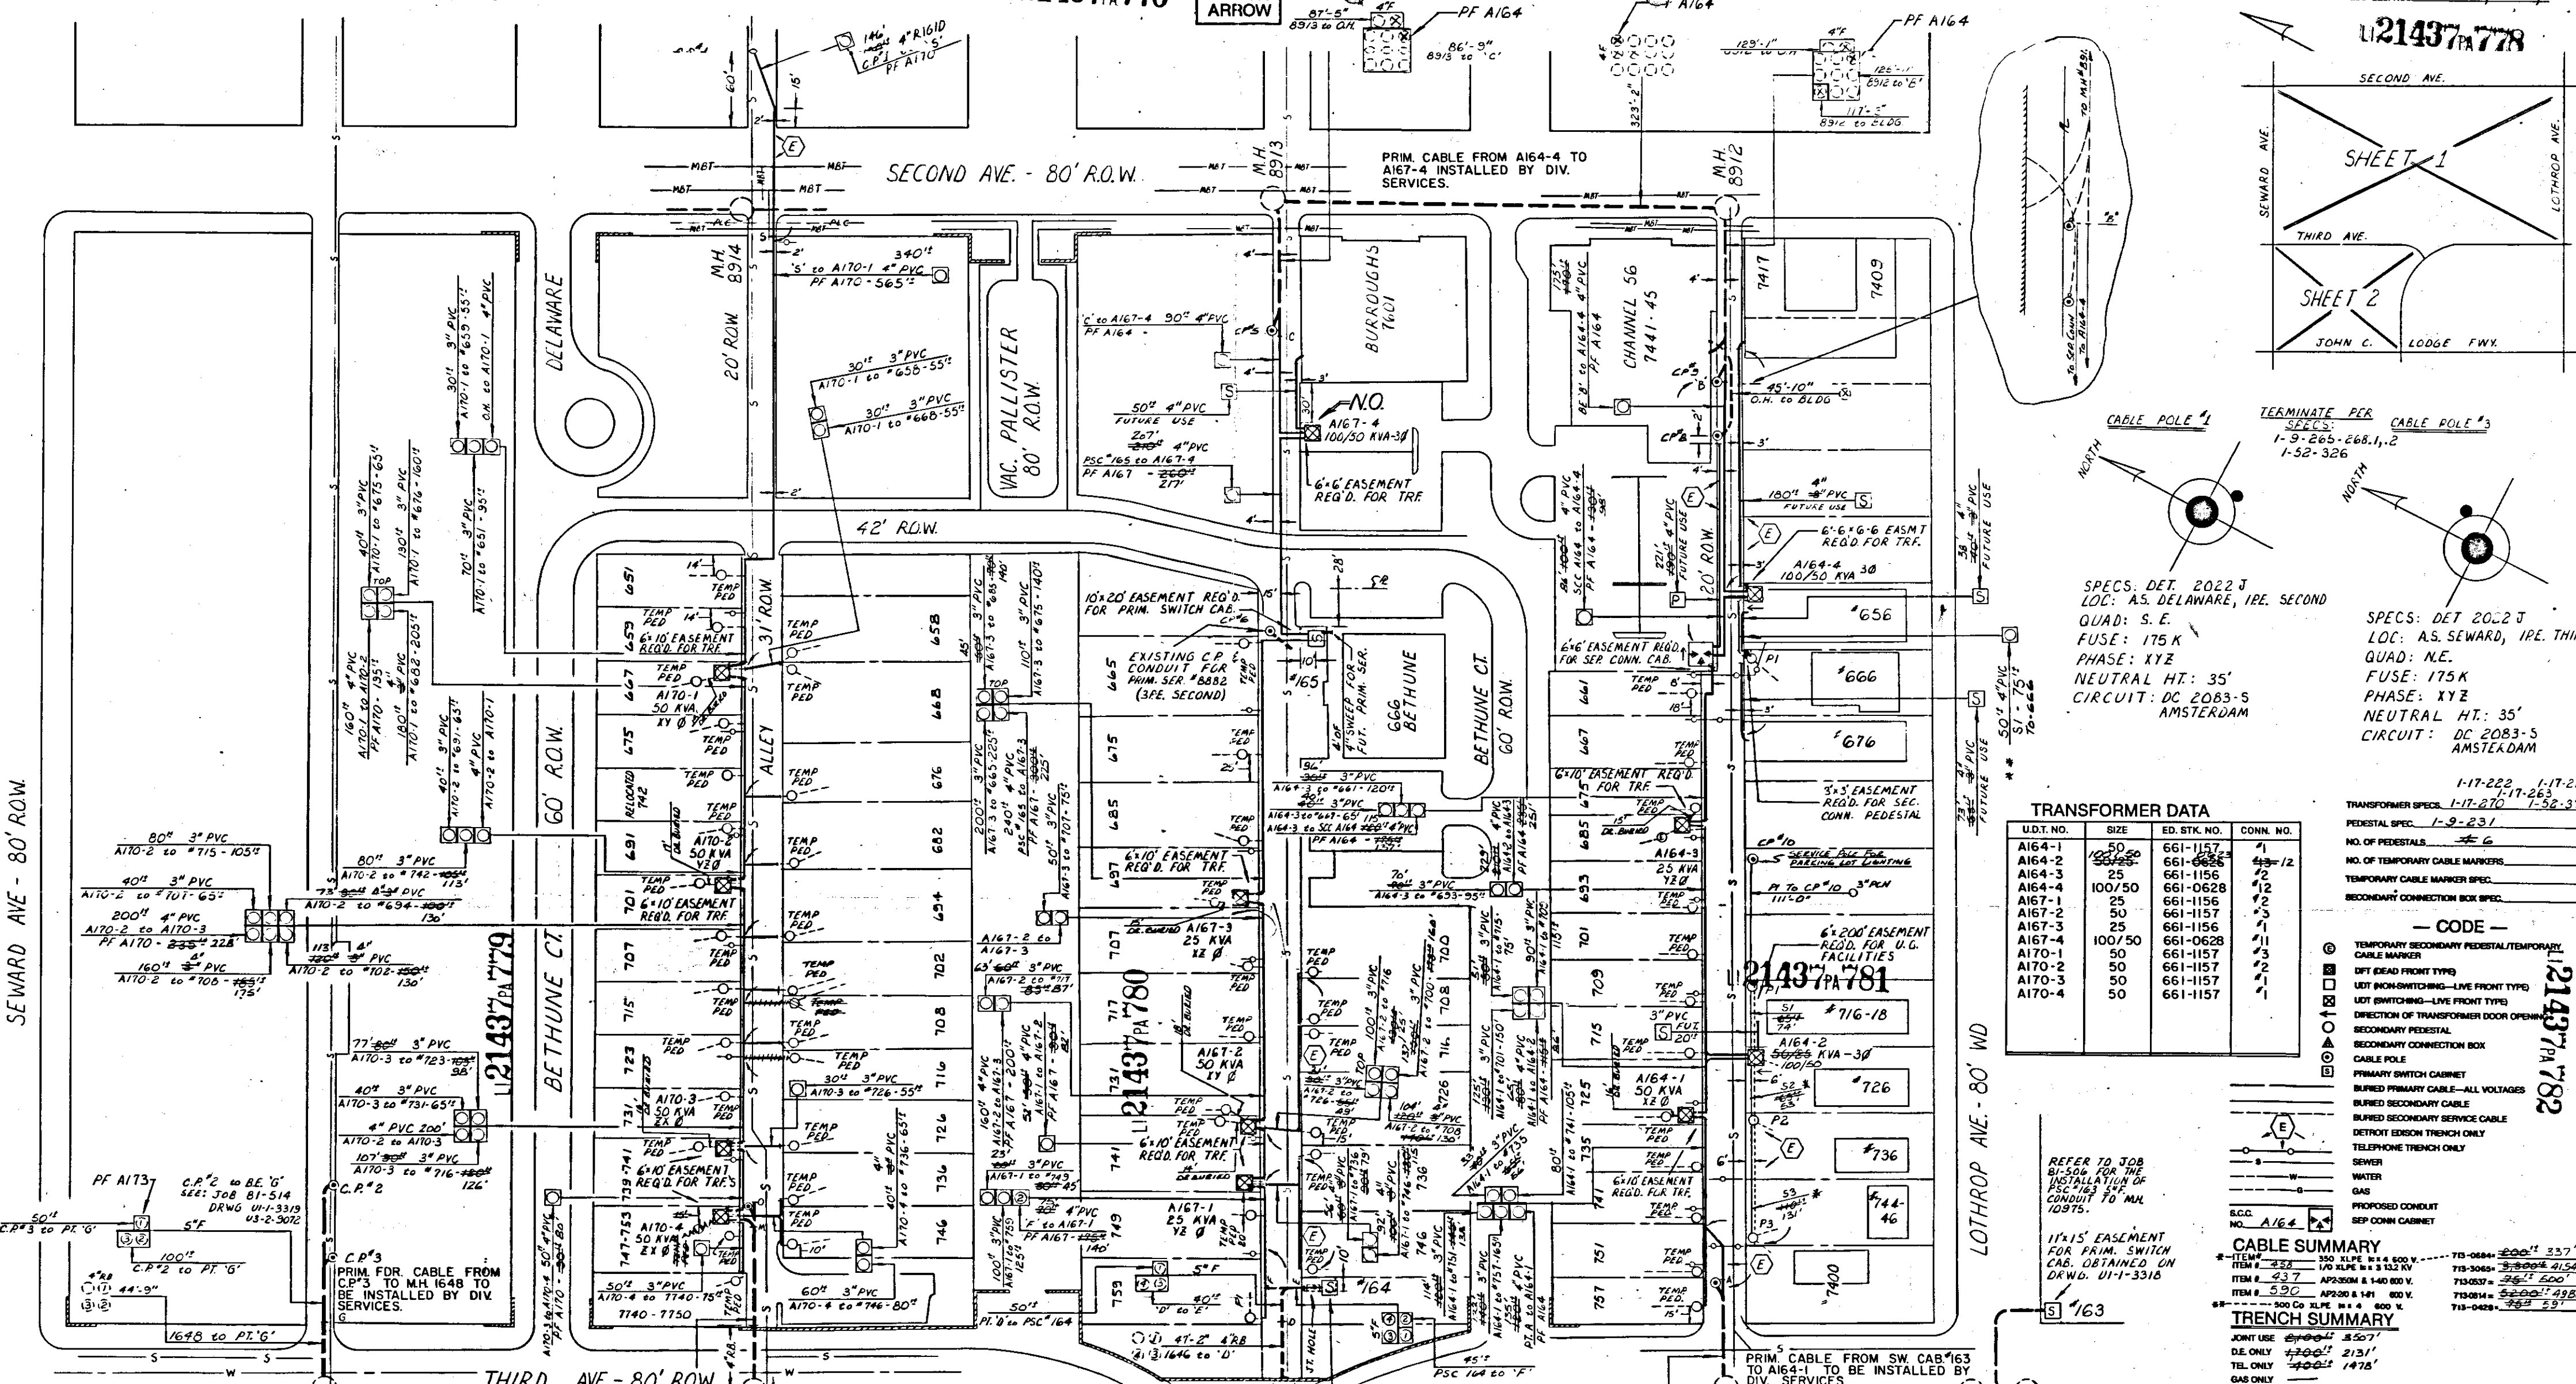

DETROIT DIVISION—UNDERGROUND SYSTEMS  
NOTE: AS INSTALLED DRAWING  
NO. 62-222-12 NO. 376-B-1082  
I.G. 2-24-82  
START: 7-22-81 FINISH: 10-16-81  
LABOR: NATHAN ENERGY, INC.  
FOREMAN: M. NELSEN  
TECHNICIAN: J. GLEASON  
SUPERVISOR: M. DALRYMPLE  
SERVICE PLANNER: G. BERGALL  
PERMIT NO. C17 & DETROIT L-1195

**REFERENCE**

NO.	DESCRIPTION
81-506	JOB 81-514
U1-1-3315	DRWG U1-1-3319
U3-2-9071	U3-2-9072

**REVISION**

NO.	DESCRIPTION	DATE
1	REVISED TO SHOW AS INSTALLED	6-16-81
2		6-16-81
3		6-16-81

**APPROVED**

DRWN BY: CHRIS FULLER  
CHKD BY: [Signature]  
APPV BY: [Signature]

NO.	REVISION	DATE
1	REVISED TO SHOW AS INSTALLED	6-16-81
2		6-16-81
3		6-16-81

NO.	REVISION	DATE
1	REVISED TO SHOW AS INSTALLED	6-16-81
2		6-16-81
3		6-16-81

RETURN TO:  
R. W. & CLAUDE  
HAGGERTY  
8001 Haggerty Rd. South  
Belleville, Michigan 48122  
8174 BELLEVILLE, MICHIGAN  
8008 BELLEVILLE, MICHIGAN

RECORDED RIGHT OF WAY NO. 33855

100-1111-10  
D

D

100-1111-10

100-1111-10

RETURN TO:  
R. W. & CLAUDE  
HAGGERTY  
8001 Haggerty Rd. South  
Belleville, Michigan 48122  
8174 BELLEVILLE, MICHIGAN  
8008 BELLEVILLE, MICHIGAN