



*-*Detroit aison

## **Right of Way Agreement**

81

20434

LIBER 7975 PAGE 782

extender 4

For valuable consideration, the receipt of which is hereby acknowledged, the undersigned hereby grant and convey to THE DETROIT EDISON COMPANY, a corporation organized and existing concurrently under the laws of the States of Michigan and New York, of 2000 Second Avenue, Detroit, Michigan 48226 and the MICHIGAN BELL TELEPHONE COMPANY, a Michigan corporation, of 444 Michigan Avenue, Detroit, Michigan 48226 hereinafter referred to as "UTILITIES", the easement and right to erect, lay, maintain, reconstruct and replace underground facilities consisting of wires, cables, conduits, fixtures and appurtenances including the necessary above ground equipment, connections, poles and accessories which may from time to time be required in, under, upon, over and across the land located in the \_\_ <u>City</u>\_ of Farmington Hills, Oakland County, Michigan, and more particularly described on the attached Appendix "A", with the full right to the UTILITIES of ingress and egress upon said land for the purposes of this grant, and the further right to trim, cut down or otherwise control brush and trees within the easements herein described.

Said easements shall be <u>Ten (10)</u> feet in width unless otherwise indicated and their route is "The exact location of said easements will be as shown on a drawing described as follows: to be recorded within 90 days after construction."

In order to provide for the proper maintenance and protection of UTILITIES, the undersigned covenant and agree that:

- 1. The easements will be graded to within four (4) inches of final grade before the UTILITIES lines are installed and this ground elevation must be maintained after installation of utilities to avoid the pooling of water in, on or around above ground UTILITIES' equipment.
- 2. No buildings or structures other than UTILITIES equipment are to be placed within the easements herein granted. No excavation is to be permitted within said easement without approval of UTILITIES.
- 3. If the lines or facilities of UTILITIES are damaged by the acts of Owners, their agents, employes or contractors, repairs shall be made by the Utility company so damaged at the cost and expense of Owners. Owners are defined as those persons owning the land at the time the damage occurred.
- 4. No shrubs or foliage shall be planted or grown within five (5) feet of the front door of ransformers or switching cabinet enclosures. UTILITIES shall not be responsible to Owners for damage to or removal of rees or plant life planted in front of said door or within the easement causing an interference with UTILITES maintenance of their equipment.

THIS GRANT is declared to be binding upon the heirs, successors, lessees Eenses and assigns of the parties hereto.


IN WITNESS WHEREOF, the undersigned have hereunto set their hand and seal on this date.

VILLA NOVA ENTERPRISES, Joint Venture A Michigan Co-Partnership, date 7-31-80 Witnesses: Certificate 80-5110,Oakland County Records arrollton Arms Partner Genesio Masciulli, Co-Partner Prepared By: Omer V. Racine The Detroit Edison Company 30400 Telegraph Road ADDRESS: 31725 W. Nine Mile Ro Birmingham, Michigan 48010 Farmington Hills, Michigan 48024

This easement is re-recorded for purposes of showing the planned "as installed" centerlines of easements granted as shown on drawing attached hereto.

Return over

RECORDED OF WAY

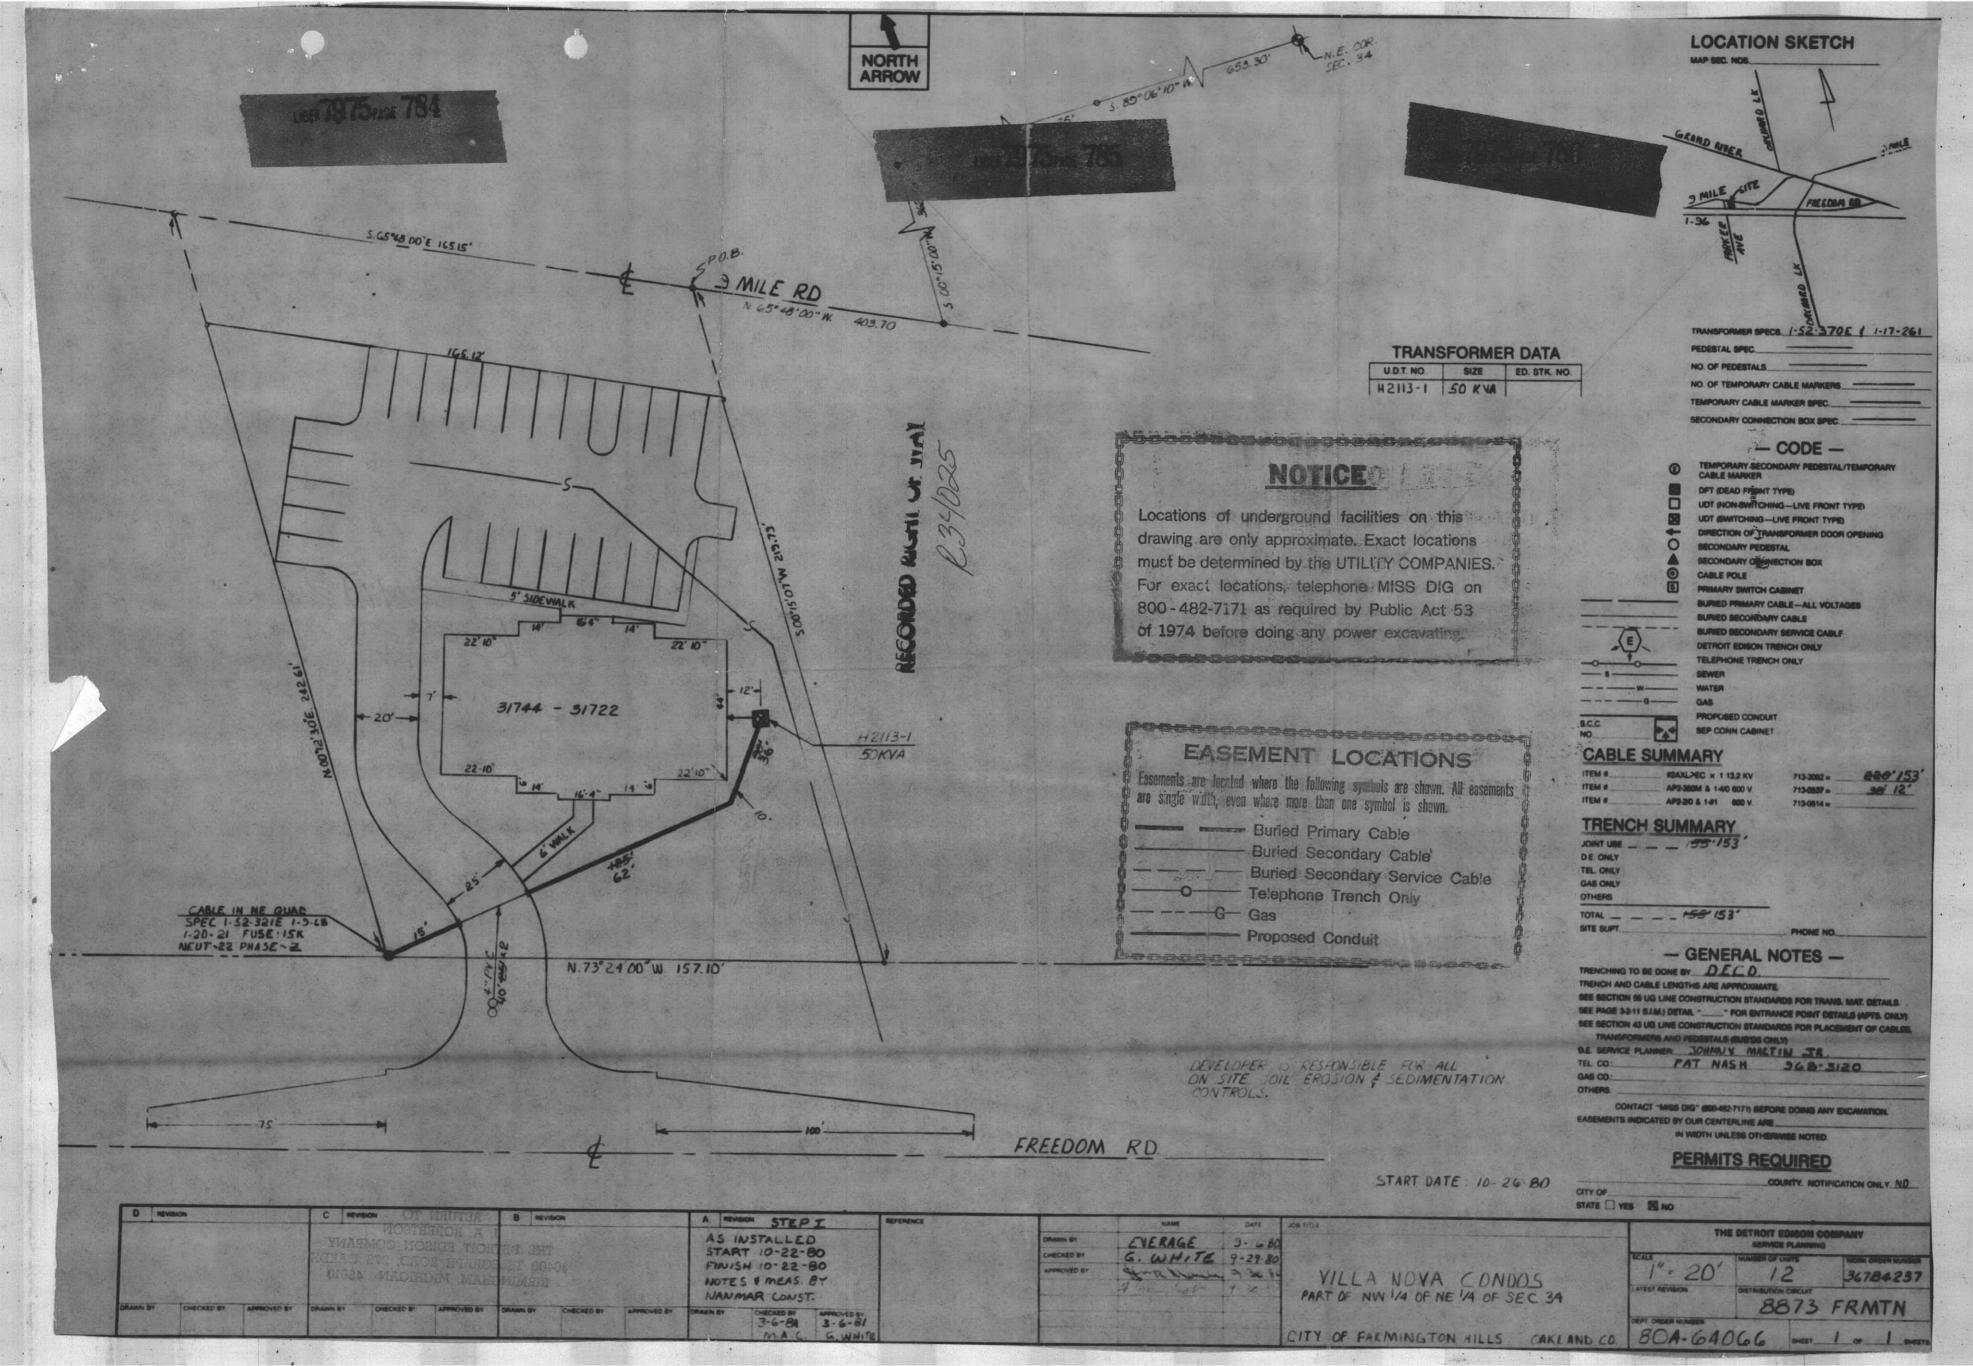

THE DETROIT FOILD, 272 OAKDH 30400 TELEGRAPH ROLD, 272 OAKDH BIRMINGHAM, MICHIGAN 48010

SCOPE

RECURDED RIGHT OF WAY NO.