

RECEIVED
MICHIGAN PUBLIC SERVICE
COMMISSION
DEC 29 1955
SECRETARY'S OFFICE

THE DETROIT EDISON COMPANY

2000 SECOND AVENUE
DETROIT 26, MICHIGAN

December 28, 1955

Mr. Tolson	_____
Mr. Clegg	_____
Mr. Glavin	_____
Mr. Ladd	_____
Mr. Nichols	_____
Mr. Rosen	_____
Mr. Tracy	_____
Mr. Harbo	_____
Mr. Mohr	_____
Mr. Winterrowd	_____
Tele. Room	_____
Mr. Holloman	_____
Miss Gandy	_____

DEC 29 1955

Michigan Public Service Commission
Lansing 13, Michigan

Gentlemen:

The Detroit Edison Company, Detroit, Michigan, hereby makes application for authority to string the following wires over the tracks of the Grand Trunk Western R.R. approximately 1 1/4 miles east of the Village of Oxford southwest 1/4 of section 24, Oxford Twp., Oakland Co., T-5N, R-10E.

(Span B-D) 3#0 TBWP 4800 volt wires and one #4 guy wire over the tracks of the G.T.W.R.R. located in private property at a point approximately 900' north of Lakeville Rd. and 8370' east of Oxford Rd.

Note: There is to be no change in the number or size of the crossing conductor. Permit requested due to the installation of a siding track in this span.

The proposed wire crossing will be constructed in accordance with specifications of the Michigan Public Service Commission and the construction standards of The Detroit Edison Company, approved by the Michigan Public Service Commission on July 19, 1939, File ED 2-9.01.

- Enclosed is a waiver of hearing granted by the Railroad Company.
- Waiver of hearing by the Railroad Company is covered by blanket waiver.
- This application covers reconstruction of existing crossing and will cancel and supersede wire crossing permit No. _____ dated _____
- This is a new crossing.

Reference number of construction drawing is RX-696A

G. T. W. RR waiver of hearing
File: 4730-6-96
dated 12-20-55, attached.

Yours very truly,
L. G. Hedden
~~Director of Public Utilities~~
~~Supervisor of Rights of Way~~
L. G. Hedden
Supervisor of Rights of Way

Permit No. ED 2-8-3832
Date December 30, 1955
By J. M. Hoppe

Acting Director of Public Utilities

✓ Check in square indicates statement applicable.

1956 JAN 3 AM 9 02
455-DEC 3
REAL ESTATE AND RIGHTS-OF-WAY DEPT

RECORDED RIGHT OF WAY NO. 34636-1133

THE DETROIT EDISON COMPANY

2000 SECOND AVENUE
DETROIT 26, MICHIGAN

April 11, 1956

RECEIVED
MICHIGAN PUBLIC SERVICE
COMMISSION

APR 12 1956

SECRETARY'S OFFICE

APR 12 1956
G.S. _____
Adm. _____
Rec'd S. _____
File _____

Permit No. ED2-8-3831

Michigan Public Service Commission
Lansing 13, Michigan

Gentlemen:

I, Lyman G. Hedden, Supervisor, Rights-of-Way Procurement
of The Detroit Edison Company, Detroit, Michigan, hereby certify that the
wire crossing, covered by Wire Crossing Permit No. ED2-8-3831
issued 12-29-55, has been constructed in accordance with
specifications of the Michigan Public Service Commission and construction
standards of The Detroit Edison Company, approved by Michigan Public Service
Commission on July 19, 1939, file ED 2-9.01, and that this crossing will be
maintained as provided in such specifications and construction standards.

Yours very truly,

Lyman G. Hedden
Supervisor of Rights of Way

RX No. 696A
Location Oxford Township
Village of Oxford,
Oakland County
Railroad Grand Trunk Western
Railroad

Subscribed and sworn to before me this
11th day of April, 1956.
Ivan W. Kumble
Notary Public, Wayne
County, Michigan.
My Commission expires April 16, 1957


Span D-E - In p.p. at a point 800'
N of Lakeville Rd. & 8370'
E of Oxford Rd.

1956 APR 13 AM 9 42
REAL ESTATE AND
RIGHTS-OF-WAY DEPT

RECORDED RIGHT OF WAY NO. 34636 p133

PROPOSED LINE CROSSING OVER GRAND TRUNK WESTERN R.R. EXISTING PERMIT NUMBER U-4232
 IN PRIV. PROPERTY 8370'E. OF CEDAR RD. 800' N. OF LAKEVILLE RD. 1 3/4 MILES E. OF VILLAGE OF OXFORD
 SECTION 24 SW 1/4 TOWNSHIP OXFORD T. 5N R. 10E COUNTY CARLAND

NOTES		CONDUCTORS				POLES		
MATERIALS SHALL BE AS NOTED IN THE DETROIT EDISON COMPANY'S STANDARD SPECIFICATIONS FOR OVERHEAD LINE CONSTRUCTION AT RAILROAD CROSSINGS DATED MARCH 1947.								
ACTUAL FIELD DIMENSIONS MAY VARY SOMEWHAT FROM THOSE SHOWN BUT THE REQUIREMENTS OF ORDER NO. 1679 OF MICHIGAN PUBLIC SERVICE COMMISSION, AS REVISED JAN. 1, 1944, WILL BE COMPLIED WITH.								
MINIMUM CLEARANCES								
NEAREST POLE TO RAIL	SIDING	7 FT.						
	MAIN LINE	12 FT.						
WIRES OVER TRACKS	0-800 VOLTS	27 FT.						
	800-7800 VOLTS	28 FT.						
	24000 VOLTS	30 FT.						
WIRES OVER R.R. SIGNAL	0-800 VOLTS	2 FT.						
	800-7800 VOLTS	4 FT.						
	24000 VOLTS	6 FT.						
DRAWN BY <u>F. BOND</u> ENGINEERING DIVISION		DATE <u>11-23-53</u>						
ESTIMATOR <u>P. HENELSTER</u> OVERHEAD LINES DEPT. <u>RODAS & S. GENT.</u>								

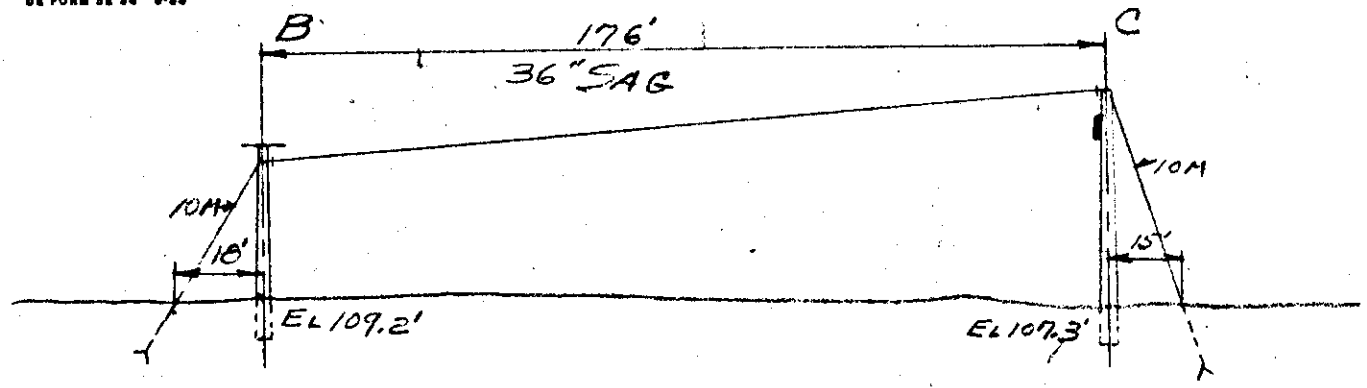



ELEVATION LOOK NORTH

EXISTING CROSSING OF
 3# 0-4800 Volt WIRES &
 1-6M GUY WIRES


EXISTING CROSSING OF
 3# 0-4800 VOLT WIRES

NOTE: THERE IS TO BE NO CHANGE IN THE NUMBER OR SIZE OF THE CROSSING CONDUCTORS, HOWEVER A TRACK HAS BEEN LAID IN SPAN B-D & MORE TRACKS IN SPAN D-E. THE CONFIGURATION OF POLE E IS ALSO TO BE CHANGED.


RECORDED RIGHT OF WAY
 24636 p132

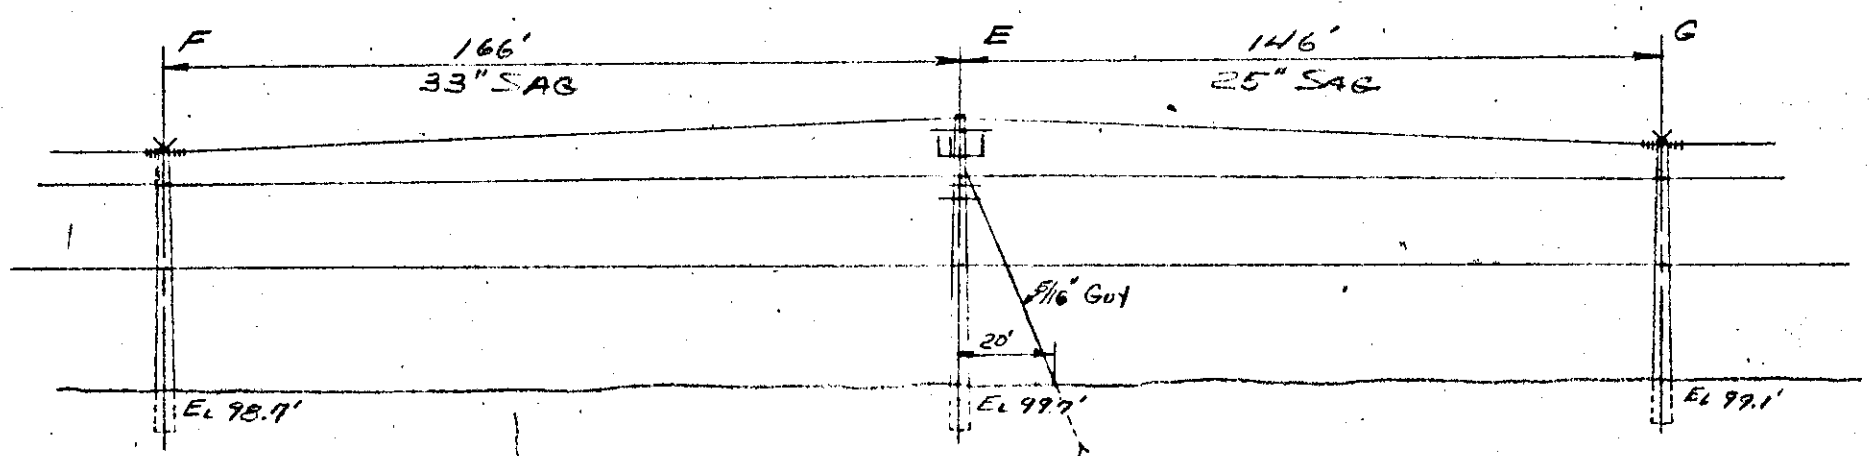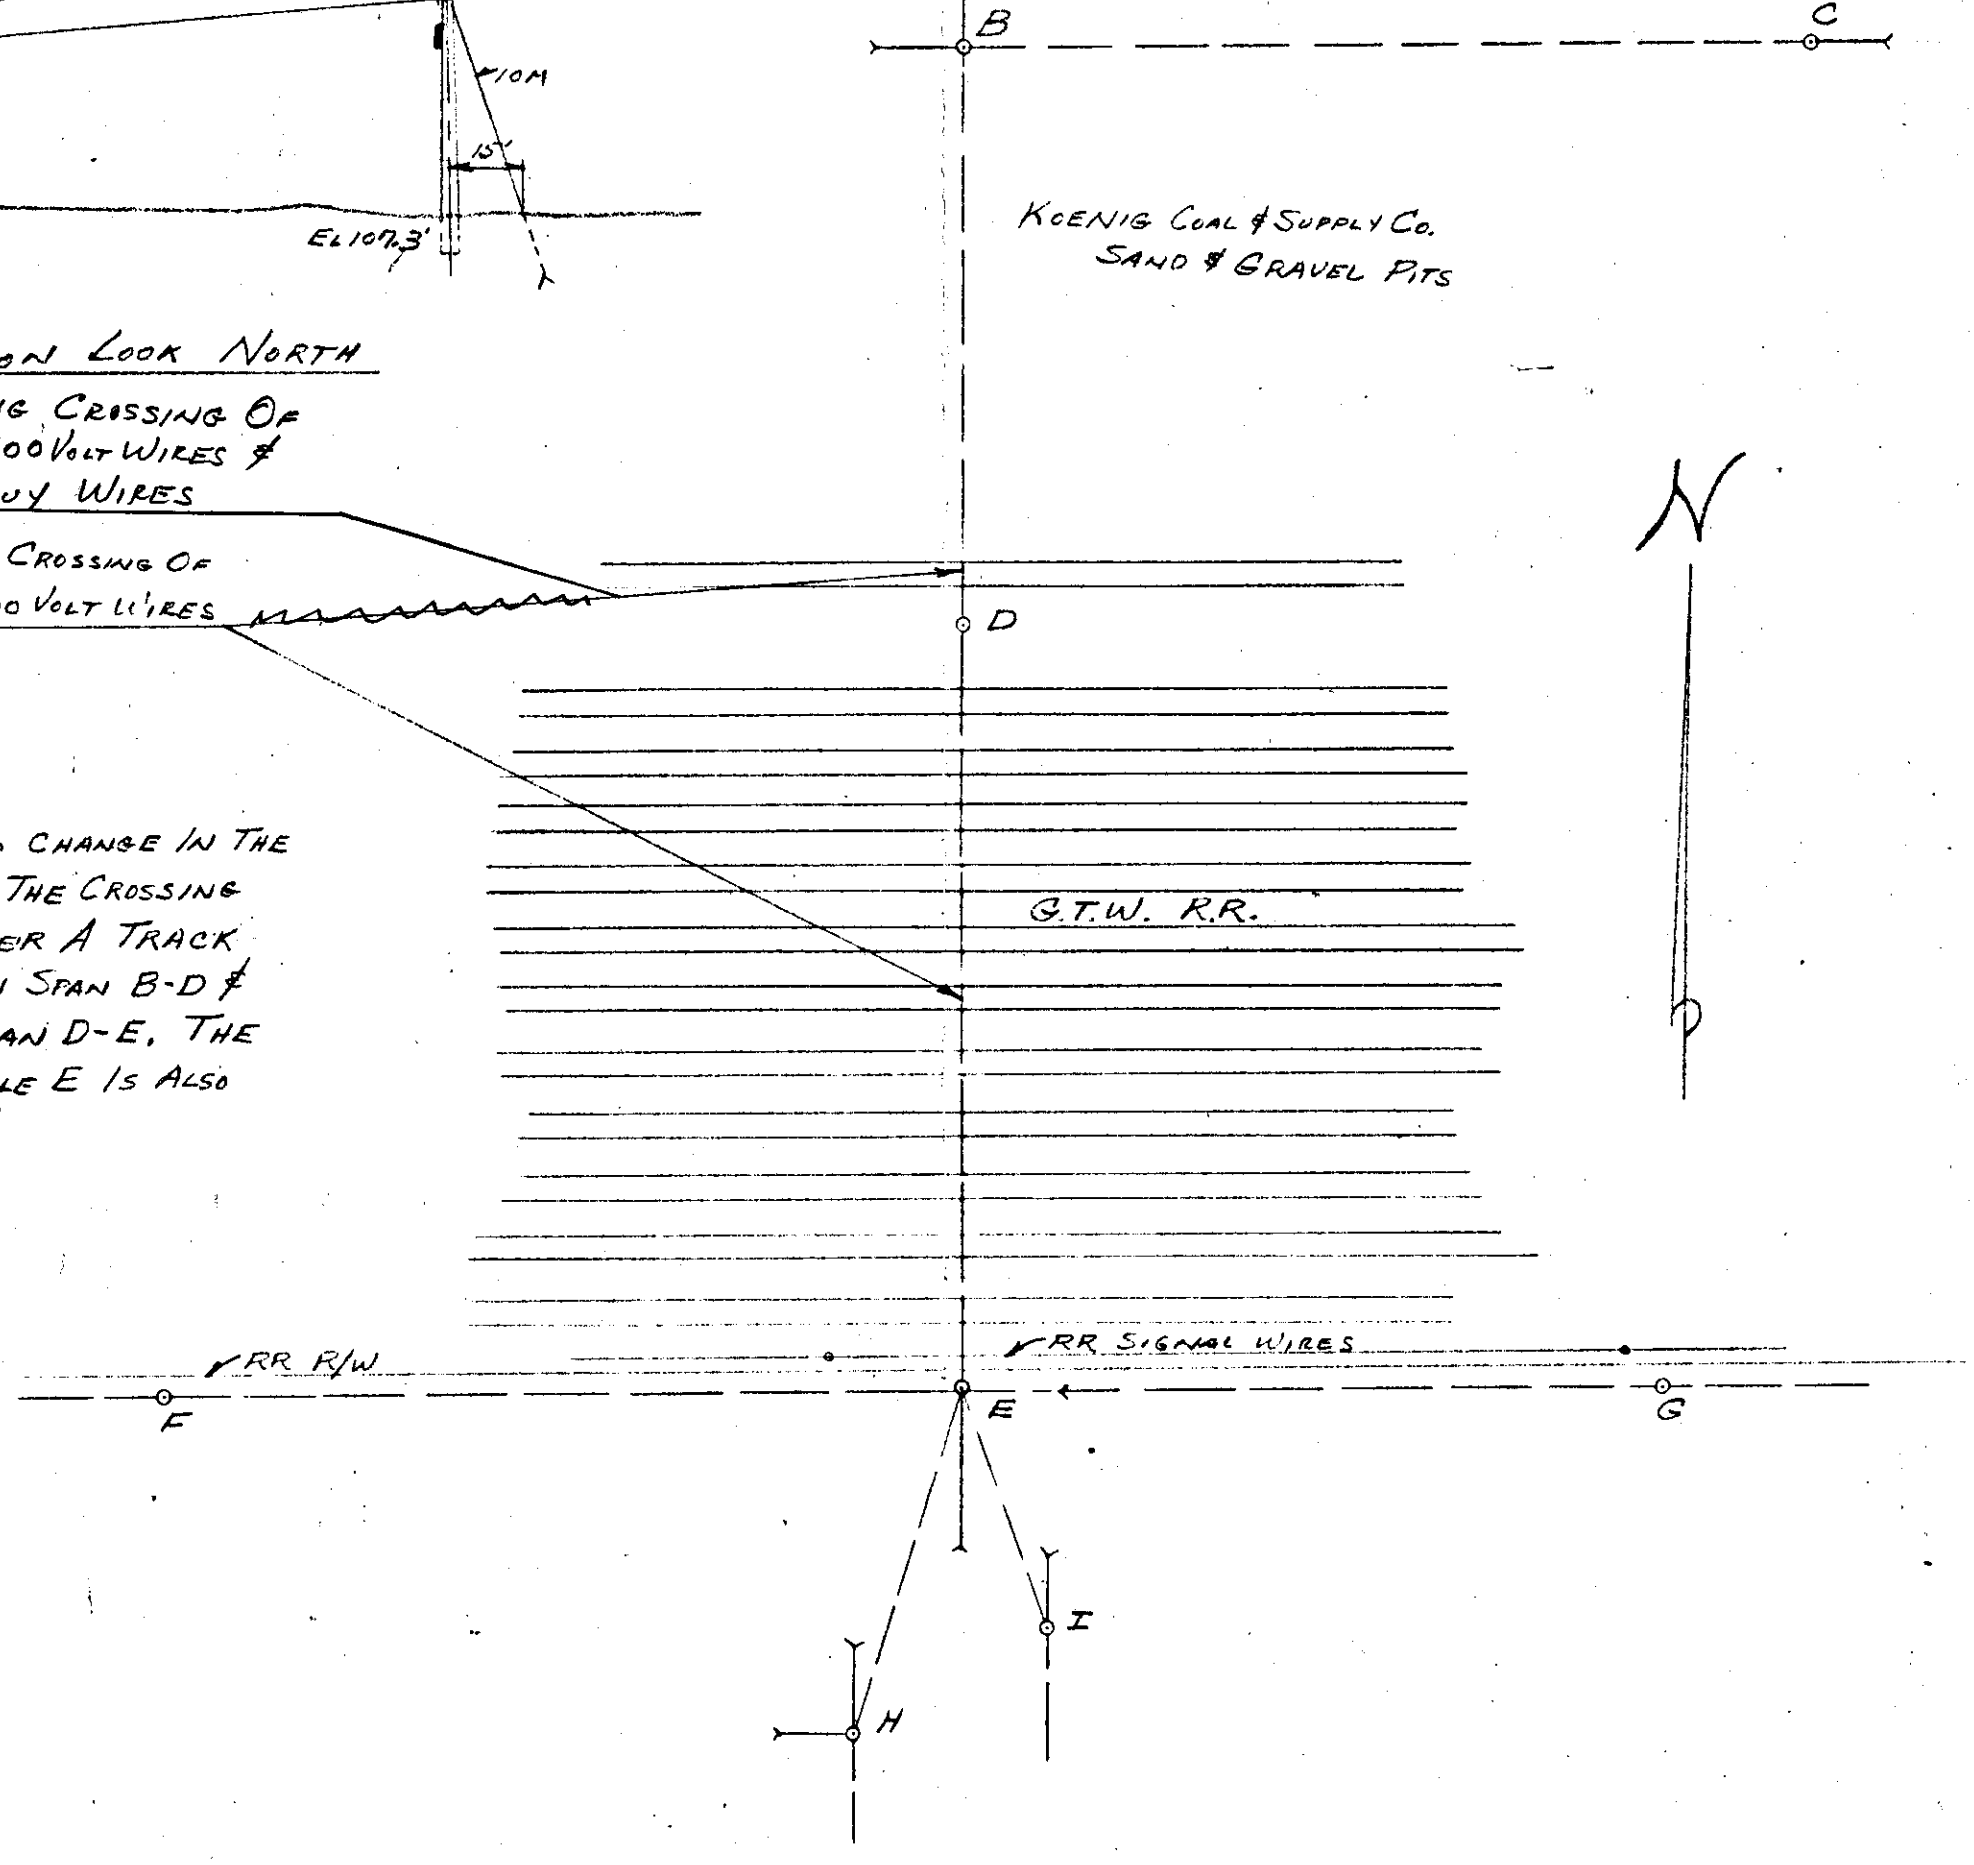



ELEVATION LOOK NORTH

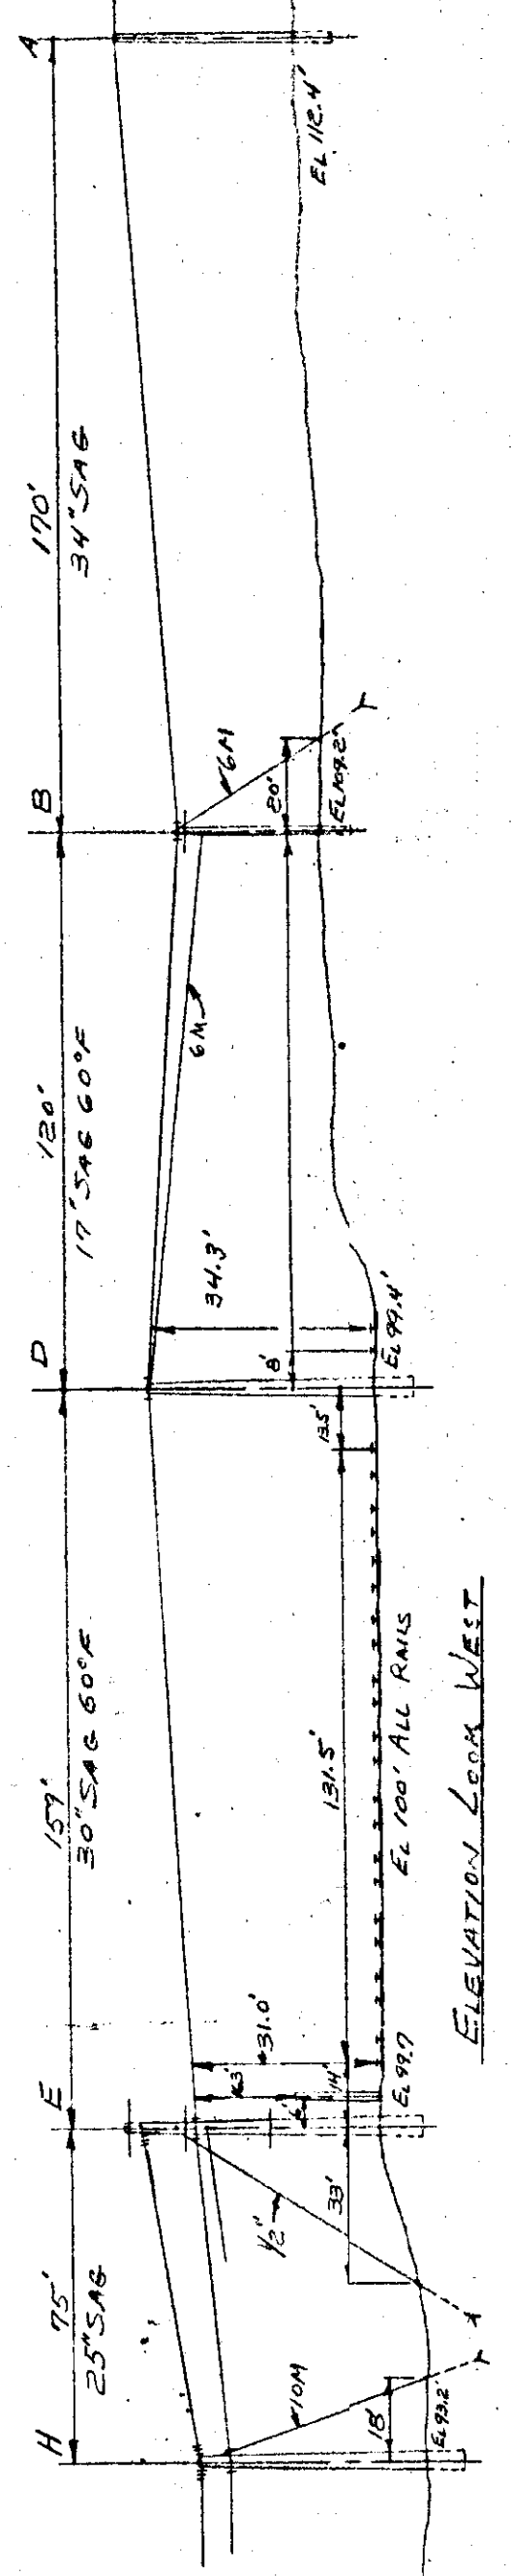

ELEVATION LOOK WEST

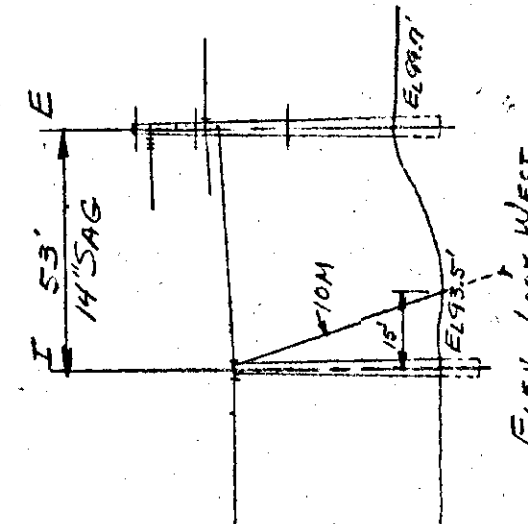

ELEVATION LOOK WEST

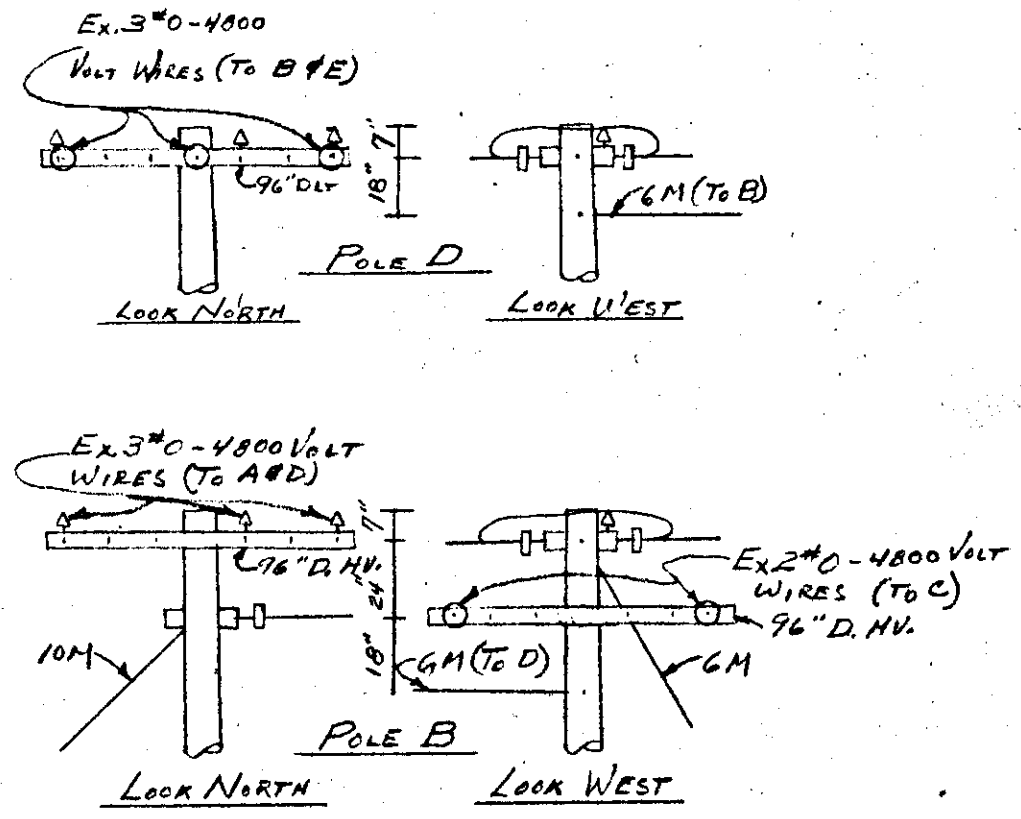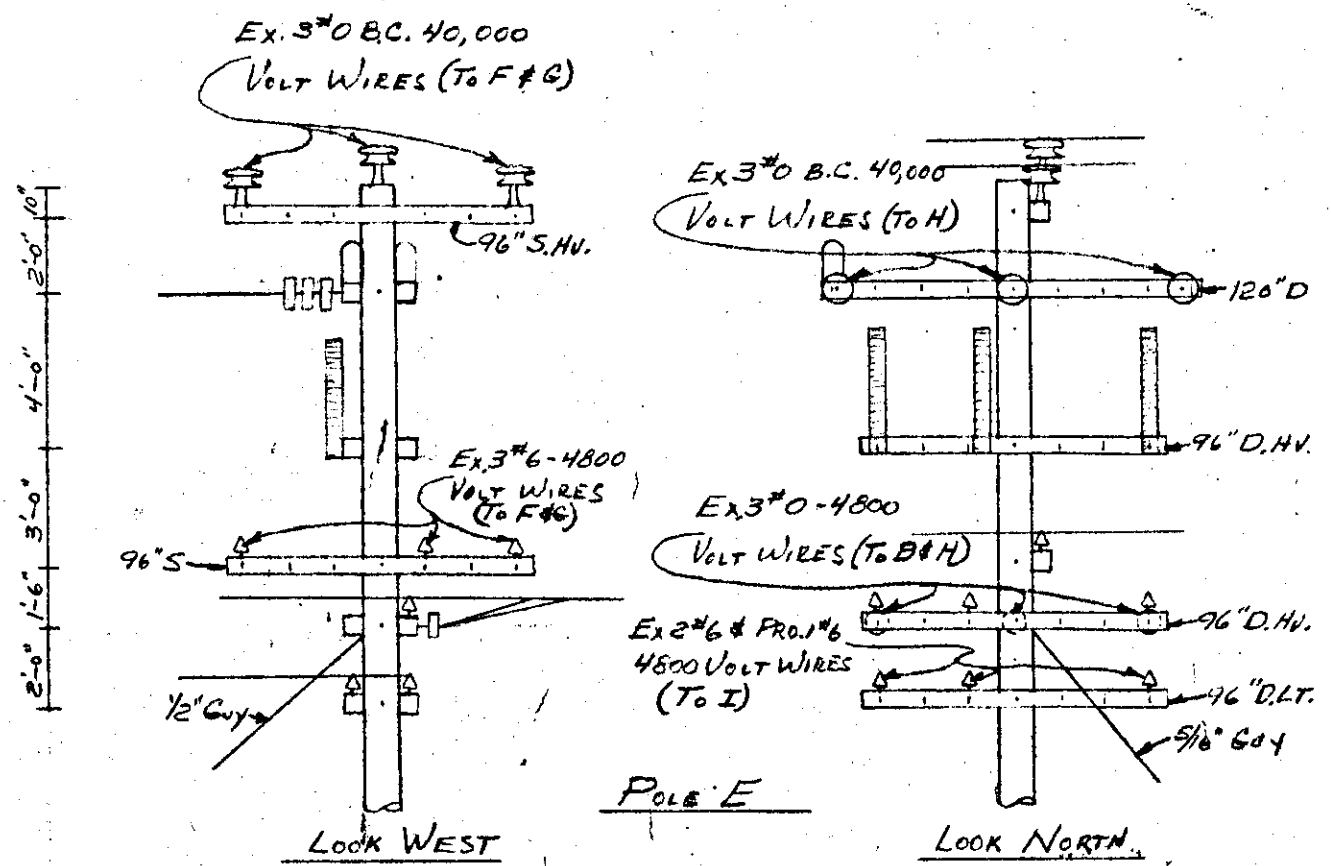

RECORDED RIGHT OF WAY NO. 34636
P133

B4436 P133

Permitt 1928 2

RECEIVED
PUBLIC SERVICE
COMMISSION
DEC 29 1955
SECRETARY'S OFFICE

THE DETROIT EDISON COMPANY

2000 SECOND AVENUE
DETROIT 26, MICHIGAN

December 28, 1955

RECEIVED
TO: _____
Elec. _____
Gen. _____
Adm. _____
DEC 29 1955
Roads _____
File _____

Michigan Public Service Commission
Lansing 13, Michigan

Gentlemen:

The Detroit Edison Company, Detroit, Michigan, hereby makes application for authority to string the following wires over the tracks of the Grand Trunk Western R.R. approximately 1 1/4 miles east of the Village of Oxford southwest 1/4 of section 24, Oxford Twp., Oakland Co., T-5N, R-10E.

(Span D-E) 3#0 TBWP 4800 volt wires over the tracks of the G.T.W.R.R. located in private property at a point 800' north of Lakeville Rd. and 8370' east of Oxford Rd.

Note: There is to be no change in the number or size of the crossing conductors, however, the configuration of pole "E" is to be changed.

The proposed wire crossing will be constructed in accordance with specifications of the Michigan Public Service Commission and the construction standards of The Detroit Edison Company, approved by the Michigan Public Service Commission on July 19, 1939, File ED 2-9.01.

- Enclosed is a waiver of hearing granted by the Railroad Company.
- Waiver of hearing by the Railroad Company is covered by blanket waiver.
- This application covers reconstruction of existing crossing and will cancel and supersede wire crossing permit No. U-4232 dated 12-19-27
- This is a new crossing.

Reference number of construction drawing is RX-696A

G. T. W. RR waiver of hearing
File: 4730-6-96
dated 12-20-55, attached.

Permit No. ED2-8-3831

Date December 29, 1955

By F. M. Hoppe
Acting Director of Public Utilities.

Yours very truly,

L. G. Hedden
~~XXXXXXXXXX~~
~~Right of Way Agent~~

L. G. Hedden
Supervisor of Rights of Way

1956 JAN 3 AM 9 02
1955 DEC 30
REAL ESTATE AND RIGHTS-OF-WAY DEPT.

RECORDED RIGHT OF WAY TA 344236 p133

✓ Check in square indicates statement applicable.