

THE DETROIT EDISON COMPANY

2000 SECOND AVENUE
DETROIT 26, MICHIGAN

December 27, 1956

RECEIVED
MICHIGAN PUBLIC SERVICE
COMMISSION
DEC 31 1956
DEPARTMENT ACCOUNTING

PUBLIC UTILITIES
Gas _____
Adm. _____
DEC 31 1956
R and S _____
File _____

Permit No. ED-2-3979

Michigan Public Service Commission
Lansing 13, Michigan

Gentlemen:

I, Ivan Gamble, Supervisor of Rights of Way
of The Detroit Edison Company, Detroit, Michigan, hereby certify that the
wire crossing, covered by Wire Crossing Permit No. ED-2-3979,
issued June 11, 1956, has been constructed in accordance with
specifications of the Michigan Public Service Commission and construction
standards of The Detroit Edison Company, approved by Michigan Public
Service Commission on July 19, 1939, file ED 2-9.01, and that this crossing
will be maintained as provided in such specifications and construction
standards.

Yours very truly,




Ivan Gamble
Supervisor of Rights of Way

REAL ESTATE AND
RIGHTS-OF-WAY DEPT.

RX No. 12120
Location Tray Top
Oakland County
Railroad Grand Trunk Western
Railroad

Subscribed and sworn to before me this
27th day of December, 1956.


Notary Public, Wayne
County, Michigan.
My Commission expires July 21, 1957

Span D-E - P.P. 750' W of Coolidge Hwy &
1150' N of 14 Mile Rd.

RECORDED RIGHT OF WAY NO.

34636
9229

RECEIVED
 MICHIGAN PUBLIC SERVICE
 COMMISSION
 JUN 12 1956
 SECRETARY'S OFFICE

THE DETROIT EDISON COMPANY

2000 SECOND AVENUE
 DETROIT 26, MICHIGAN

June 11, 1956

PUBLIC UTILITIES
 Tel. ----- Gas -----
 Elec. ----- Adm. -----
 JUN 12 1956
 R and S -----
 File -----

Michigan Public Service Commission
 Lansing 13, Michigan

Gentlemen:

The Detroit Edison Company, Detroit, Michigan, hereby makes application for authority to string the following wires over the tracks of the Grand Trunk Western R.R. 22' west of the west limits of the City of Royal Oak, S.E. 1/4 of section 31, Troy Twp., Oakland Co., Mich., T-1N, R-11E.

(Span D-E) Three No. 0 B.C. 24,000 volt wires, three No. 0 wpx 4800 volt wires, three No. 0000 wpx 4800 volt wires, and two No. 6 ew TR system communication wires, over the tracks of the G.T.W.R.R. located in private property at a point approximately 750' west of Coolidge Hwy. and 1150' north of 1 1/2 Mile Rd.

The proposed wire crossing will be constructed in accordance with specifications of the Michigan Public Service Commission and the construction standards of The Detroit Edison Company, approved by the Michigan Public Service Commission on July 19, 1939, File ED 2-9.01.

- Enclosed is a waiver of hearing granted by the Railroad Company.
- Waiver of hearing by the Railroad Company is covered by blanket waiver.
- This application covers reconstruction of existing crossing and will cancel and supersede wire crossing permit No. ED 2-8-3580 dated 3-2-55
- This is a new crossing.

Reference number of construction drawing is RX- 1218D

G. T. W. RR waiver of hearing
 File: 4730-(Troy) 1
 dated 6-8-56, attached

Permit No. ED2-8-3979
 Date June 12, 1956

[Signature]
 Acting Director of Public Utilities

Yours very truly,
[Signature]
 L. G. Sutton
 Supervisor of Rights of Way

1956 JUN 14 AM 9 12
 REAL ESTATE AND
 RIGHTS-OF-WAY DEPT

✓ Check in square indicates statement applicable.

GRAND TRUNK WESTERN RAILROAD COMPANY

T. D. ASH
SUPERINTENDENT
W. A. EDDY
SUPERINTENDENT TERMINALS

7350 ORLEANS STREET,
DETROIT, 11 MICH.
June 8, 1956
File: 4730(Troy) 1

8
RECEIVED
MAY 11 1956
MICHIGAN PUBLIC SERVICE COMMISSION

The Detroit Edison Company
2000 Second Avenue
Detroit 26, Michigan

Gentlemen: Attn: Mr. L. G. Hedden

Kindly refer to your letter of May 22 asking for a waiver of hearing in connection with your desire to make the following changes in your crossings over our tracks located 22 feet West of the West limits of the City of Royal Oak, in the Southeast 1/4 of Section 31, Troy Township, Oakland County, Michigan:

- Span B-C - To add two #6 cw TR system communication wires to the existing crossing of three #0 B.C. 24,000 volt wires, three #0 wpx 4800 volt wires and three #0000 wpx 4800 volt wires in private property at a point approximately 750 feet West of Coolidge Highway and 1150 feet North of 14 Mile Road.
- Span C-D - To add two #6 cw TR system communication wires to the existing crossing of three #0 B.C. 24,000 volt wires, three #0 wpx 4800 volt wires and three #0000 wpx 4800 volt wires in private property at a point approximately 750 feet West of Coolidge Highway and 1150 feet North of 14 Mile Road.
- Span D-E - To add two #6 wp TR system communication wires to the existing crossing of three #0 B.C. 24,000 volt wires, three #0 wpx 4800 volt wires and three #0000 wpx 4800 volt wires in private property at a point approximately 750 feet West of Coolidge Highway and 1150 feet North of 14 Mile Road.

Inasmuch as you have stated all work to be done will be in accordance with the rules and regulations of the Michigan Public Service Commission, I hereby grant you waiver of hearing.

Yours very truly,

T. D. Ash,
Superintendent

Ajr

RECORDED
RIGHT OF WAY NO. 34636
9239

THE DETROIT EDISON COMPANY

PROPOSED LINE CROSSING OVER GRAND TRUNK WESTERN R.R. EXISTING PERMIT NUMBER ED 2-8-3578, 3579, 3580
PRIVATE ROBERT W. COURSEWAY N. OF WHITE RD. CITY OF ROYAL OAK 22 WEST OF WEST LIMITS OF THE
 SECTION 31 SE. 14 TOWNSHIP TROY T. 14 N. R. 11 E. COUNTY DAKLAND

NOV 12 1912

NOTES

MATERIALS SHALL BE AS NOTED IN THE DETROIT EDISON COMPANY'S STANDARD SPECIFICATIONS FOR OVERHEAD LINE CONSTRUCTION AT RAILROAD CROSSINGS DATED MARCH 1917.



ACTUAL FIELD DIMENSIONS MAY VARY SOMEWHAT FROM THOSE SHOWN BUT THE REQUIREMENTS OF ORDER NO. 1878 OF MICHIGAN PUBLIC SERVICE COMMISSION, AS REVISED JAN. 1, 1914, WILL BE COMPLIED WITH.

MINIMUM CLEARANCES


NEAREST POLE TO RAIL	SIDING	7 FT.
WIRES OVER TRACKS	MAIN LINE	12 FT.
		27 FT.
		28 FT.
		30 FT.
WIRES OVER R. R. SIGNAL		2 FT.
		4 FT.
		6 FT.

CONDUCTORS				POLES			
NUMBER	SIZE	KIND	VOLTAGE	LOCATION	LENGTH	CLASS	TYPE
3	0	B.C.	24000	A-B-C	60	1	CEDAR
3	0	WPX	4800	D	50	2	"
3	0	WPX	4800	E	55	3	"
2	6	CM TRYSYS. COMM.		F	55	2	"
				G	40	4	"

DRAWN BY L. HALL ENGINEERING DIVISION DATE 5-15-12
 ESTIMATOR L. S. DAY OVERHEAD LINES DEPT. ROYAL OAK

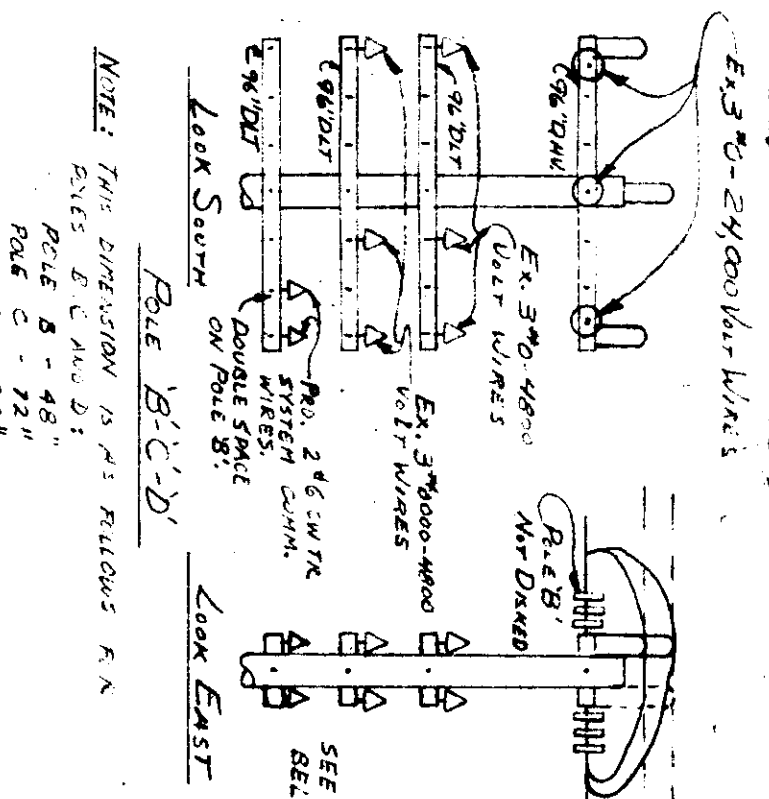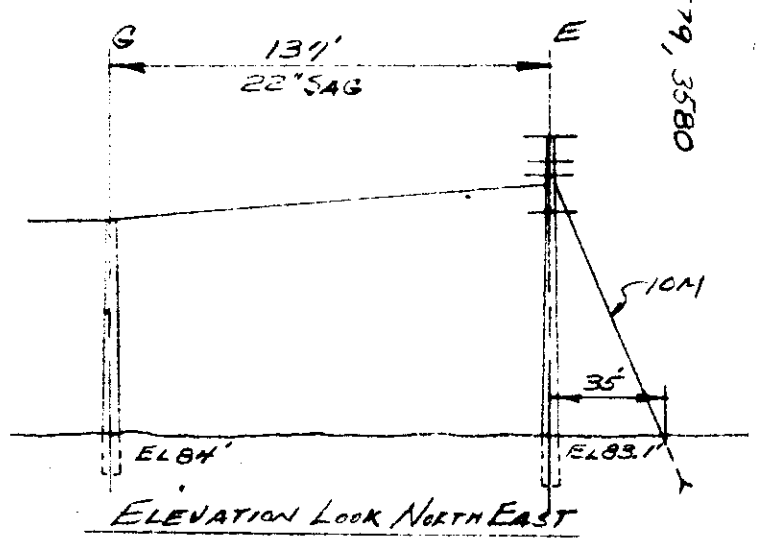

NOTE: THIS DIMENSION IS AS FOLLOWS F.N.
 Poles B, C AND D:
 POLE B - 48"
 POLE C - 72"
 POLE D - 24"

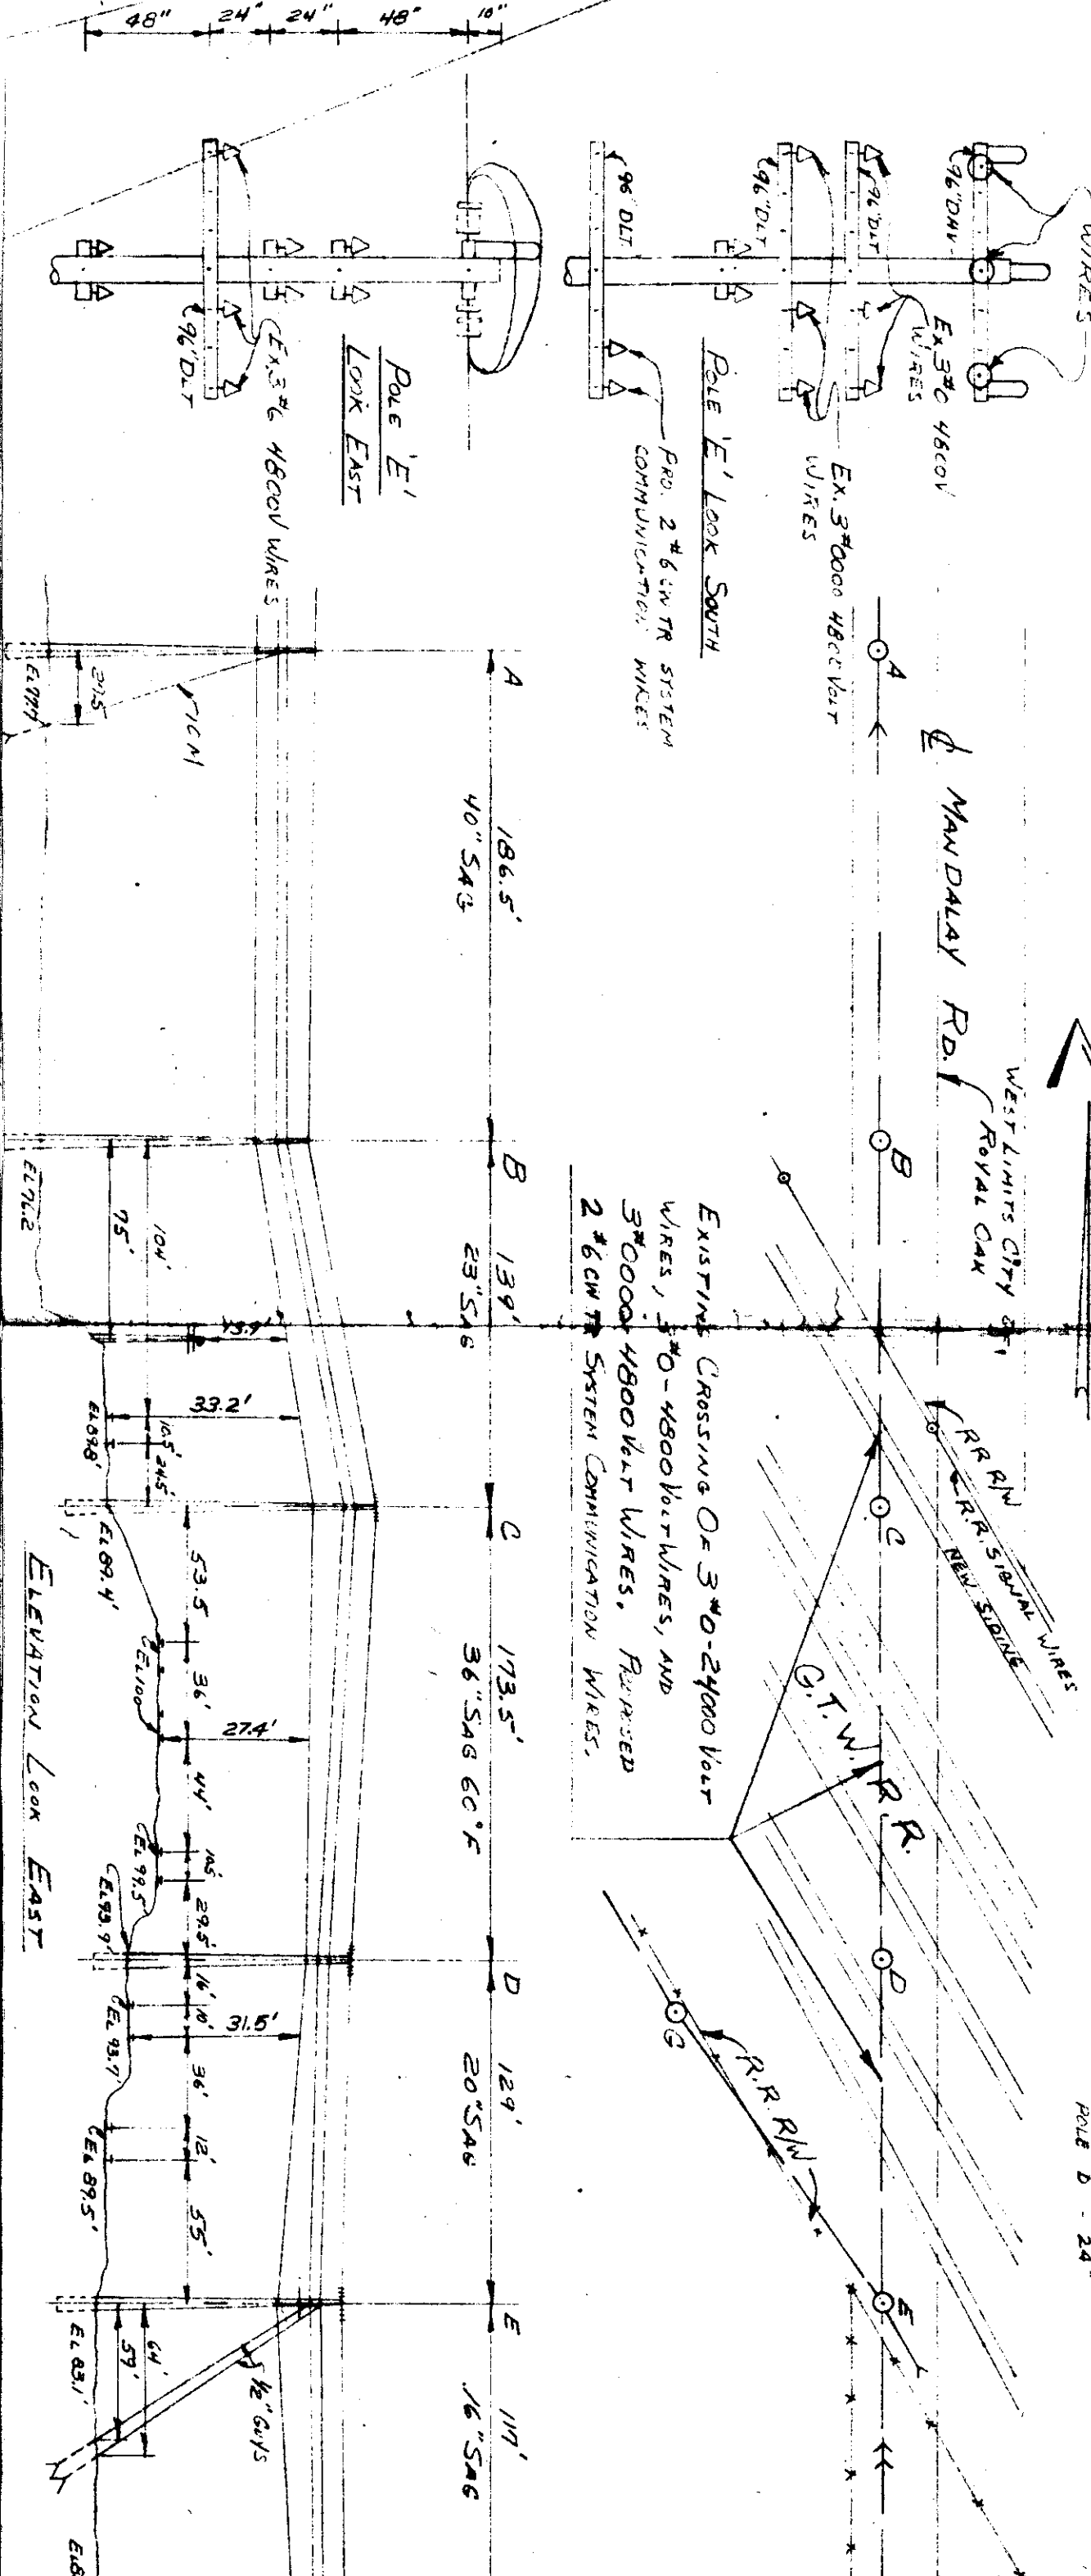

THE DETROIT EDISON COMPANY

2000 SECOND AVENUE
DETROIT 26, MICHIGAN

December 27, 1956

RECEIVED
MICHIGAN PUBLIC SERVICE
COMMISSION
DEC 31 1956
DEPARTMENT ACCOUNTING

PUBLIC UTILITIES
TS. _____ Gas _____
Elec. _____ Adm. _____
DEC 31 1956
R and S _____
File _____

Permit No. ED2-83978

Michigan Public Service Commission
Lansing 13, Michigan

Gentlemen:

I, Ivan Gamble, Supervisor of Rights of Way
of The Detroit Edison Company, Detroit, Michigan, hereby certify that the
wire crossing, covered by Wire Crossing Permit No. ED2-8-3978,
issued June 11, 1956, has been constructed in accordance with
specifications of the Michigan Public Service Commission and construction
standards of The Detroit Edison Company, approved by Michigan Public
Service Commission on July 19, 1939, file ED 2-9.01, and that this crossing
will be maintained as provided in such specifications and construction
standards.

Yours very truly,



Ivan Gamble
Supervisor of Rights of Way

RX No. 1218D


Location Troy Twp.

Oakland County

Railroad Grand Trunk Western

Railroad

Subscribed and sworn to before me this
27th day of December, 1956.

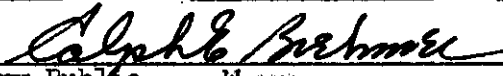
Notary Public, Wayne
County, Michigan.

My Commission expires July 21, 1957

RECORDED RIGHT OF WAY NO.

34636
p229

Span C-D - P.P. 750' W of Coolidge Hwy &
1150' N of 14 Mile Rd

REAL ESTATE AND
RIGHTS-OF-WAY DEPT.

THE DETROIT EDISON COMPANY

2000 SECOND AVENUE
DETROIT 26, MICHIGAN

December 27, 1956

RECEIVED
MICHIGAN PUBLIC SERVICE
COMMISSION
DEC 31 1956
DEPARTMENT ACCOUNTING

Public Utilities
Gas
Elec. Adm.
DEC 31 1956
R end S
Pmc

Permit No. ED2-8-3977

Michigan Public Service Commission
Lansing 13, Michigan

Gentlemen:

I, Ivan Gamble, Supervisor of Rights of Way
of The Detroit Edison Company, Detroit, Michigan, hereby certify that the
wire crossing, covered by Wire Crossing Permit No. ED2-8-3977,
issued June 11, 1956, has been constructed in accordance with
specifications of the Michigan Public Service Commission and construction
standards of The Detroit Edison Company, approved by Michigan Public
Service Commission on July 19, 1939, file ED 2-9.01, and that this crossing
will be maintained as provided in such specifications and construction
standards.

Yours very truly,

Ivan Gamble
Supervisor of Rights of Way

RX No. 1218D

Location Troy Twp.

Oakland County

Railroad Grand Trunk Western

Railroad

Subscribed and sworn to before me this
27th day of December, 1956.

Notary Public, Wayne
County, Michigan.

My Commission expires July 21, 1957

Span B-C - P.P. 750' W of Coolidge Hwy &
1150' N of 14 Mile Rd.

1957 JAN 2 9 1958
REAL ESTATE AND
RIGHTS-OF-WAY DEPT.

RECORDED RIGHT OF WAY NO.

34636
9339

THE DETROIT EDISON COMPANY

2000 SECOND AVENUE
DETROIT 26, MICHIGAN

June 11, 1956

PUBLIC UTILITIES	
Sec. _____	Adm. _____
JUN 12 1956	
Hand S. _____	

Michigan Public Service Commission
Lansing 13, Michigan

Gentlemen:

The Detroit Edison Company, Detroit, Michigan, hereby makes application for authority to string the following wires over the tracks of the Grand Trunk Western R.R. 22' west of the west limits of the City of Royal Oak, S.E. 1/4 of section 31, Troy Twp., Oakland Co., Mich., T-1N, R-11E.

(Span C-D) Three No. 0 B.C. 24,000 volt wires, three No. 0 wpx 4800 volt wires, three No. 0000 wpx 4800 volt wires, and two No. 6 cw TR system communication wires, over the tracks of the G.T.W.R.R. located in private property at a point approximately 750' west of Coolidge Hwy. and 1150' north of 14 Mile Rd.

The proposed wire crossing will be constructed in accordance with specifications of the Michigan Public Service Commission and the construction standards of The Detroit Edison Company, approved by the Michigan Public Service Commission on July 19, 1939, File ED 2-9.01.

- Enclosed is a waiver of hearing granted by the Railroad Company.
- Waiver of hearing by the Railroad Company is covered by blanket waiver.
- This application covers reconstruction of existing crossing and will cancel and supersede wire crossing permit No. ED 2-8-3579 dated 3-2-55
- This is a new crossing.

Reference number of construction drawing is RX- 1218D

G. T. W. RR waiver of hearing
File: 4730-(Troy) 1
dated 6-8-56, attached

Yours very truly,

L. G. Hedden
Supervisor of Rights of Way

Permit No. ED2-8-3978

Date June 12, 1956

By [Signature]
Acting Director of Public Utilities.

1956 JUN 14 REPT
REAL ESTATE AND RIGHTS OF WAY DEPT

✓ Check in square indicates statement applicable.

RECORDED RIGHT OF WAY NO.

34436
12229

THE DETROIT EDISON COMPANY
JUN 12 1956
SECRETARY'S OFFICE

THE DETROIT EDISON COMPANY
2000 SECOND AVENUE
DETROIT 26, MICHIGAN

June 11, 1956

6-217115
T. L. _____ Gen. _____
F. _____ Adm. _____
JUN 12 1956
Rec'd S. _____
R. _____

Michigan Public Service Commission
Lansing 13, Michigan

Gentlemen:

The Detroit Edison Company, Detroit, Michigan, hereby makes application for authority to string the following wires over the tracks of the Grand Trunk Western R.R. 22' west of the west limits of the City of Royal Oak, S.E. 1/4 of section 31, Troy Twp., Oakland Co., Mich., T-1N, R-11E.

(Span B-C) Three No. 0 B.C. 24,000 volt wires, three No. 0 wpx 4800 volt wires, three No. 0000 wpx 4800 volt wires and two No. 6 cw TR system communication wires, over the tracks of the G.T.W.R.R. located in private property at a point approximately 750' west of Coolidge Hwy. and 1150' north of 1 1/4 Mile Rd.

The proposed wire crossing will be constructed in accordance with specifications of the Michigan Public Service Commission and the construction standards of The Detroit Edison Company, approved by the Michigan Public Service Commission on July 19, 1939, File ED 2-9.01.

- Enclosed is a waiver of hearing granted by the Railroad Company.
- Waiver of hearing by the Railroad Company is covered by blanket waiver.
- This application covers reconstruction of existing crossing and will cancel and supersede wire crossing permit No. ED 2-8-3578 dated 3-2-55
- This is a new crossing.

Reference number of construction drawing is RX-1218D

G. T. W. RR waiver of hearing
File: 4730-(Troy) 1
dated 6-8-56, attached

Yours very truly,

L. G. Hedden

L. G. Hedden
Supervisor of Rights of Way

Permit No. ED2-8-3977
Date June 12, 1956

J. M. Steffen
Acting Director of Public Utilities.

1956 JUN 14 AM 9 12
REAL ESTATE AND RIGHTS-OF-WAY DEPT.

✓ Check in square indicates statement applicable.

RECORDED RIGHT OF WAY NO.

*346 3/4
9-22-59*