

4-19-68

TELEPHONE WOODWARD 2-2100

MICHIGAN PUBLIC SERVICE COMM.  
PUBLIC UTILITIES DIVISION

Tel. \_\_\_\_\_ Gas \_\_\_\_\_  
Elec. \_\_\_\_\_ R & S \_\_\_\_\_

APR 23 1968

Adm. \_\_\_\_\_  
File \_\_\_\_\_

**THE DETROIT EDISON COMPANY** RECEIVED

2000 SECOND AVENUE  
DETROIT 26, MICHIGAN

April 19, 1968

1968 APR 23 AM 8 38

Michigan Public Service Commission  
Lansing 13, Michigan

MICHIGAN PUBLIC SERVICE  
COMMISSION

Gentlemen:

The Detroit Edison Company, Detroit, Michigan, hereby makes application for authority to string the following wires over the tracks of the Grand Trunk Western Railroad in the Village of North Branch, SE 1/4 of Section 4, North Branch Township, T-9N, R-11E, Lapeer County, Michigan.

Span A - B

Three #6 wpx - 4800 volt wires and one 3/16" extra heavy strength guy wire over the siding track of the G.T.W. R.R. located in Huron Street at a point approximately 2640' west of Lake Pleasant Road. Also 215' north of the North Branch Depot.

The proposed wire crossing will be constructed in accordance with specifications of the Michigan Public Service Commission and the construction standards of The Detroit Edison Company, approved by the Michigan Public Service Commission on July 19, 1939, File ED 2-9.01.

- Enclosed is a waiver of hearing granted by the Railroad Company.
- Waiver of hearing by the Railroad Company is covered by blanket waiver.
- This application covers reconstruction of existing crossing and will cancel and supersede wire crossing permit No. ED 2-8-3079 dated 8-29-52.
- This is a new crossing.

Reference number of construction drawing is RX- 1829D.

R. R. File: 4730-North Branch-3

Permit No. ED2-8-6224

Date 4-23-68

By J M Hoppe

Yours very truly,

*I. W. Gamble*

I. W. Gamble  
Supervisor of Rights of Way  
Properties and Rights of Way Dept.

JVS/mld Check in circle indicates statement applicable.

RECORDED RIGHT OF WAY NO. 34636-799

# THE DETROIT EDISON COMPANY

2000 SECOND AVENUE  
DETROIT, MICHIGAN 48226

TO:

April 19, 1968

Mr. J. S. Colton, Division Engineer  
Grand Trunk Western Railroad Company  
7350 Orleans Street  
Detroit, Michigan 48211

Proposed Overhead Wire Crossing:

Three #6 wpx - 4800 volt wires and one 3/16 inch extra heavy strength  
guy wire (Span A-B)

Specific Location

In Huron Street at a point approximately 2640 feet west of Lake Pleasant Road.  
Also 215 feet north of the North Branch Depot.

RECORDED RIGHT OF WAY NO. 34636  
499

R. R. Valuation Station \_\_\_\_\_ R. R. Mile Post \_\_\_\_\_

~~City~~/Village North Branch Township North Branch, Southeast 1/4 of Sec. 4

County Lapeer Detroit Edison Plan Attached RX-1829D


This is a New Crossing \_\_\_\_\_ This is a Reconstruction of Existing Crossing X

Previous Agreement Information (if any) Date September 16, 1952 <sup>Permit 249</sup> (R. R. Plan) L-92-52

Permit covers stub pole "F" guy wire and anchor only extended south from Pole "B" as shown on this plan (File: 4730-North Branch-3)

Blanket Waiver of Hearing Covers X Waiver of Hearing Requested \_\_\_\_\_  
(Waiver of Hearing to be mailed to applicant listed below)

All construction will be done in accordance with the rules and regulations of the Michigan Public Service Commission.

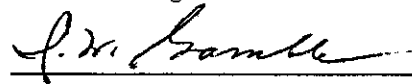


I. W. Gamble, Supervisor of Rights of Way  
Properties and Rights of Way Department

NOTES		CONDUCTORS				POLES			
MATERIALS SHALL BE AS NOTED IN THE DETROIT EDISON COMPANY'S STANDARD SPECIFICATIONS FOR OVERHEAD LINE CONSTRUCTION AT RAILROAD CROSSINGS DATED MARCH 1947.		NUMBER	SIZE	KIND	VOLTAGE	LOCATION	LENGTH	CLASS	TYPE
ACTUAL FIELD DIMENSIONS MAY VARY SOMEWHAT FROM THOSE SHOWN BUT THE REQUIREMENTS OF ORDER NO. 1679 OF MICHIGAN PUBLIC SERVICE COMMISSION, AS REVISED JAN. 1, 1944, WILL BE COMPLIED WITH.		3	3/8"	WFX	4800	A	40	1	CELEP
MINIMUM CLEARANCES		1	1"	BAAD	120	B-E	45	1	"
NEAREST POLE TO RAIL	BIDING 7 FT. MAIN LINE 12 FT.	2	3/8"	WFX	4800	C	45	5	FINE
WIRES OVER TRACKS	0 - 500 VOLTS 27 FT. 500 - 7500 VOLTS 28 FT. 24000 VOLTS 30 FT.	3	3/8"	WFX	4800	D	50	3	"
WIRES OVER R.R. SIGNAL	0 - 500 VOLTS 2 FT. 500 - 7500 VOLTS 4 FT. 24000 VOLTS 8 FT.	1	3/8"	WFX	4800	F	30	4	"
		1	3/8"	WFX	4800	G	40	2	CODE


DRAWN BY D.S. BCDM ENGINEERING DIVISION DATE 8-25-50  
ESTIMATOR E. M. HUNT OVERHEAD LINES DEPT. LAPEER

EX. 3/8" - 4800 V. WIRES

(TO B & G)

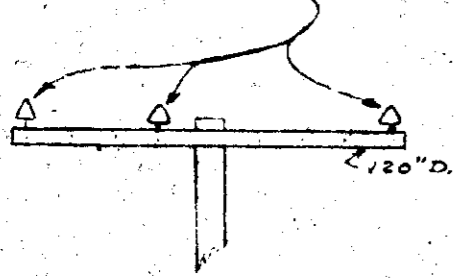


Pole F Looking North

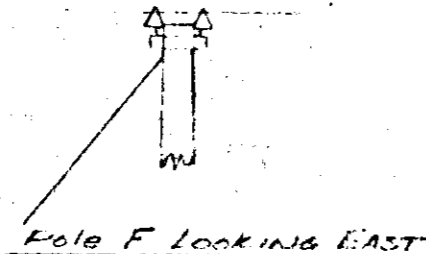


Pole F Looking East

EX. 3/8" - 4800 V. WIRES TO (E & F)


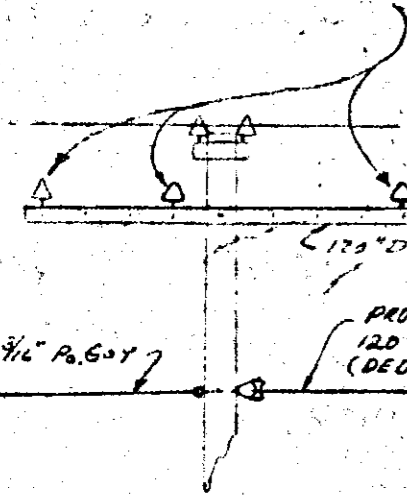


Pole B Looking North

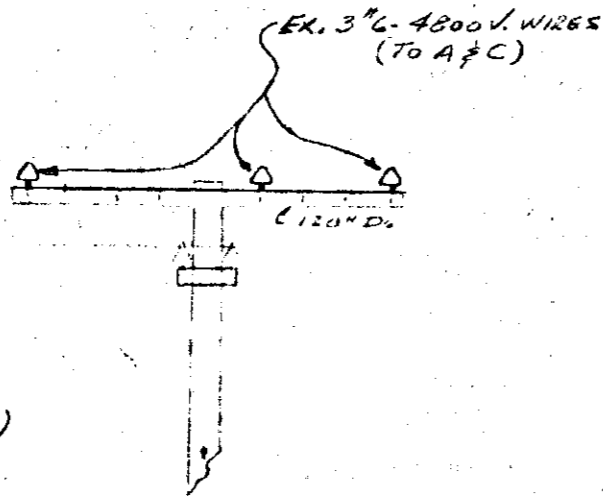


Pole B Looking East


CROSSINGS OF EXISTING 3/8" - 9800 V. WIRES

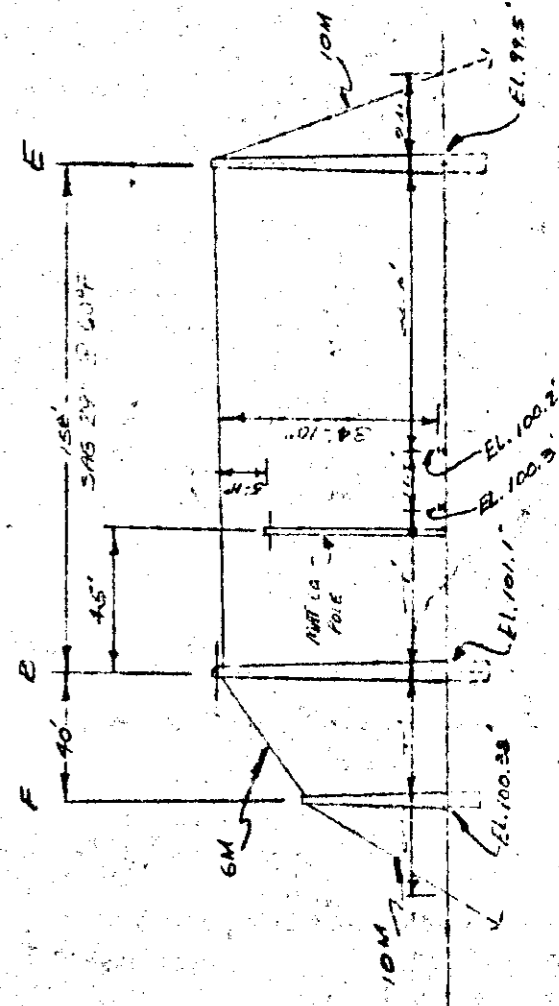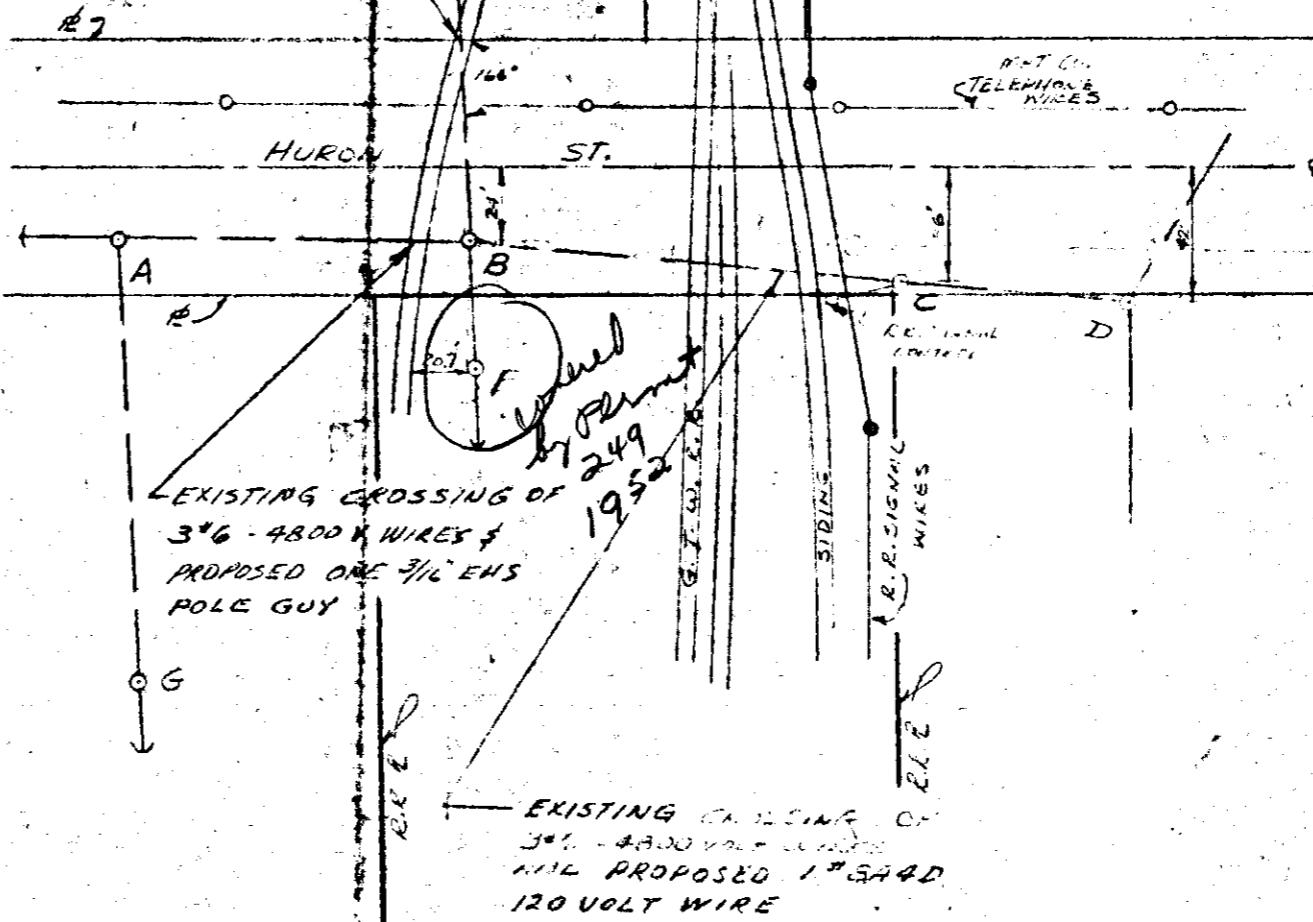


ELEVATION LOOKING WEST

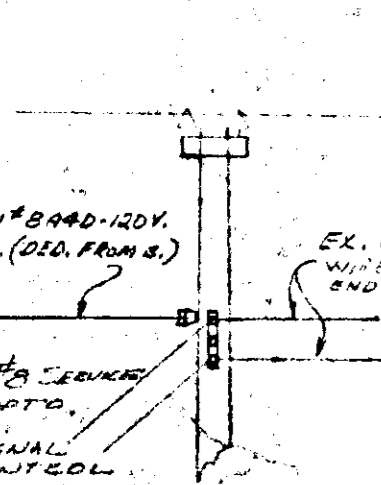


Pole C Looking North

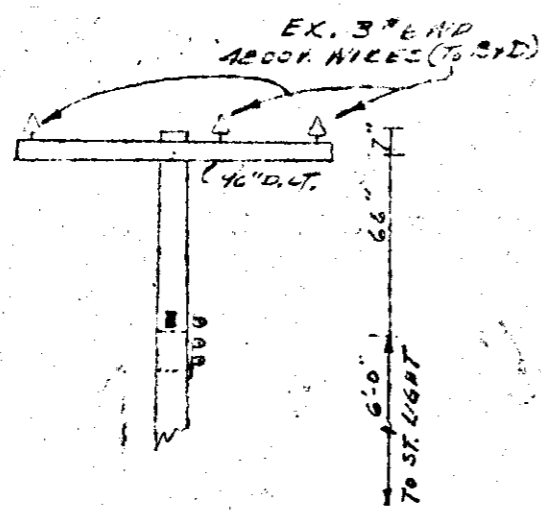


Pole C Looking East

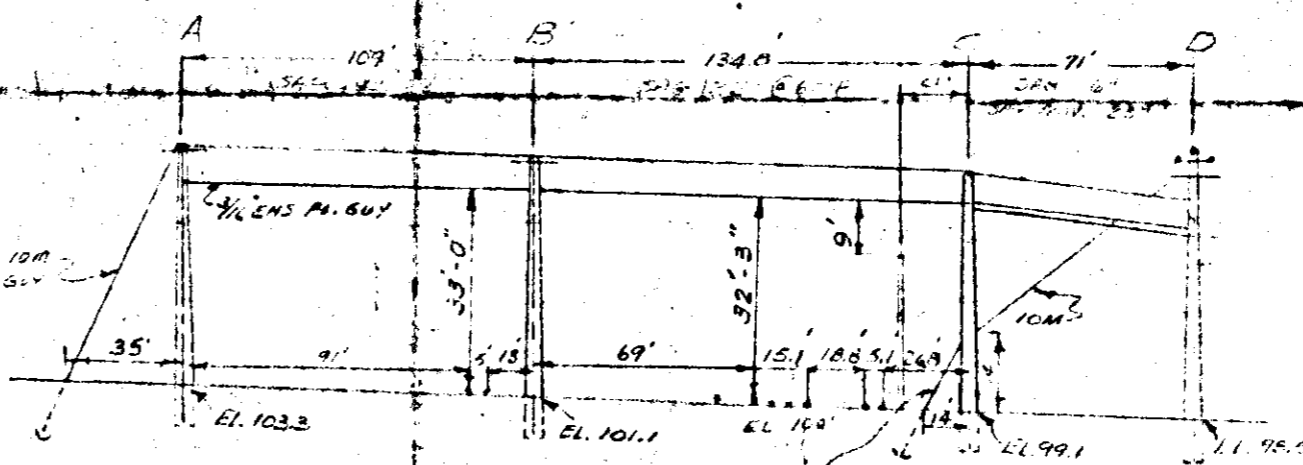


ELEVATION LOOKING NORTH

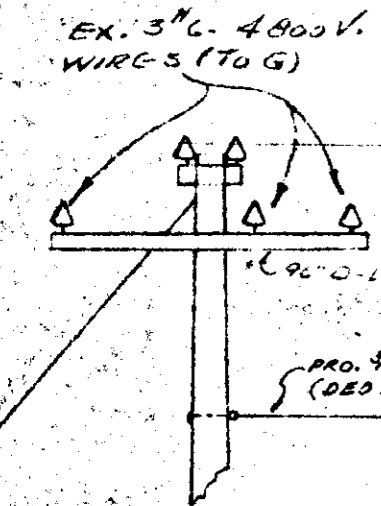

Pole A Looking North

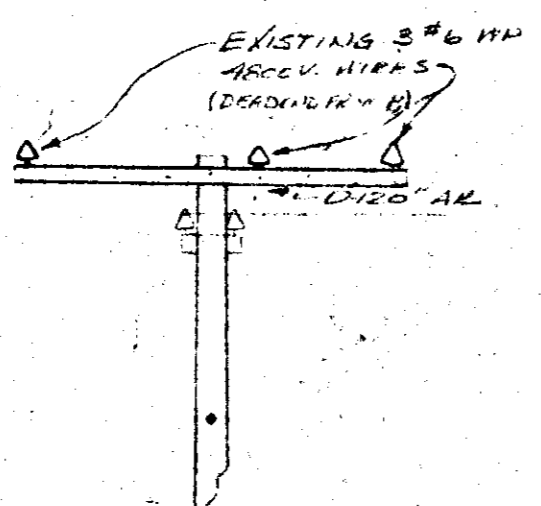

Pole A Looking East

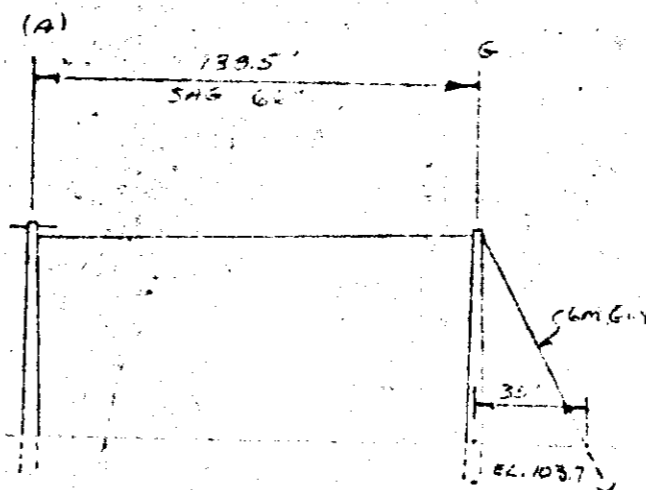

ELEVATION LOOKING EAST

34636 p99

MICHIGAN PUBLIC SERVICE COMMISSION  
PUBLIC UTILITIES DIVISION

Tel. \_\_\_\_\_ Gas \_\_\_\_\_  
Elec. \_\_\_\_\_ R & S \_\_\_\_\_

APR 23 1968

Adm. \_\_\_\_\_  
File \_\_\_\_\_

# THE DETROIT EDISON COMPANY

## RECEIVED

2000 SECOND AVENUE  
DETROIT 26, MICHIGAN

April 19, 1968

1968 APR 23 AM 8 38

Michigan Public Service Commission  
Lansing 13, Michigan

MICHIGAN PUBLIC SERVICE  
COMMISSION

Gentlemen:

The Detroit Edison Company, Detroit, Michigan, hereby makes application for authority to string the following wires over the tracks of the **Grand Trunk Western Railroad in the Village of North Branch, SE 1/4 of Section 4, North Branch Township, T-9N, R-11E, Leapeer County, Michigan.**

Span B - C

Three #6 wpx - 4800 volt wires and one #8A4D - 120 volt wire consisting of one #8 aluminum 4/64 neoprene covered conductor with one #4 ACSR messenger wire over the tracks of the G.T.W. R.R. located in Huron Street at a point approximately 2540' west of Lake Pleasant Road. Also 215' north of the North Branch Depot.

The proposed wire crossing will be constructed in accordance with specifications of the Michigan Public Service Commission and the construction standards of The Detroit Edison Company, approved by the Michigan Public Service Commission on July 19, 1939, File ED 2-9.01.

- Enclosed is a waiver of hearing granted by the Railroad Company.
- Waiver of hearing by the Railroad Company is covered by blanket waiver.
- This application covers reconstruction of existing crossing and will cancel and supersede wire crossing permit No. **ED 2-8-3079** dated **8-29-52**.
- This is a new crossing.

Reference number of construction drawing is **RX-1829D**.

R.R. File: **4730-North Branch-3**

**ED2-8-6225**

Permit No. \_\_\_\_\_

**4-23-68**

Date \_\_\_\_\_

By *J. M. Hoppe*

JVS/mld

Check in circle indicates statement applicable.

Yours very truly,

*I. W. Gamble*

**I. W. Gamble**  
Supervisor of Rights of Way  
Properties and Rights of Way Dept.

RECORDED RIGHT OF WAY NO. 34636  
499

MICHIGAN PUBLIC SERVICE COM. PUBLIC UTILITIES DIVISION

Tel. \_\_\_\_\_ Gas \_\_\_\_\_  
 Elec. \_\_\_\_\_ R & S \_\_\_\_\_

**APR 23 1968**

Adm. \_\_\_\_\_  
 File \_\_\_\_\_

# THE DETROIT EDISON COMPANY

2000 SECOND AVENUE  
DETROIT 26, MICHIGAN

RECEIVED

April 19, 1968

1968 APR 23 AM 8 38

Michigan Public Service Commission  
Lansing 13, Michigan

MICHIGAN PUBLIC SERVICE COMMISSION

Gentlemen:

The Detroit Edison Company, Detroit, Michigan, hereby makes application for authority to string the following wires over the tracks of the Grand Trunk Western Railroad in the Village of North Branch, SE 1/4 of Section 4, North Branch Township, T-9N, R-11E, Lapeer County, Michigan.

Span B - E

Three #6 wpx - 4800 volt wires over the siding track of the G.T.W. R.R. located in Huron Street at a point 2620' west of the centerline of Lake Pleasant Road. Also 215' north of the North Branch Depot.

The proposed wire crossing will be constructed in accordance with specifications of the Michigan Public Service Commission and the construction standards of The Detroit Edison Company, approved by the Michigan Public Service Commission on July 19, 1939, File ED 2-9.01.

- Enclosed is a waiver of hearing granted by the Railroad Company.
- Waiver of hearing by the Railroad Company is covered by blanket waiver.
- This application covers reconstruction of existing crossing and will cancel and supersede wire crossing permit No. ED 2-8-3079 dated 8-29-52.
- This is a new crossing.

Reference number of construction drawing is RX- 1829D.

R.R. File: 4730-North Branch-3

Permit No. ED2-8-6226

Date 4-23-68

By J M Hoppe

JVS/mld

Check in circle indicates statement applicable.

Yours very truly,

*I. W. Gamble*

I. W. Gamble  
Supervisor of Rights of Way  
Properties and Rights of Way Dept.

RECORDED RIGHT OF WAY NO. 34636  
999

# THE DETROIT EDISON COMPANY

2000 SECOND AVENUE

DETROIT, MICHIGAN 48226

TO:

April 19, 1968

Mr. J. S. Colton, Division Engineer  
Grand Trunk Western Railroad Company  
7350 Orleans Street  
Detroit, Michigan 48211

Proposed Overhead Wire Crossing:

Three #6 wpx - 4800 volt wires and one #8A4D - 120 volt wire consisting of one #8 aluminum 4/64 neoprene covered conductor with one #4 ACSR messenger wire (Span B-C)

Specific Location

In Huron Street at a point approximately 2540 feet west of Lake Pleasant Road. Also 215 feet north of the North Branch Depot.

RECORDED RIGHT OF WAY NO. 34636  
1999

R. R. Valuation Station \_\_\_\_\_ R. R. Mile Post \_\_\_\_\_

City/Village ~~XXX~~ North Branch Township North Branch, Southeast 1/4 of Sec. 4

County Lapeer Detroit Edison Plan Attached RX 1829D

This is a New Crossing \_\_\_\_\_ This is a Reconstruction of Existing Crossing x

Previous Agreement Information (if any) Date \_\_\_\_\_ (R. R. Plan) \_\_\_\_\_  
Permit 249 9-16-52 L-92-52

~~Permit covers stub pole "F" guy wire and anchor only extended south from Pole "B" as shown on this plan~~  
(File: 4730-North Branch-3)

Blanket Waiver of Hearing Covers x Waiver of Hearing Requested \_\_\_\_\_  
(Waiver of Hearing to be mailed to applicant listed below)

All construction will be done in accordance with the rules and regulations of the Michigan Public Service Commission.

*I. W. Gamble*

I. W. Gamble, Supervisor of Rights of Way  
Properties and Rights of Way Department

# THE DETROIT EDISON COMPANY

2000 SECOND AVENUE  
DETROIT, MICHIGAN 48226

TO:

April 19, 1968

Mr. J. S. Colton, Division Engineer  
Grand Trunk Western Railroad Company  
7350 Orleans Street  
Detroit, Michigan 48211

Proposed Overhead Wire Crossing:

Three #6 wpx - 4800 volt wires (Span B-E)

Specific Location

In Huron Street at a point 2620 feet west of the center line of  
Lake Pleasant Road. Also 215 feet north of the North Branch Depot.

R. R. Valuation Station \_\_\_\_\_ R. R. Mile Post \_\_\_\_\_

City/Village ~~XXX~~ North Branch Township North Branch, Southeast 1/4 of Sec. 4

County Lapeer Detroit Edison Plan Attached RX-1629D

This is a New Crossing \_\_\_\_\_ This is a Reconstruction of Existing Crossing X


Previous Agreement Information (if any) Date \_\_\_\_\_ (R. R. Plan) \_\_\_\_\_

Permit 249 9-16-52 L-92-52

Permit covers stub pole "F" guy wire and anchor only extended south from Pole "E" as shown on this plan  
Blanket Waiver of Hearing Covers X Waiver of Hearing Requested (File: 4730-North Branch-3)

(Waiver of Hearing to be mailed to applicant listed below)

All construction will be done in accordance with the rules and regulations of the Michigan Public Service Commission.

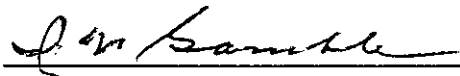

I. W. Gamble, Supervisor of Rights of Way  
Properties and Rights of Way Department

RECORDED RIGHT OF WAY NO. 34636  
7099