

THE DETROIT EDISON COMPANY

2000 SECOND AVENUE

DETROIT 26, MICHIGAN

May 4, 1961

1961 MAY 9 PM 12 32

REAL ESTATE AND
RIGHTS-OF-WAY DEPT.

TOLSON	
FEDERAL BUREAU OF INVESTIGATION	
Tel. _____	Gas _____
Elec. _____	R & S _____
MAY 5 1961	
Adm. _____	
File _____	

Permit No. 100-4-1000

Michigan Public Service Commission
Lansing 13, Michigan

Gentlemen:

I, Ivan Gamble, Supervisor of Rights of Way
of The Detroit Edison Company, Detroit, Michigan, hereby certify that the
wire crossing, covered by Wire Crossing Permit No. 100-4-1000,
issued 2-2-61, has been constructed in accordance with
specifications of the Michigan Public Service Commission and construction
standards of The Detroit Edison Company, approved by Michigan Public Service
Commission on July 19, 1939, file ED 2-9.01, and that this crossing will be
maintained as provided in such specifications and construction standards.

Yours very truly,

I. W. Gamble
Supervisor of Rights of Way
Real Estate and Rights of Way Department

RX No. 11700
Location City of Detroit,
County of Wayne
Railroad Wabash Railroad

Subscribed and sworn to before me this
4th day of May, 1961
Ivan Gamble
Notary Public, Michigan
County, Michigan.
My Commission expires 10-28-62

In Mellen Ave. approx. 520' W. of
the South Dix Ave. c/l (Span A-B)

34637
pm

RECEIVED
FEB 2 1961
MICHIGAN PUBLIC SERVICE
COMMISSION

THE DETROIT EDISON COMPANY

2000 SECOND AVENUE
DETROIT 26, MICHIGAN

January 31, 1961

1961 FEB 7 AM 9 44
REAL ESTATE AND
RIGHTS-OF-WAY DEPT.

Michigan Public Service Commission
Lansing 13, Michigan

Gentlemen:

The Detroit Edison Company, Detroit, Michigan, hereby makes application for authority to string the following wires over the tracks of the **Wabash Railroad in the City of Detroit, Wayne County, Michigan.**

Span A-B

Three #350M bare 4800 volt wires over the track of the Wabash R.R. located in Mallon Ave. approximately 520' west of the South Dix Avenue center line.

Foreign Wires: City of Detroit Public Lighting Commission two #6 THW street circuit wires and Michigan Bell Telephone Company cable (1) and service wires (2).

SEARCHED	INDEXED
SERIALIZED	FILED
FEB 2 1961	
Adm.	

The proposed wire crossing will be constructed in accordance with specifications of the Michigan Public Service Commission and the construction standards of The Detroit Edison Company, approved by the Michigan Public Service Commission on July 19, 1939, File ED 2-9.01.

- Enclosed is a waiver of hearing granted by the Railroad Company.
- Waiver of hearing by the Railroad Company is covered by blanket waiver.
- This application covers reconstruction of existing crossing and will cancel and supersede wire crossing permit No. **ED 2-8-1960** dated **8-6-47**.
- This is a new crossing.

Reference number of construction drawing is **RX-1170B**.

Yours very truly,

I. W. Gumble

I. W. Gumble
Supervisor of Rights of Way
Real Estate and Rights of Way Dept.

Permit No. ED2-8-4820

Date 2-3-61

By J. M. Stoppe

Check in circle indicates statement applicable.

PROPERTY OF THE DETROIT EDISON COMPANY
34637
111

THE DETROIT EDISON COMPANY

2000 SECOND AVENUE
DETROIT 26, MICHIGAN

TO: Mr. L. B. Yarbrough, Engineer
Signals and Communications
Room 1551, Railway Exchange Building
St. Louis 1, Missouri

November 13, 1964

We hereby ~~notify you~~ request permission for facilities over your tracks and/or
right of way as follows:

Proposed Construction:

Install one 3/16 inch extra heavy steel guy wire, (Span F-B).

Specific Location

In private property at a point approximately 460 feet west of the center line of
South Dix Avenue and 60 feet north of the center line of Mallon Avenue.

R.R. Valuation Station _____ R.R. Mile Post _____

City/Village ~~Ann Arbor~~ **Detroit** _____ Township _____

County **Wayne** _____ Detroit Edison Plan Attached **RE - 1170-C** _____

This is a New Crossing _____ This is a Reconstruction of Existing Crossing _____

Previous Agreement Information (if any) Date _____ (R.R. Plan) _____

No Agreement _____

Blanket Waiver of Hearing Covers _____ Waiver of Hearing Requested In Duplicate
(Waiver of Hearing to be mailed to applicant listed below)

All construction will be done in accordance with the rules and regulations of the
Michigan Public Service Commission.

I. W. Gamble
I. W. Gamble, Supervisor of Rights of Way
Properties and Rights of Way Dept.

RECORDED RIGHTS OF WAY NO. 34637
p11

PROPOSED LINE CROSSING OVER THE WAREH R.R. IN MELLON AVE APPROX 320' & 520' WEST CITY OF AND DETROIT SECTION OF S. DIX AVE IN PART, APPROX 400' W OF S. DIX AVE, AND COUNTY WAYNE

RX 11700
ED 28 4819
EXH. ENG PERMIT NUMBER ED 28 4820

NOTES

MATERIALS SHALL BE AS NOTED IN THE DETROIT EDISON COMPANY'S STANDARD SPECIFICATIONS FOR OVERHEAD LINE CONSTRUCTION AT RAILROAD CROSSINGS DATED MARCH 1947.
ACTUAL FIELD DIMENSIONS MAY VARY SOMEWHAT FROM THOSE SHOWN BUT THE REQUIREMENTS OF ORDER NO. 1879 OF MICHIGAN PUBLIC SERVICE COMMISSION, AS REVISED JAN. 1, 1944, WILL BE COMPLIED WITH.



MINIMUM CLEARANCES

NEAREST POLE TO RAIL	SIDING MAIN LINE	7 FT.	12 FT.
0 - 500 VOLTS	27 FT.		
500 - 7500 VOLTS	28 FT.		
24000 VOLTS	30 FT.		

WIRES OVER R.R. SIGNAL
SCALE: PLAN 1"=60' AL. 1"=30' 500-7500 VOLTS 24000 VOLTS
POLE 180' 125' D.

CONDUCTORS			POLES				
NUMBER	SIZE	RING	VOLTAGE	LOCATION	LENGTH	CLASS	TYPE
2	350M	B	4800	B-C	40'	2	WOOD
1	350M	A	4800	D	40'	1	"
SPAN E-B				E	40'	5	"
SPAN F-B				F	40'	8	"
SPAN G-B				G	25'	3	"
SPAN H-B				H	45'	1	"

DRAWN BY J. METZ ENGINEERING DIVISION DATE 11-5-64
ESTIMATOR A. WILKINSON OVERHEAD LINES DEPT. WARREN SERVICE

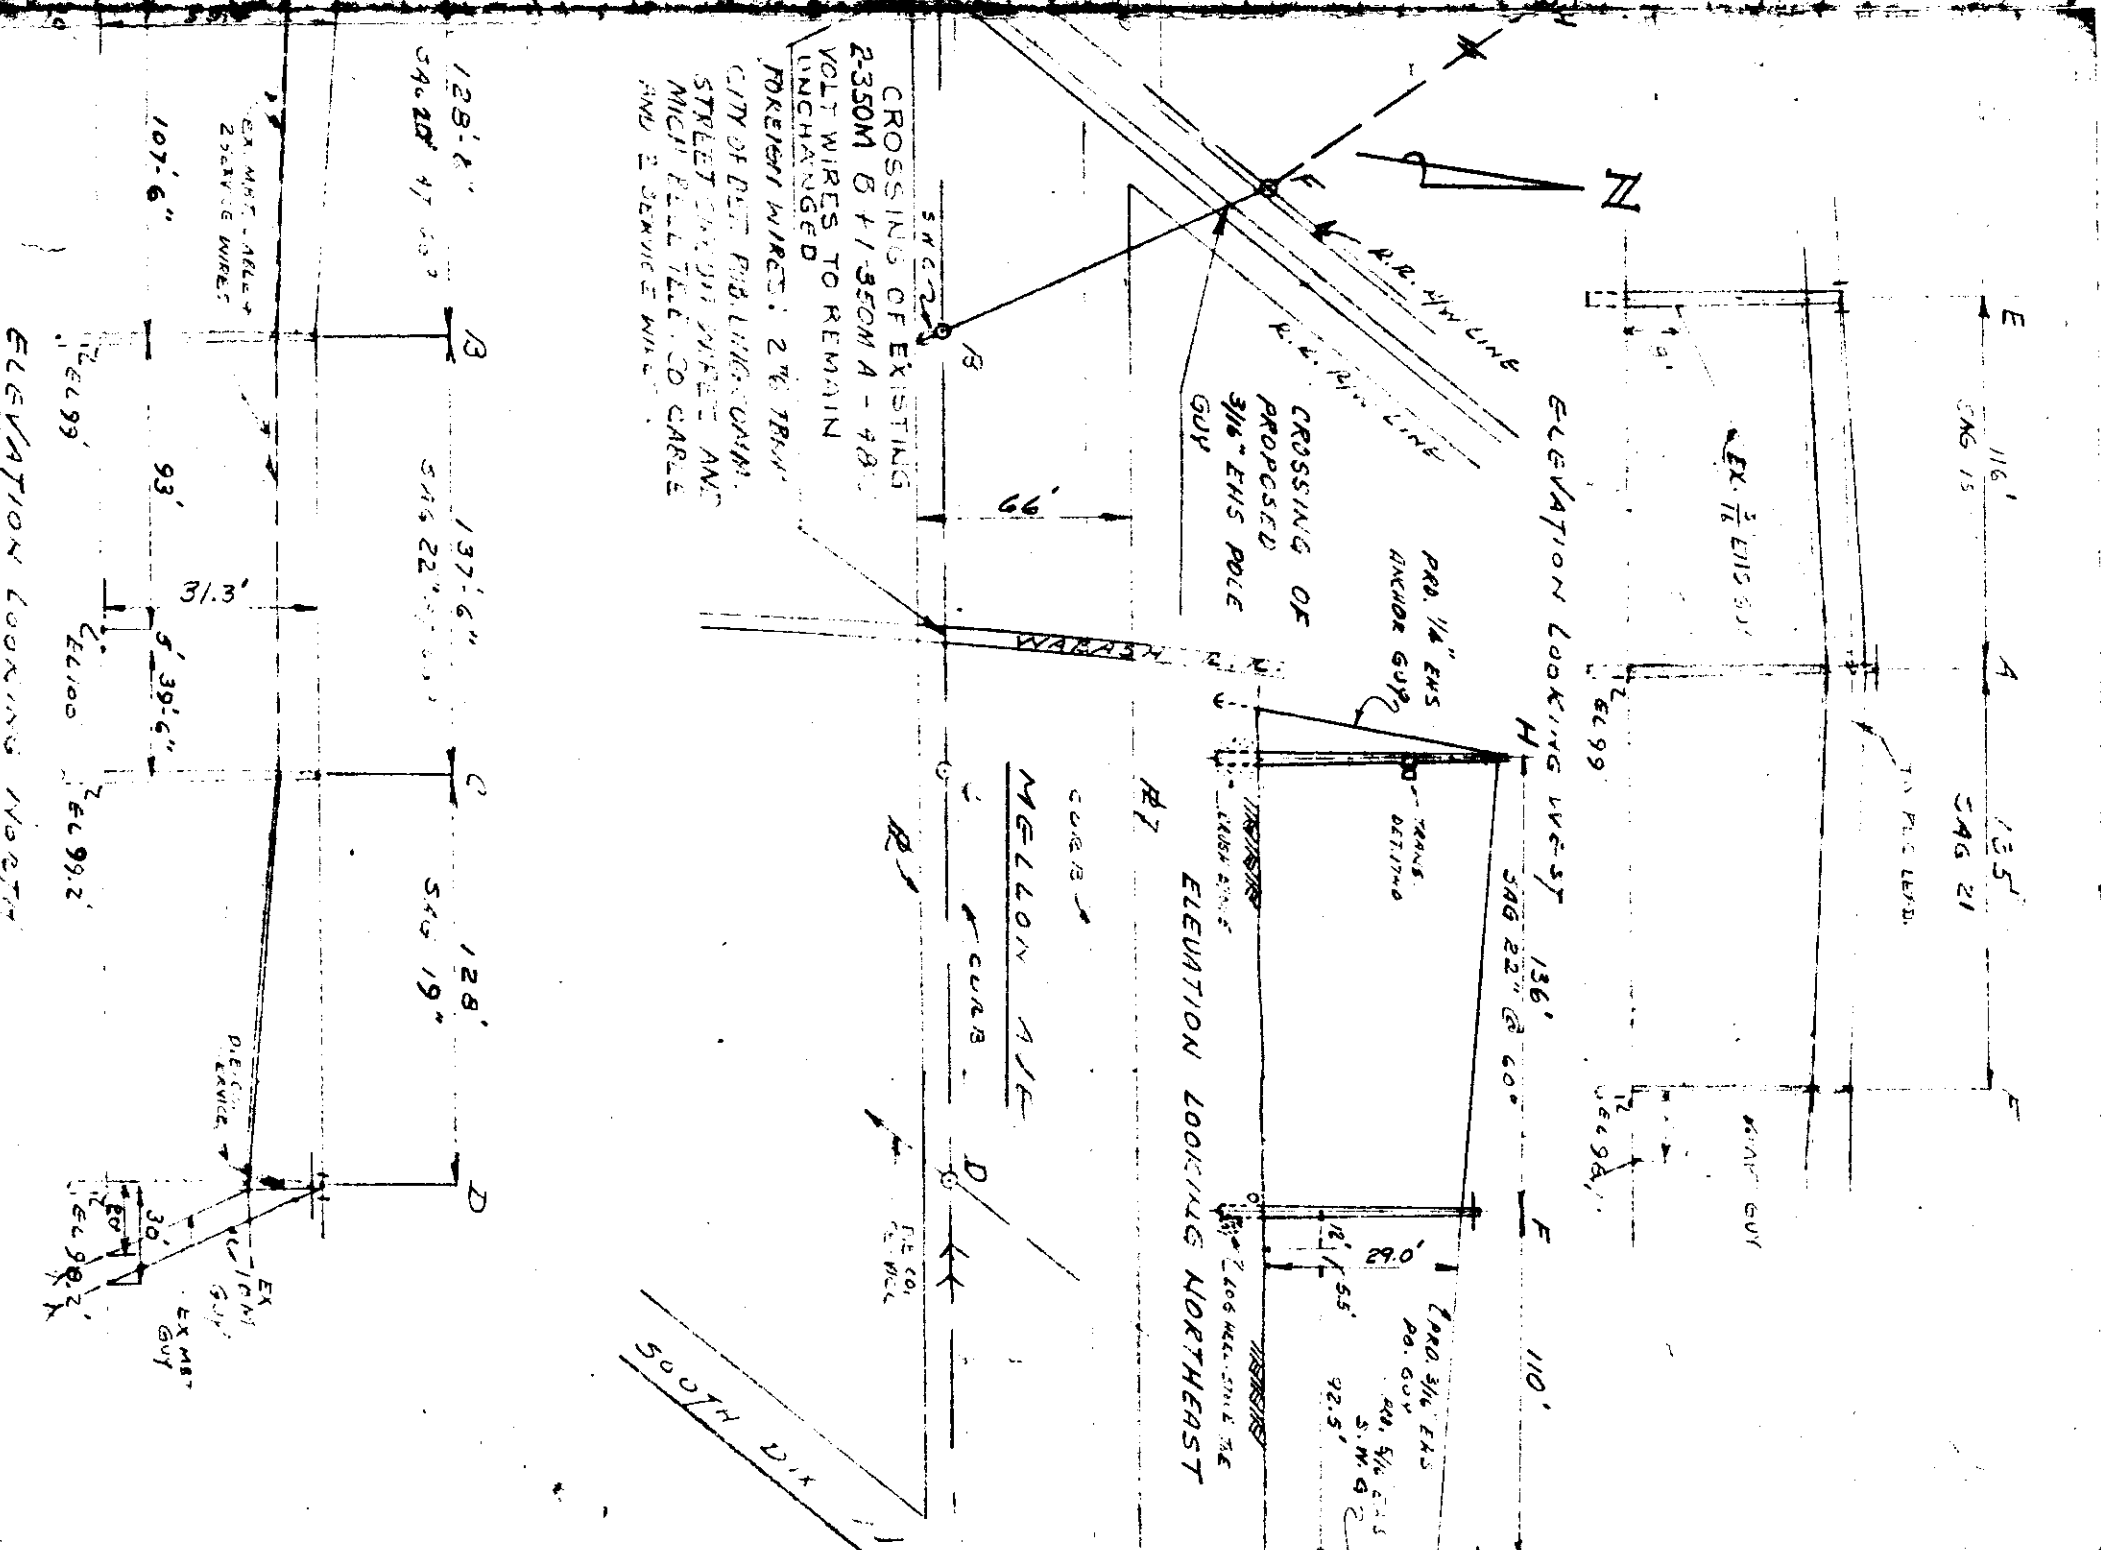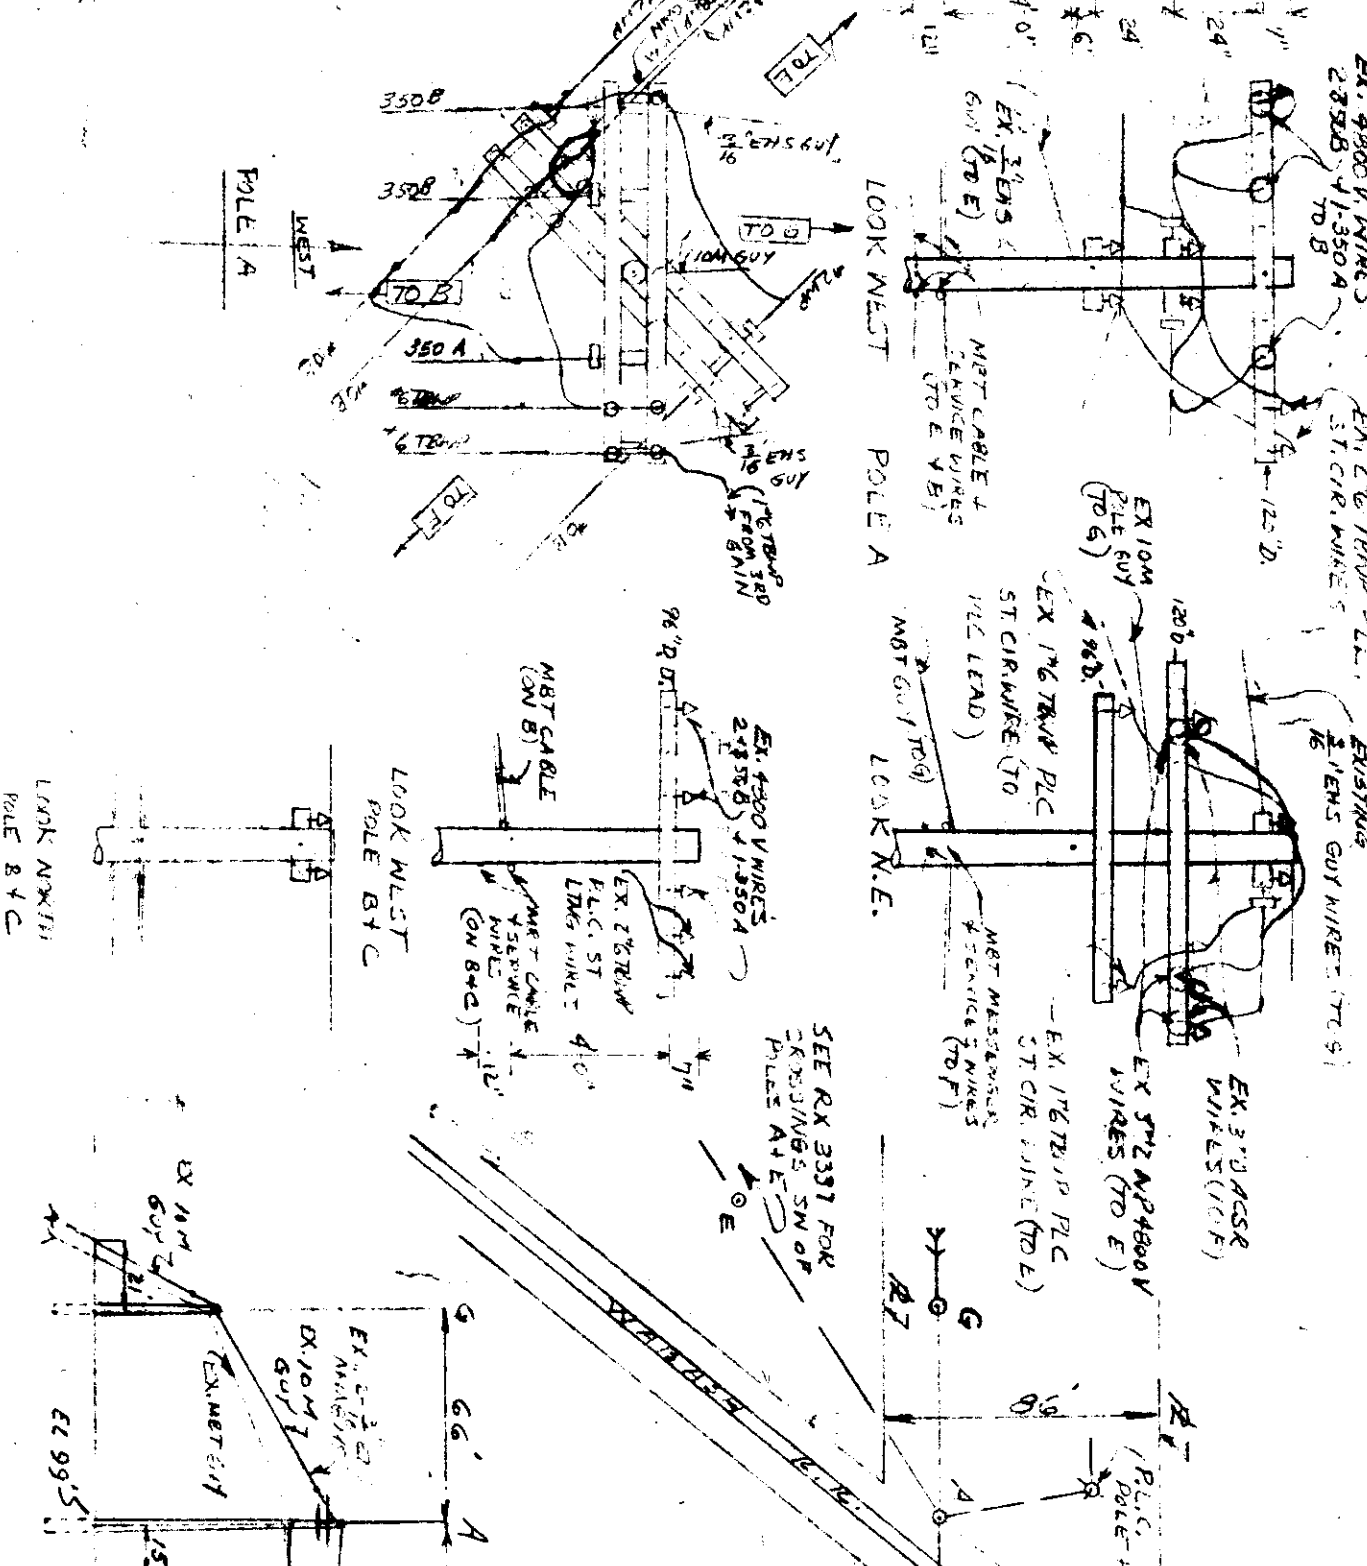

ELEVATION LOOKING NORTH

THE DETROIT EDISON COMPANY

2000 SECOND AVENUE

DETROIT 26, MICHIGAN

May 4, 1961

1961 MAY 9 PM 12 32

REAL ESTATE AND
RIGHTS-OF-WAY DEPT.

Permit No. ED2-8-4819

Michigan Public Service Commission
Lansing 13, Michigan

Gentlemen:

I, Ivan Gamble Supervisor of Rights of Way
of The Detroit Edison Company, Detroit, Michigan, hereby certify that the
wire crossing, covered by Wire Crossing Permit No. ED2-8-4819,
issued 2-3-61, has been constructed in accordance with
specifications of the Michigan Public Service Commission and construction
standards of The Detroit Edison Company, approved by Michigan Public Service
Commission on July 19, 1939, file ED 2-9.01, and that this crossing will be
maintained as provided in such specifications and construction standards.

Yours very truly,

Ivan Gamble
I. W. Gamble
Supervisor of Rights of Way
Real Estate and Rights of Way Department

RX No. 11708

Location City of Detroit,

County of Wayne

Railroad Wabash Railroad

Subscribed and sworn to before me this
4th day of May, 1961.

Summit S. Hadden
Notary Public, Oakland
County, Michigan.

My Commission expires 10-28-62

In Mellon Ave. approx. 320' W. of
the South Dix Ave. c/l. (Span B-C)

34637
111

RECEIVED
FEB 2 1961
MICHIGAN PUBLIC SERVICE
COMMISSION

THE DETROIT EDISON COMPANY

2000 SECOND AVENUE
DETROIT 26, MICHIGAN

January 31, 1961

1961 FEB 7 AM 9 44
REAL ESTATE AND
RIGHTS-OF-WAY DEPT.

Michigan Public Service Commission
Lansing 13, Michigan

Gentlemen:

The Detroit Edison Company, Detroit, Michigan, hereby makes application for authority to string the following wires over the tracks of the Wabash Railroad in the City of Detroit, Wayne County, Michigan.

Span B-C

Three 350M bare 4800 volt wires over the track of the Wabash R.R. located in Mellon Ave. approximately 320' west of the South Dix Avenue center line.

Foreign Wires: City of Detroit Public Lighting Commission two #6 TBWP street circuit wires and Michigan Bell Telephone Company cable (1) and service wires (2).

2 1961
Adm.

The proposed wire crossing will be constructed in accordance with specifications of the Michigan Public Service Commission and the construction standards of The Detroit Edison Company, approved by the Michigan Public Service Commission on July 19, 1939, File ED 2-9.01.

- Enclosed is a waiver of hearing granted by the Railroad Company.
- Waiver of hearing by the Railroad Company is covered by blanket waiver.
- This application covers reconstruction of existing crossing and will cancel and supersede wire crossing permit No. ED 2-8-1960 dated 8-6-47.
- This is a new crossing.

Reference number of construction drawing is RX-1170B.

Yours very truly,

I. W. Gamble

I. W. Gamble
Supervisor of Rights of Way
Real Estate and Rights of Way Dept.

Permit No. ED2-8-4819

Date 2-3-61

By *F. M. Hoppe*

Check in circle indicates statement applicable.

RECEIVED BY THE CITY OF DETROIT MAY 10 1961 34637

THE DETROIT EDISON COMPANY

2000 SECOND AVENUE
 DETROIT 26, MICHIGAN

November 13, 1964

Michigan Public Service Commission
 Lansing 13, Michigan

Gentlemen:

The Detroit Edison Company, Detroit, Michigan, hereby makes application for authority to string the following wires over the tracks of the Wabash Railroad in the City of Detroit, Wayne County, Michigan.

(Span F-B)

One 3/16" extra heavy steel guy wire over the tracks of the Wabash Railroad located in private property at a point approximately 460' west of the centerline of South Dix Avenue and 60' north of the centerline of Mellon Avenue.

MICHIGAN PUBLIC SERVICE COM. M.	
PUBLIC UTILITIES DIVISION	
Tel. _____	Gas _____
Elec. _____	R & S _____
SEP 1 1965	
Adm. _____	_____
File _____	_____

The proposed wire crossing will be constructed in accordance with specifications of the Michigan Public Service Commission and the construction standards of The Detroit Edison Company, approved by the Michigan Public Service Commission on July 19, 1939, File ED 2-9.01.

- Enclosed is a waiver of hearing granted by the Railroad Company.
- Waiver of hearing by the Railroad Company is covered by blanket waiver.
- This application covers reconstruction of existing crossing and will cancel and supersede wire crossing permit No. _____ dated _____
- This is a new crossing.

Reference number of construction drawing is RX-1170C

Yours very truly,

Permit No. ED2-8-5603
 Date 9-1-65
 By [Signature]

[Signature]
 I. W. Gamble
 Supervisor of Rights of Way
 Properties and Rights of Way Dept.

Check in circle indicates statement applicable.

RECORDED RIGHT OF WAY NO. 34637