

APPLICATION FOR RIGHT OF WAY

DE 963-0811 5-7455 (MS 80)

PLEASE SECURE RIGHT OF WAY AS FOLLOWS:

Oct. 9, 1985

DATE

LOCATION 1990 Auburn

APPLICATION NO. O-8081

Auburn and Dequindre

DEPT. ORDER NO. A-64930

CITY OR VILLAGE City of Rochester Hills

O. F. W. NO.

TOWNSHIP Avon COUNTY Oakland

BUDGET ITEM NO.

DATE BY WHICH RIGHT OF WAY IS WANTED October 7, 1985

INQUIRY NO.

THIS R/W IS % OF TOTAL PROJECT NO. ACCUM. %

JOINT RIGHT OF WAY REQUIRED YES NO

NOTE: Identify on print or sketch the subdivisions as to section location and liber and page.

KIND AND DESCRIPTION OF RIGHT OF WAY REQUESTED Commercial Feeders not in same trench

(See sketch) legal description attached.

Easements as indicated on sketch.

PURPOSE OF RIGHT OF WAY To serve 1990 Auburn (present) and 1970 Auburn (in future)

RECORDED RIGHT OF WAY NO. 35874

SIGNED David A. Foley /Supervisor

Oakland Division Headquarters Service Planning

REPORT OF REAL ESTATE AND RIGHTS OF WAY DEPT.

Joint Underground recorded right-of-way secured as shown on the attached sketch.

Contacts by W. Touchie, Real Estate, Rights of Way & Claims - Oakland Division.

Ser.Pl. 1 PERMITS IN RECORD CENTER 1 R.E. & R/W DEPT. FILE GRANTOR Pearco Incorporated Phillip H. Cohen, President

NO. OF PERMITS 1 NO. OF STRUCTURES NO. OF MILES PERMITS TO MBT 1

DATE 11-4-85 SIGNED James D. McDonald James D. McDonald

10-8-85 WD 11-8-85

QUIT CLAIM DEED
STATUTORY FORM

LIBER 8591 PAGE 296

84

13781

KNOW ALL MEN BY THESE PRESENTS: That Bruce H. Pearson and Diana J. Pearson, his wife and Philip H. Cohen and Eileen E. Cohen, his wife whose address is 723 Miller Street, Rochester, Michigan 48063

Quit Claim to Pearco Incorporated

whose street number and postoffice address is 723 Miller Street, Rochester, Michigan 48063

the following described premises situated in the Township of Avon County of Oakland and State of Michigan, to-wit:

Lots 1888 through 1894 inclusive, Supervisors Plat of Brooklands Park Subdivision No. 4, as recorded in Liber 28, Page 49 Oakland County Records

#15-36-229-052 - lots 1888-1893

#15-36-229-028 - lot 1894

28049

OAKLAND COUNTY 227381
STATE OF MICHIGAN REAL ESTATE TRANSFER TAX
Dept. of Taxation JAN 26 '94
PB. 10548
= 22.55

84 FEB - 8 13:15

RECORDED RIGHT OF WAY NO. 35874

MAKE YOUR REAL ESTATE TRANSFERS SAFE BY USING BURTON TITLE INSURANCE

together with all and singular the tenements, hereditaments and appurtenances thereunto belonging or in anywise appertaining, for the sum of [REDACTED]

Dated this 24th day of August 1983

Signed in the presence of:

Signed by:

Ralph H. Nelson, Jr.
Judith A. Gray

Bruce H. Pearson
Diana J. Pearson
Philip H. Cohen
Eileen E. Cohen

STATE OF MICHIGAN ss. COUNTY OF Oakland

3.00
22.55

The foregoing instrument was acknowledged before me this 24th day of August

19 83 by Bruce H. Pearson and Diana J. Pearson, his wife and Philip H. Cohen and Eileen E. Cohen, his wife

My Commission expires February 10, 19 87

Ralph H. Nelson, Jr. Notary Public, Oakland County, Michigan

When Recorded Return To: Bruce H. Pearson 723 Miller Street Rochester, Michigan 48063	Send Subsequent Tax Bills To: Bruce H. Pearson 723 Miller Street Rochester, Michigan 48063	Drafted by: Ralph H. Nelson, Jr. Attorney at Law Business Address 3158 S. Rochester Rd. Rochester, Michigan 48063
--	---	---

Tax Parcel # _____ Recording Fee _____ Revenue Stamps _____

BURTON ABSTRACT AND TITLE COMPANY HAS OPERATED CONTINUOUSLY SINCE 1866

11/36

7

S

N.E. COR
 SEC 36
 T.3N. R.1E

DEQUINDEE AVE. 100' WD.

RECORDED RIGHT OF WAY NO. 35874

RETURN TO
 J. D. McDONALD
 THE DETROIT EDISON COMPANY
 30400 TELEGRAPH ROAD, 264 OAKDH
 BIRMINGHAM, MICHIGAN 48010


10-28-85

LIBER 9176 PAGE 629

LIBER 9176 PAGE 628

AUBURN AVE 100' WD

HESEL AVE. 60' WD.

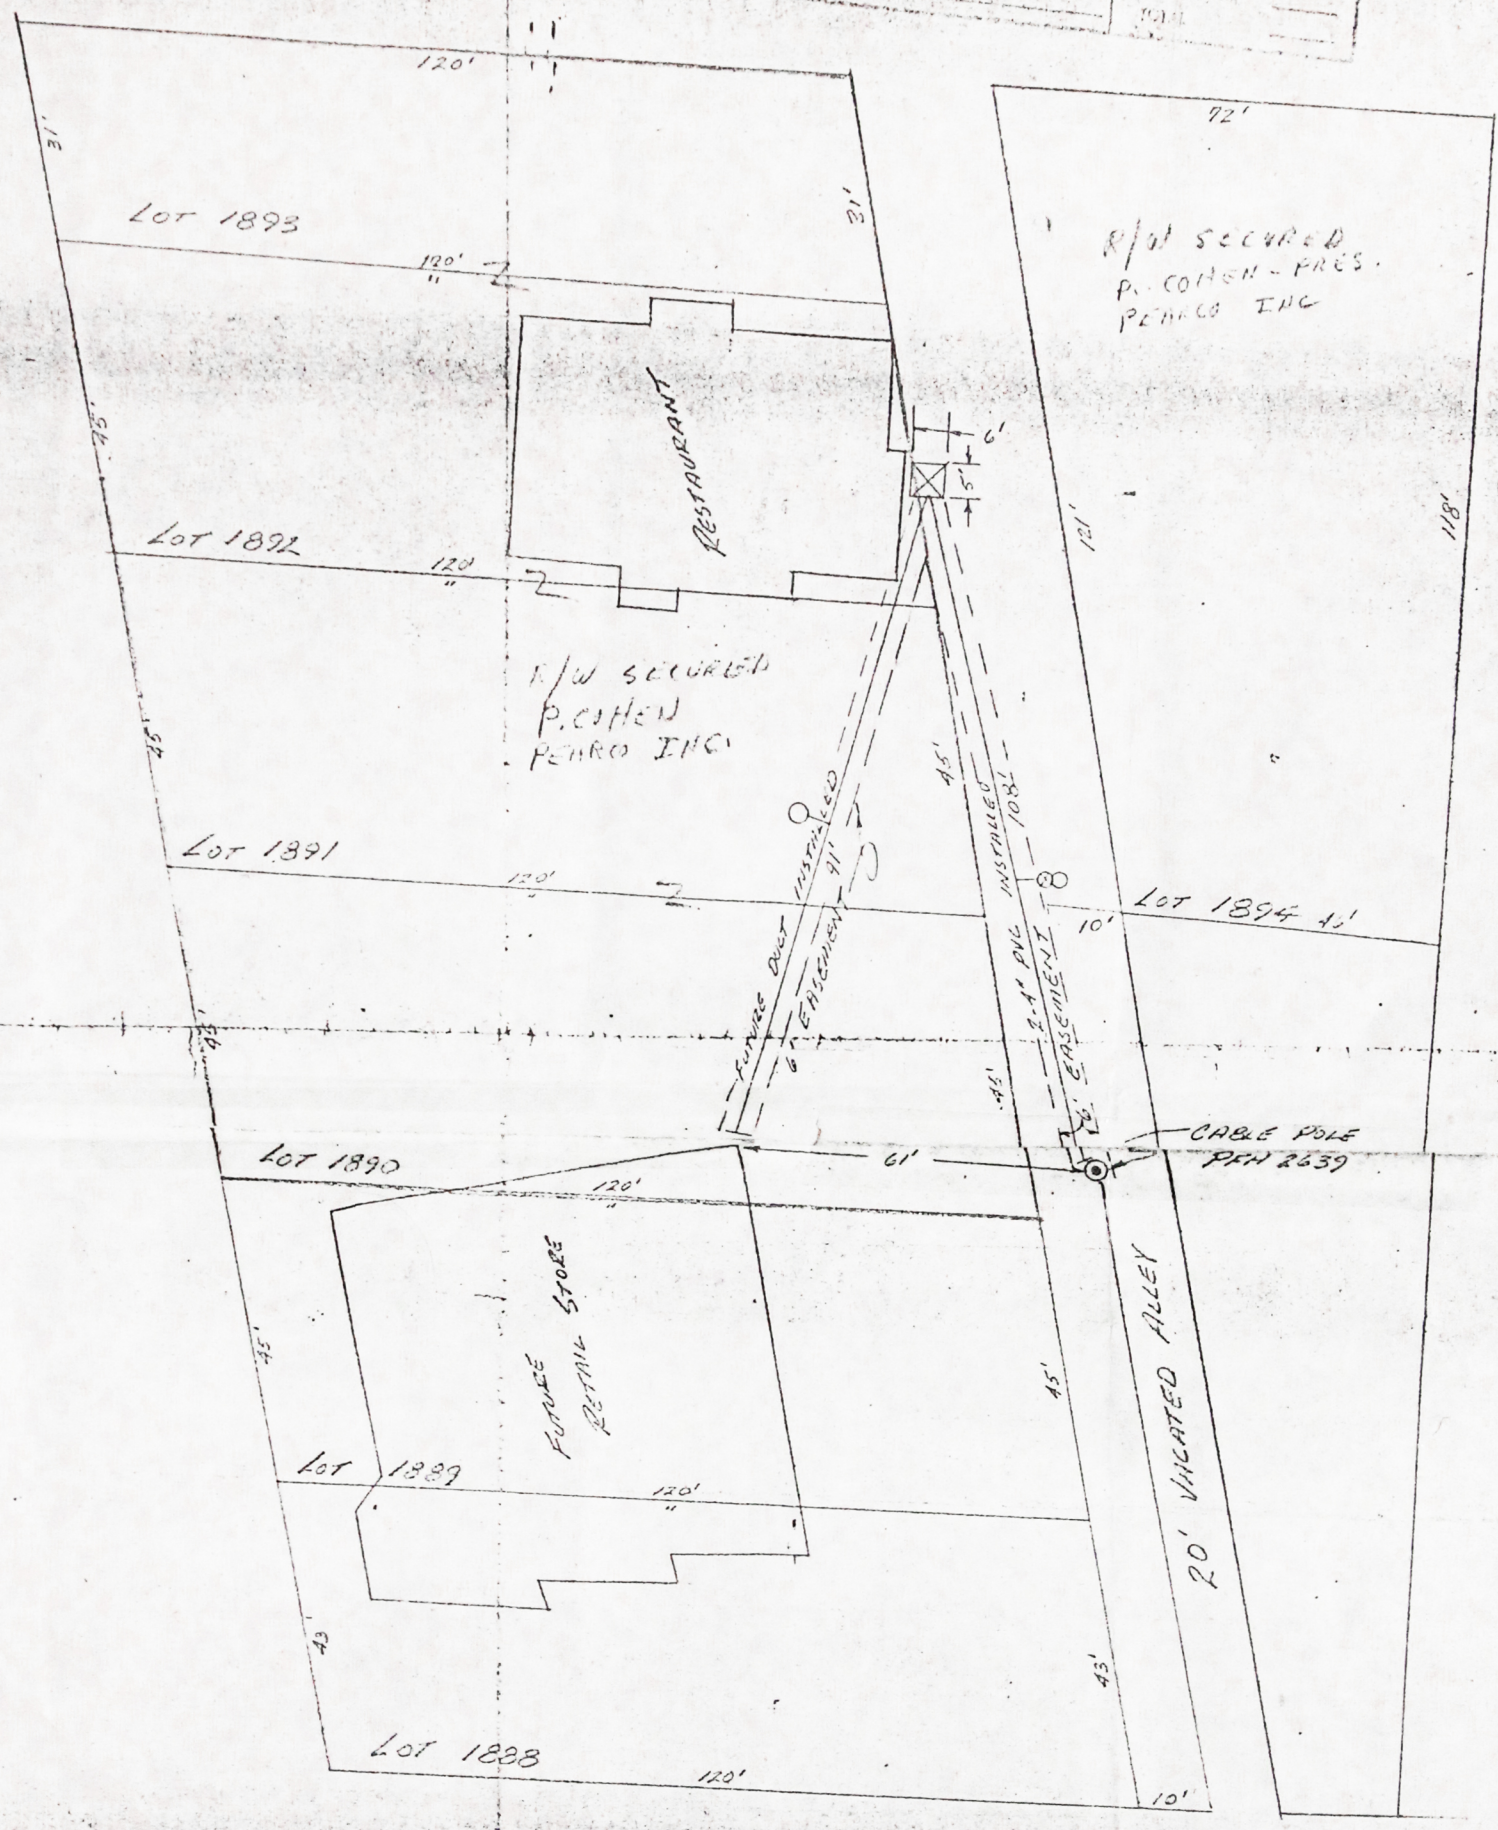

OWNER
 PEARCO INC
 40 PHILLIP COHEN - PRES.
 723 MILLER
 ROCHESTER, MN. 55903
 541-5100 / 652-7691

RETURN TO
 J. D. McDONALD
 THE DETROIT EDISON COMPANY
 30400 TELEGRAPH ROAD, 264 OAKDH
 BIRMINGHAM, MICHIGAN 48010

Recorded Liber & Page
 L 23 P 49 - NON TWP
 OAKLAND Co
 Lot Nos. 1888, 1889, 1890, 1891,
 1892, 1893, 1894
 PORTION OF VACATED ALLEY


LEGEND		THE DETROIT EDISON COMPANY - SERVICE PLANNING DEPARTMENT		
(○)	FOREIGN POLE	CITY OR TWP	COUNTY	QTR. & TWP. SECT. NO.
(○)	EXIST. D.E. CO. POLE	Rochester	Oakland	E1/2 OF NE 1/4
(○)	PROPOSED POLE	MAP SECT.	TOWN	RANGE
(○)	EXIST. ANCHOR	1-33-416	T3N	R1E
(○)	PROPOSED ANCHOR	PROJECT NAME	TEL. ENG'R. & DIST.	JOINT R/W REQUIRED
(○)	TREE	CHICKEN SHACK	M. NARCOLNY P.C.E.	YES <input checked="" type="checkbox"/> NO <input type="checkbox"/>
(○)	120/240 V. LINE	CIRCUIT	O.F.W. S.O. OR P.E.	
(○)	4800 V. LINE	D.C. 8842 SPARK	BUDGET ITEM NO.	
(○)	13,200 V. LINE	REASON	RECORD C.F. DUCT NOT IN SAME TRENCH	
(○)	40,000 V. LINE	PLANNER	REED	SCALE 1"=20'
				DATE 10-2-85

1"=20'

N.E. COR
SEC 36
T.3N, R.1E

DEQUINDEE AVE. 100' WD

DATE	10-28-95
BY	
CHECKED	
APPROVED	

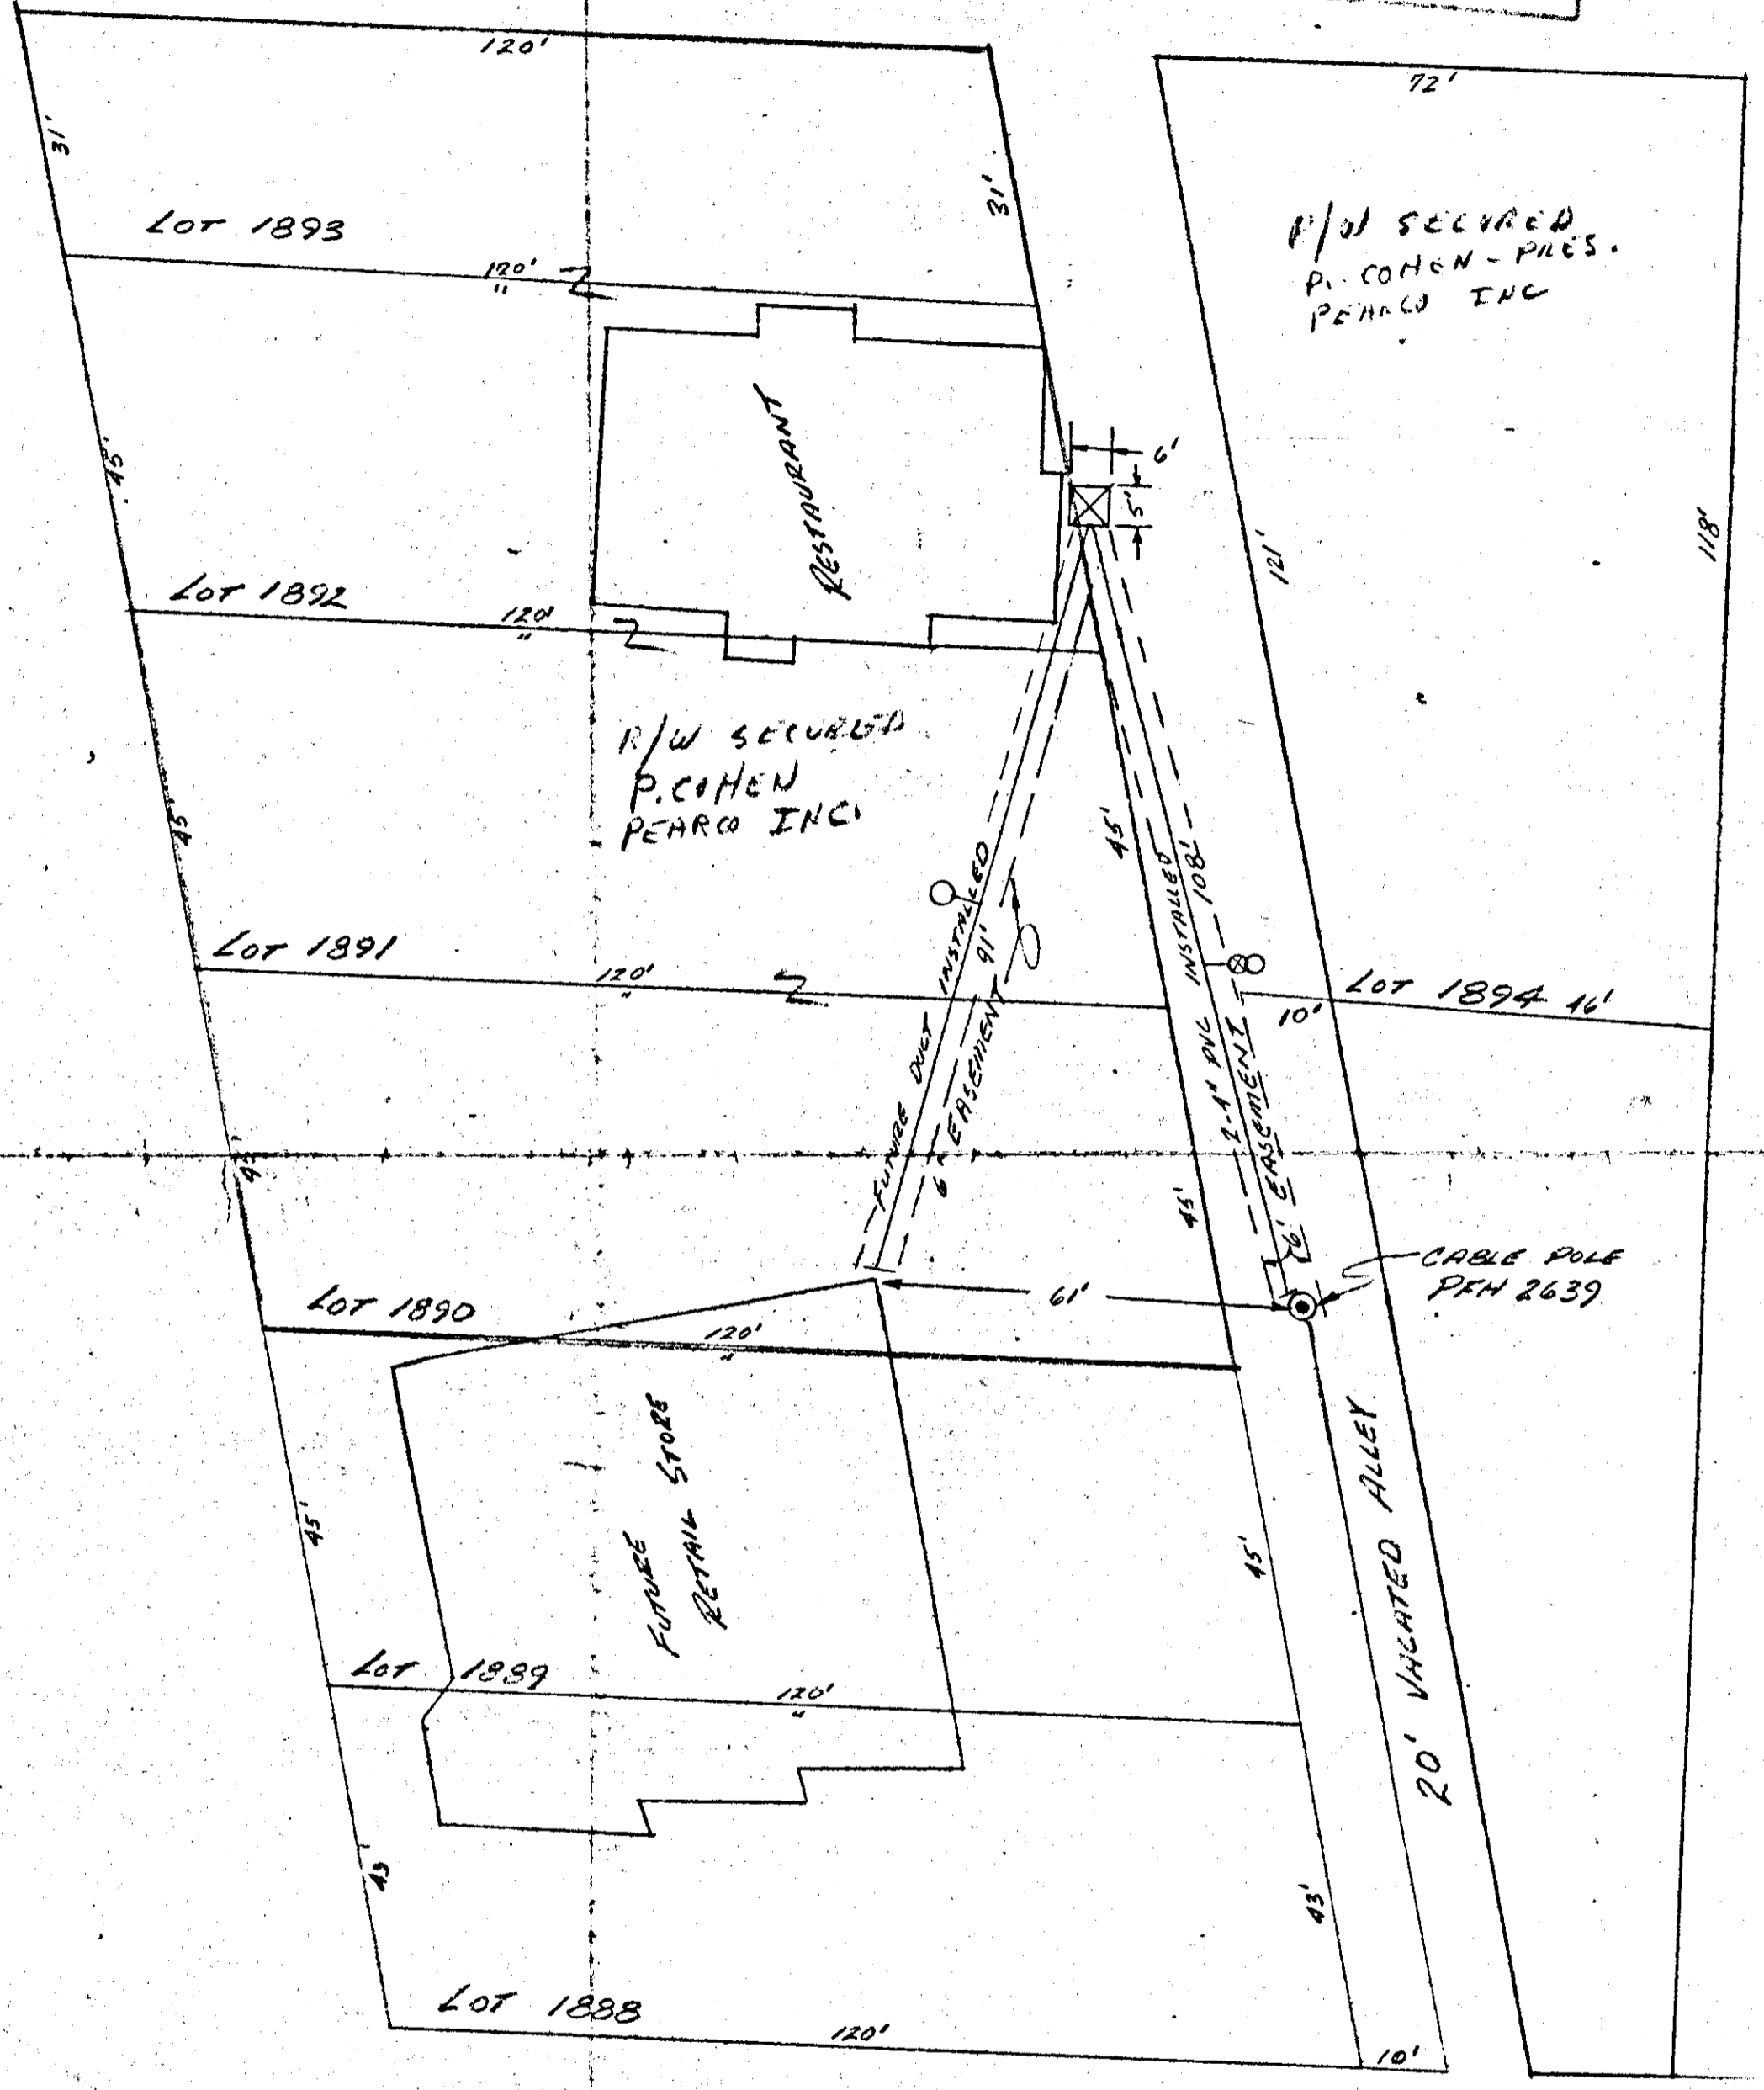

OWNER

PEARCO INC
 40 PHILLIP COHEN - PRES.
 723 MILLER
 ROCHESTER, MI. 48063
 641-5100/652-7691

HESSEL AVE. 60' WD.

RECORDED RIGHT OF WAY 35874

RECORDED LIBERTY PAGE
 L 23 P 49 - AVON TWP
 OAKLAND CO
 Lot Nos. 1888, 1889, 1890, 1891
 1892, 1893, 1894 PCHS
 PORTION OF VACATED ALLEY

DATE	
BY	
CHECKED	
APPROVED	

LEGEND		THE DETROIT EDISON COMPANY - SERVICE PLANNING DEPARTMENT			
○	FOREIGN POLE	CITY OR TWP	COUNTY	QTR. & TWP. SECT. NO.	DEPT. ORDER NO.
○	EXIST. D.E. CO. POLE	ROCH. HILLS	OAKLAND	E. 120 OF NE 54	464930
●	PROPOSED POLE	MAP SECT.	TOWN	RANGE	JOINT R/W REQUIRED
○	EXIST. ANCHOR	1-331-416	T3N	R1E	YES <input checked="" type="checkbox"/> NO <input type="checkbox"/>
○	PROPOSED ANCHOR	PROJECT NAME	TEL. ENGR. & DIST.	R/W NO.	PROJ. OR PART NO.
○	TREE	CHICKEN SANK	M. NALDOOLNY POE	0	8091
—	120/240 V LINE	CIRCUIT		O.F.W. S.O. OR P.E. NO.	
—	4800 V LINE	DC. BEAZ SPARKS			
—	13,200 V LINE	REASON		BUDGET ITEM NO.	
—	40,000 V LINE	RECORD C.F. DUCT NOT IN SAME TRENCH			
		PLANNER	REED	SCALE	1"=20'
				DATE	10-2-95

RECORDED RIGHT OF WAY NO. 35874

35874