RECORDED RIGHT OF WAY NO

Detroit Edison

Real Estate and Rights of Way

Överhead Right of Way Agreement-Self Locating

For good and valuable consideration of system betterment, the undersigned hereby grant and convey to THE DETROIT EDISON COMPANY, a Michigan corporation of 2000 Second Avenue, Detroit, Michigan, herinafter

/	October	13+h	10 88
*	occoper	エンにロ	. 19 💛

facilities consisting of	poles, guys, anchors, wire	s, cables, transformers an	to, operate and maintain overhead line ad accessories required to provide electric
	, County of	<u>Livingston</u>	of
as follows: A twelve (12)	foot wide easement a	s described on Detro	oit Edison Drawing AS-6549,
dated 9/15/88	attached hereto and	made a part hereof,	over and across and under the
following des	cribed land: Part of	the Northeast ¼ of	Section 25 and part of the
Southeast % or described as: E 175.00 feet of Ten Mile Refeet; thence we 442.00 feet thence S 01°3 wide); thence and distances the arc of sa 6°13'20" and East line of 72.90 feet to 73.30 feet to feet to the E we line, Section along the Net 175.00 feet; private driver	f Section 24, T1N, R6 Commencing at the N along said North lin oad), to the Point of S 01°30' E 442.00 fee ; thence N 87°10'15" 0' E 36.7 feet to the along said Southerly , N 82°59'25" E 1149. id curve to the left a chord bearing N 79° said Section 24, (sai the Northeast corner the Northwest corner ast % corner of said on 25, 2680.70 feet t orth/South % line of thence N 01°29'18" W way easement over the	E, Green Oak Townsh orth % corner of same of Section 25, (so Beginning; thence of; thence N 87°10'1' E along said North Southerly right-of right-of-way line 60 feet to a point of having a radius of 52'45" E 201.41 feed line also being the of said Section 25; thence so the center of said Section 25, 20'543.00 feet to the East 66 feet of the said Section 25; thence said Section 25, 20'543.00 feet to the said Section 25, 20'543.00 feet 30'543.00 feet 3	ip, Livingston County, Michigan, id Section 25; thence N 87°10'15" aid line also being the centerline continuing N 87°10'15" E 562.54 5" E 412.00 feet; thence N 01°30' line of Section 25, 193.00 feet; -way line of Ten Mile Road (66' the following two (2) bearings of curve and 201.50 feet along 1856.30 feet, a central angle of t; thence S 01°08'10" E along the he centerline of Dixboro Road),; thence continuing S 01°08'10" E, R7E; thence S 01°25'10" E 2587.7 S 88°04'15" W along the East/West d Section 25; thence N 01°29'18" 75.80 feet; thence N 87°10'15" E Point of Beginning, subject to a e West 241.00 feet, of the North Section 25. Also subject to the

Upon installation of said line facilities, the width of the right of way granted herein shall be limited to <u>Twelve (12)</u> feet, the centerline of which shall be the line as installed and in addition a strip of land five feet wide for guy wires and anchors installed.


over the Northerly part as used for Ten Mile right-of-way.

rights of the public over the Easterly part as used for Dixboro Road right-of-way and

The rights hereby granted include the right of access to and from the right of way and the right to trim, cut down or otherwise control brush and trees within the right of way or on property adjoining the right of way which in the opinion of Edison interferes with the construction or operation of the line facilities. It is expressly understood and agreed that Edison shall, at no time, trim or cut down any trees unless, in Edison's opinion, it is absolutely necessary to do so. Edison shall restore premises to its original condition or as near as can be in the event of damages caused by its employes, contractors, vehicles and equipment entering premises for the purposes set forth herein. No buildings or structures are to be placed within said right of way herein granted without consent of the GRANTEE. This grant is declared to be binding upon the heirs, successors, lessees, licensees and assigns of the parties hereto.

IN WITNESS WHEREOF, the undersigned have hereunto set their hand(s) on the date of this agreement.

Witnesses:	RECORDED	Grantors:
Daniel E. Yoder	OCT 18 2 47 PN 1	GREENOCK HILLS DEVELOPMENT CO., A Michigan Corporation
Janice M. Schoenherr	REGISTED COUNTY.	MIJAMES W. PELKY, President
Prepared by:		Address: 10087 Colonial Industrial Drive
425 S. Main Ann Arbor, MI 48107		South Lyon, MI 48178

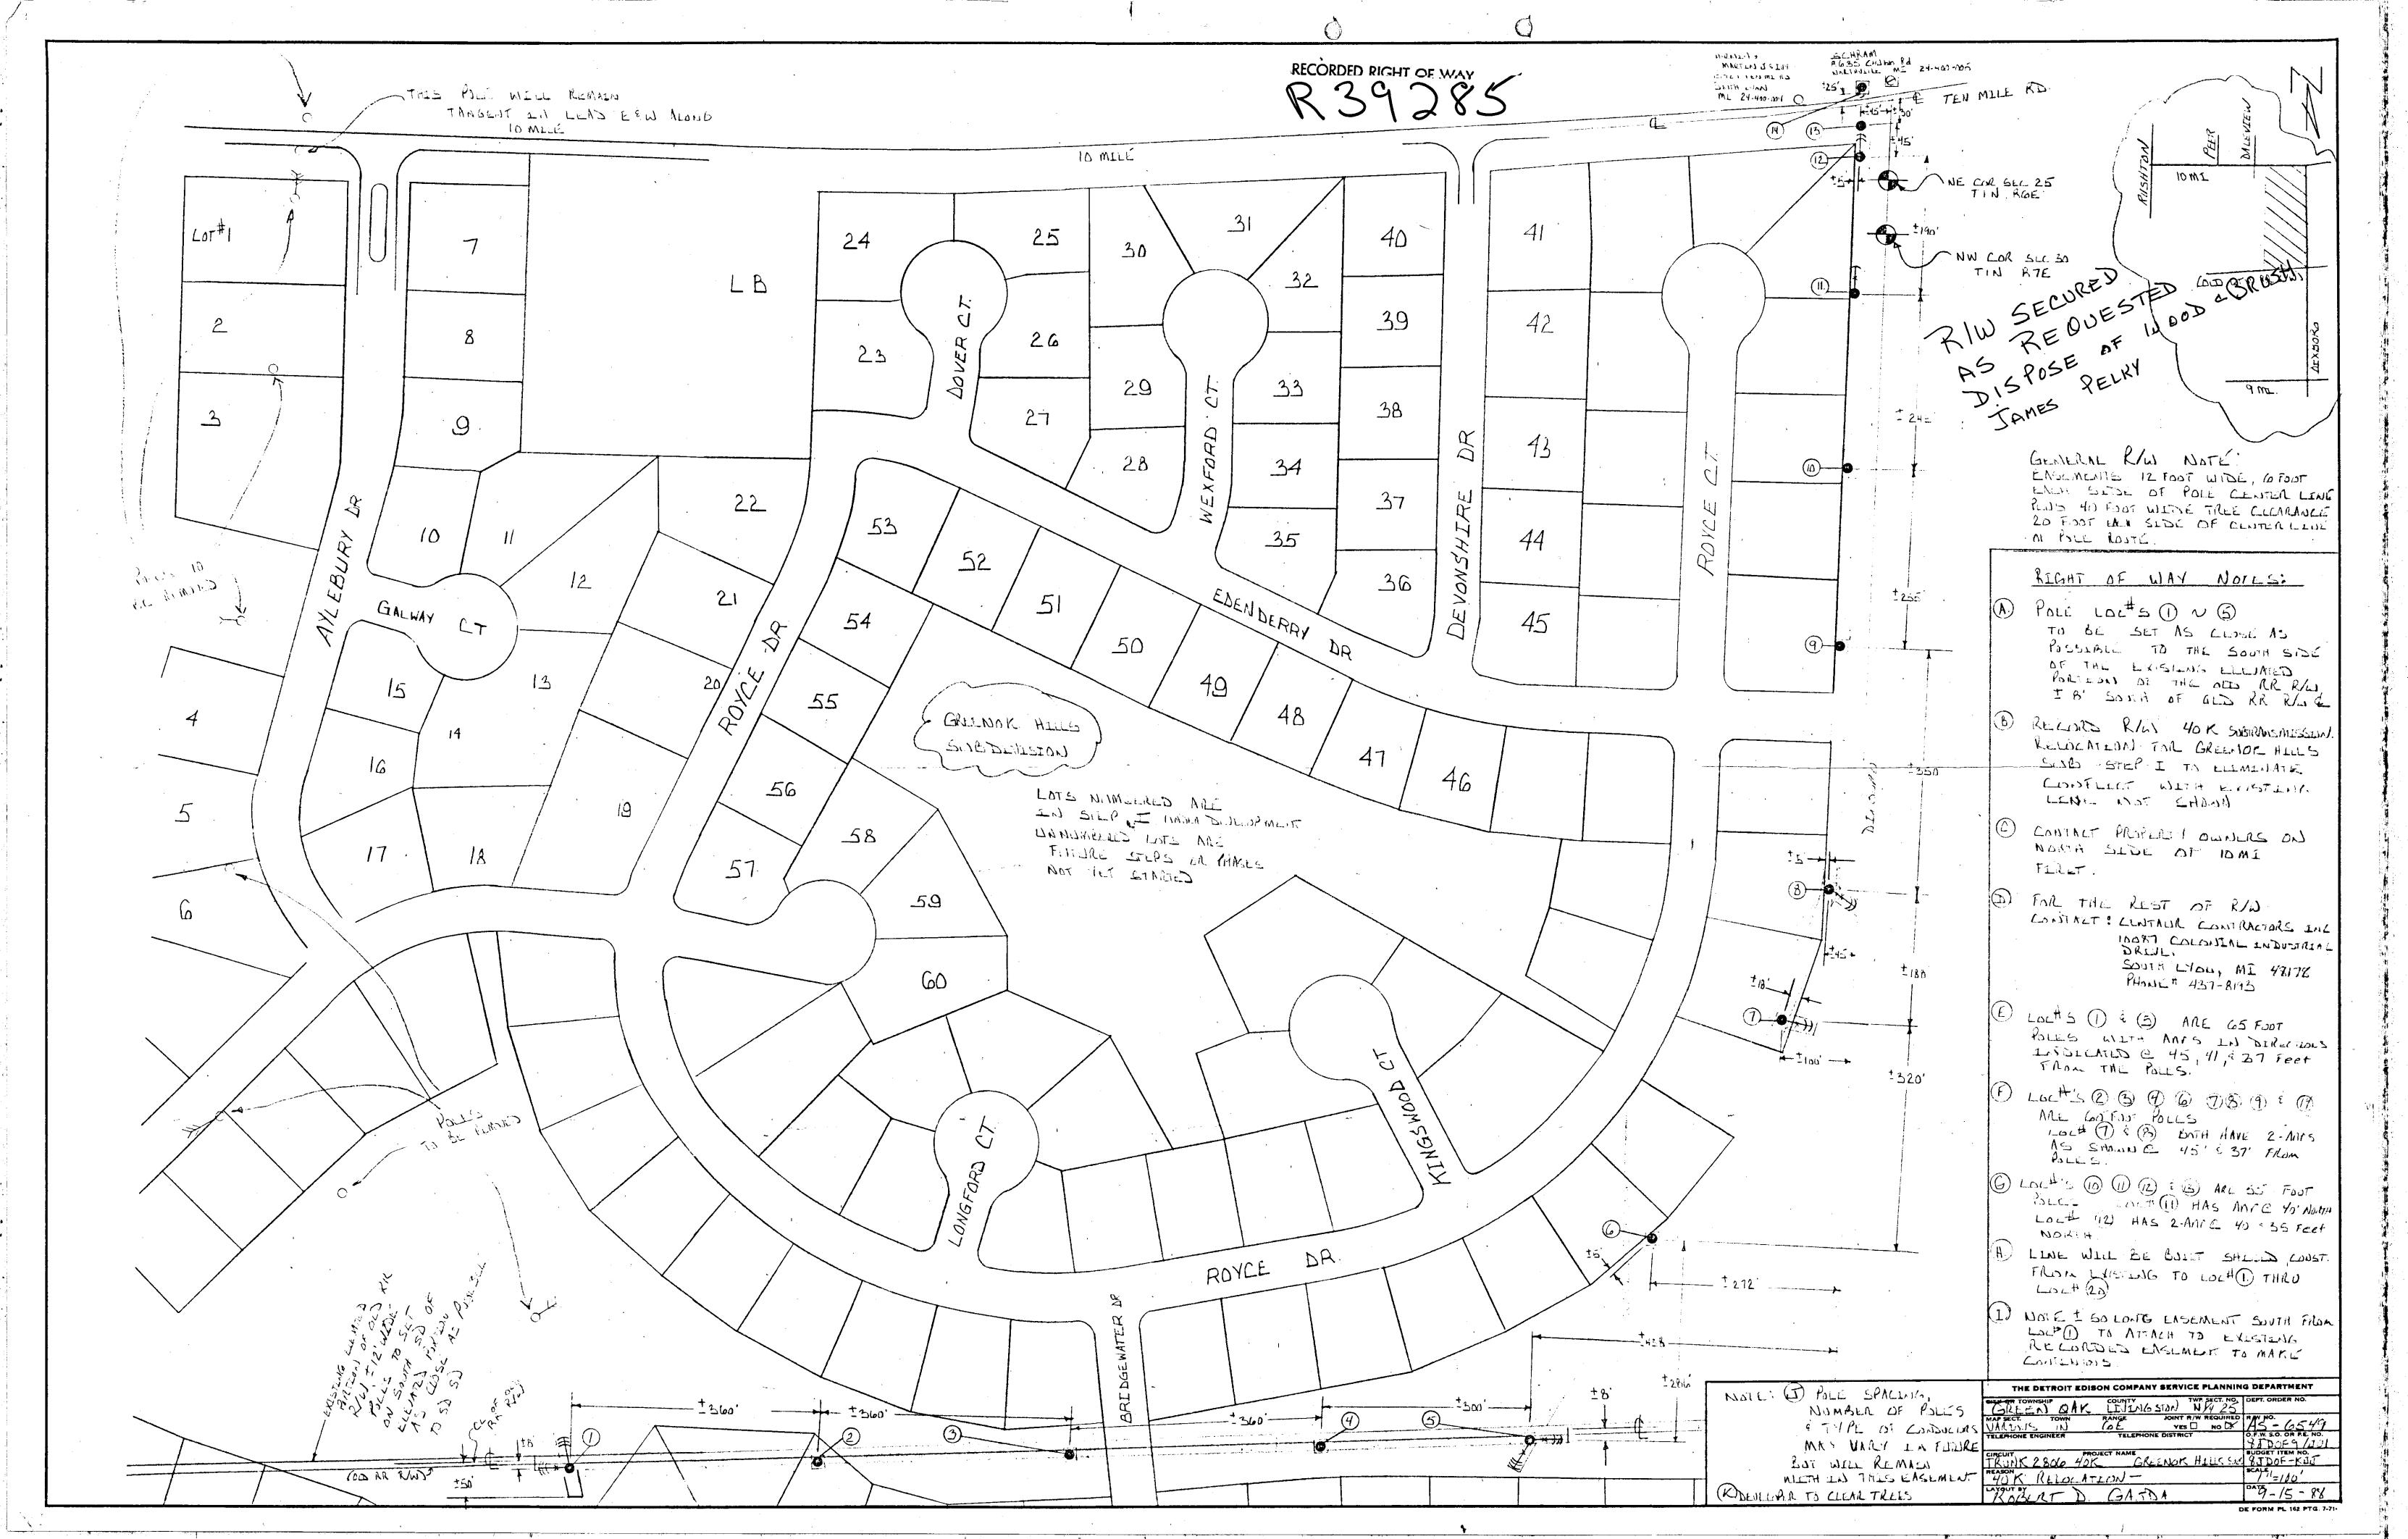

R39285

RECORDED RIGHT OF WAY NO.