

APPLICATION FOR RIGHT OF WAY

OR 803-0815 8-7488 (MAY 80)

PLEASE SECURE RIGHT OF WAY AS FOLLOWS:

LOCATION 1077 SOUTH HILL

DATE 9-12-90

APPLICATION NO. 0-1022

DEPT. ORDER NO. NONE

CITY OR VILLAGE \_\_\_\_\_

O. F. W. NO. \_\_\_\_\_

TOWNSHIP MILFORD COUNTY OAKLAND

BUDGET ITEM NO. \_\_\_\_\_

DATE BY WHICH RIGHT OF WAY IS WANTED ASAP-WAITING FOR SERVICE NOW

INQUIRY NO. \_\_\_\_\_

THIS R/W IS \_\_\_\_\_ % OF TOTAL PROJECT NO. \_\_\_\_\_ ACCUM. \_\_\_\_\_ %

JOINT RIGHT OF WAY REQUIRED YES  NO

NOTE: Identify on print or sketch the subdivisions as to section location and liber and page.

KIND AND DESCRIPTION OF RIGHT OF WAY REQUESTED RECORDED U.G. EASEMENT

PURPOSE OF RIGHT OF WAY SECONDARY SERVICE TO 300 BENSFIELD

RECORDED RIGHT OF WAY NO. 41088

SIGNED D. M. Cassidy  
240 O.D.H.Q. OFFICE OAKLAND SERVICE PLANNING DEPARTMENT

REPORT OF REAL ESTATE AND RIGHTS OF WAY DEPT.

Right of Way secured as per attached drawing. Contacts made by C. George Williams, Representative, Real Estate, Rights of Way, Oakland Division.

PERMITS IN RECORD CENTER 1 R.E. & R/W DEPT. FILE 1 GRANTOR HALLER

NO. OF PERMITS 1 NO. OF STRUCTURES \_\_\_\_\_ NO. OF MILES \_\_\_\_\_ PERMITS TO MBT 0

DATE 10-29-90 SIGNED James D. McDonald  
James D. McDonald, Sr. Representative

**Detroit Edison**

**Real Estate and Rights of Way  
Underground  
Right of Way Agreement**

LIBER 11653 PG 730

10-12-1990

For good and valuable consideration of system betterment, the undersigned hereby grant and convey to THE DETROIT EDISON COMPANY, a Michigan corporation of 2000 Second Avenue, Detroit, Michigan, hereinafter referred to as "EDISON", the right to construct, reconstruct, modify, add to, operate and maintain underground line facilities consisting of poles, conduits, wires, cables, manholes, transformers and accessories required to provide electric services in, under, upon, over and across property located in the Township of Milford, County of Oakland, State of Michigan, further described as follows:

Part of the NW 1/4, Section 14, T2N., R7E., beg at pt dist N 01° 18'00" E 681 ft & S 88° 50'00" E 990 ft from W 1/4 cor, th N 01° 18'00" E 383 ft, th S 88° 50'00" E 334.20 ft, th S 01° 04'00" W 383 ft, th N 88° 50'00" W 335.76 ft to point of beginning. 2.95 acres.

#

Sidwell No. 16-14-101-033

*Milford*

B#92 REG/DEEDS PAID  
0001 NOV.30 '90 10:56AM  
4222 MISC 9.00

As shown on the attached drawing RW0-1022 dated 9/12/90 which is made a part hereof.

The right of way is 10' (ten) ft. in width.

The rights hereby granted include the right of access to and from the right of way and the right to trim, cut down or otherwise control trees, brush or roots of any kind either within the right of way or on property adjoining the right of way which in the opinion of the EDISON interferes with the construction or operation of the line facilities. It is expressly understood and agreed that EDISON shall, at no time, trim or cut down any trees unless, in the EDISON'S opinion, it is absolutely necessary to do so. EDISON shall restore premises to its original condition or as near as can be in the event of damages caused by its employes, contractors, vehicles and equipment entering premises for the purposes set forth herein.

No buildings or structures are to be placed within said right of way herein granted without the written consent of EDISON.

This grant is declared to be binding upon the heirs, successors, lessees, licensees and assigns of the parties hereto.

IN WITNESS WHEREOF, the undersigned have hereunto set their hand(s) on the date of this agreement

Witnesses:

Grantors:

*Sandra Laine*  
SANDRA LAINE

*Steven F. Haller* 9.00  
Steven F. Haller, A SINGLE MAN

*C. George Williams*  
C. George Williams

O.K. — LM

Prepared by: C. George Williams/lhp  
The Detroit Edison Company  
30400 Telegraph Road, Suite 277  
Birmingham, Mi 48010

Address: 1027 South Hill Road  
Milford, MI 48042

APPROVED AS TO FORM 10/25/90 DATE  
LEGAL DEPARTMENT *[Signature]*

RECORDED RIGHT OF WAY NO

41086

800001

RETURN TO  
J. D. McDONALD  
THE DETROIT EDISON COMPANY  
30400 TELEGRAPH ROAD, 277 OAKDALE  
BIRMINGHAM, MICHIGAN 48010

State of Michigan )  
                          ) SS:  
County of Oakland )

LIBER **116530731**

On this 12<sup>TH</sup> day of OCTOBER, 1990, the foregoing instrument was acknowledged before me, a notary public in and for said county by **STEVEN F. HALLER. A SINGLE MAN**



**C. GEORGE WILLIAMS**  
Notary Public, Oakland County, MI  
My Commission Expires Dec. 2, 1991

My Commission Expires: \_\_\_\_\_

  
C. George Williams  
Notary Public, Oakland County, Michigan

RECORDED RIGHT OF WAY NO. 41086

RETURN TO  
J. D. McDONALD  
THE DETROIT EDISON COMPANY  
80400 TELEGRAPH ROAD, 277 OAKDH  
BIRMINGHAM, MICHIGAN 48010

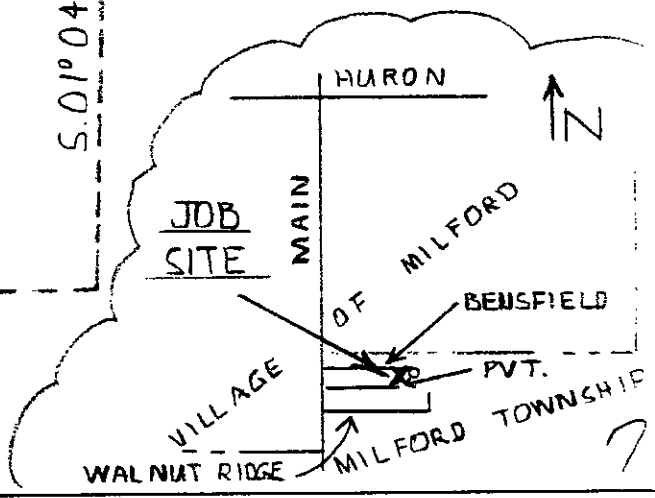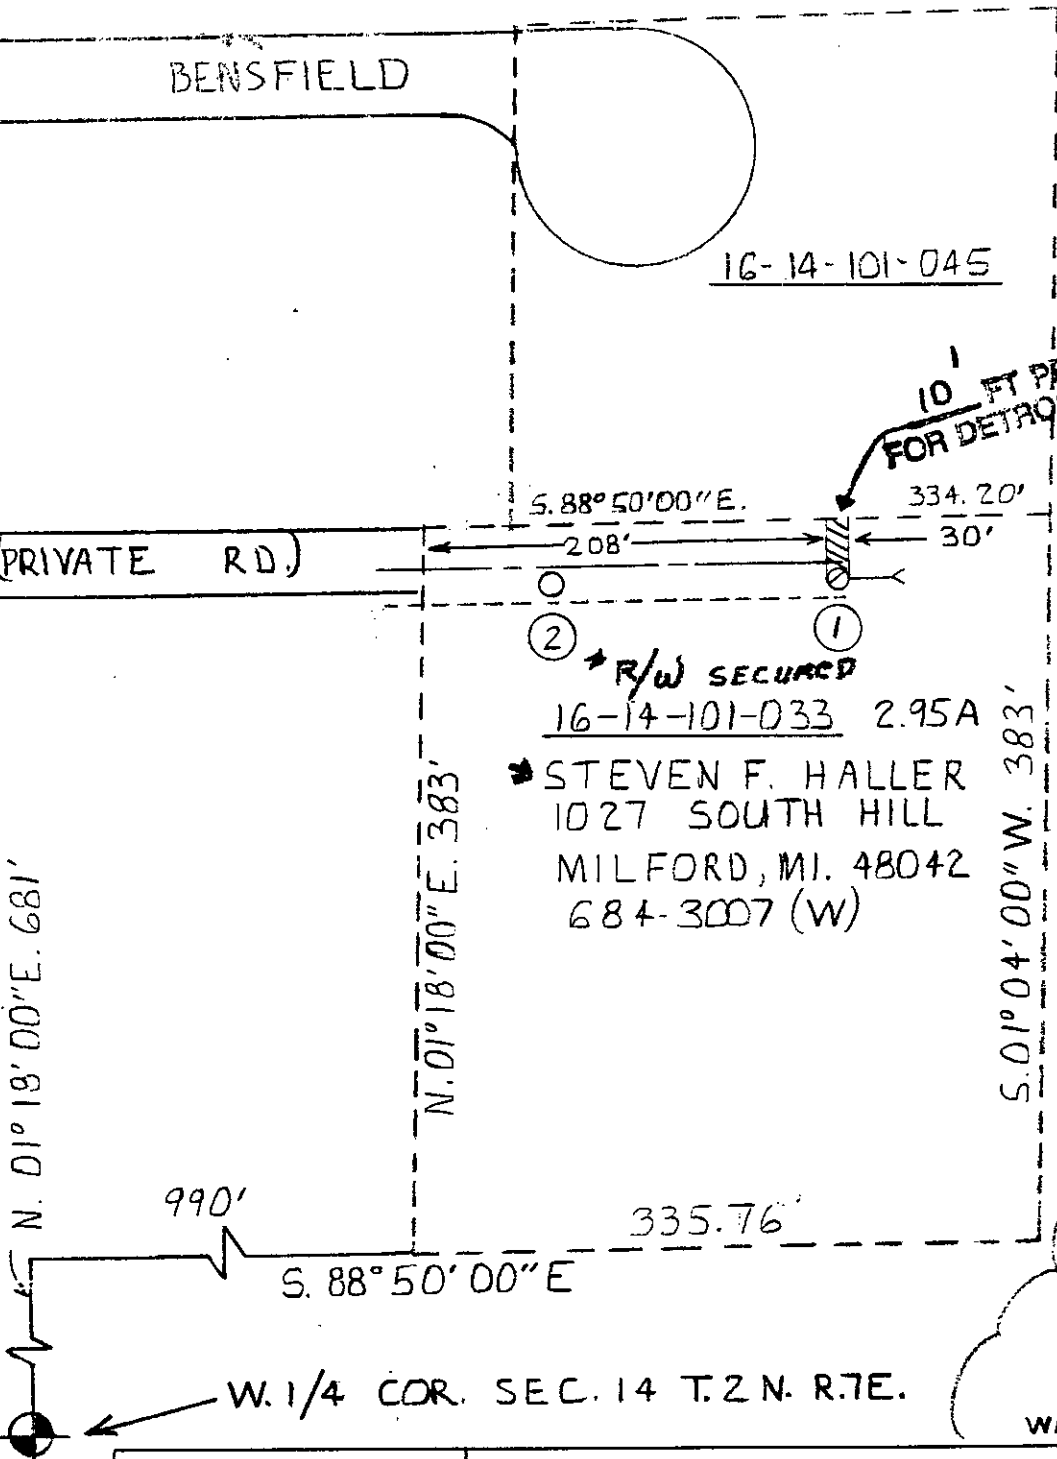

LEGEND	
	FOREIGN POLE
	EXIST D.E. CO. POLE
	PROPOSED POLE
	EXIST ANCHOR
	PROPOSED ANCHOR
	TREE
	120/240 VOLT LINE
	4800 VOLT LINE
	13,200 VOLT LINE
	40,000 VOLT LINE

THE DETROIT EDISON COMPANY-SERVICE PLANNING DEPARTMENT			
CITY OR TOWNSHIP <b>MILFORD</b>	COUNTY <b>OAKLAND</b>	QTR. & TWP. SECT. NO. <b>NW 1/4 14</b>	DEPT. ORDER NO.
MAP SECT. <b>1-196-392</b>	TOWN <b>2N</b>	RANGE <b>7E</b>	R/W NO. <b>0-1022</b>
PROJECT NAME <b>LAING RESIDENCE PAT GRAHAM</b>		TEL ENGR & DIST. <b>G.T.E.</b>	PROJ. OR PART NO.
CIRCUIT <b>7103 MILFORD</b>		JOINT R/W REQUIRED YES <input type="checkbox"/> NO <input checked="" type="checkbox"/>	O.F.W. S.O. OR P.E. NO.
REASON <b>NEW RESIDENCE AT 300 BENSFIELD</b>		PLANNER <b>D.M. CASSIDY 645-4453</b>	BUDGET ITEM NO.
SCALE <b>1" = 100'</b>		DATE <b>9-12-90</b>	DE FORM 963-2237 1-80

RETURN TO  
J. D. McDONALD  
THE DETROIT EDISON COMPANY  
30400 TELEGRAPH ROAD, 277 OAKDH  
BIRMINGHAM, MICHIGAN 48010