RECORDED IN MACOMB COUNTY
RECORDS AT: 9:42 A. M.

OCT 25 1985

CLERK-REGISTER OF DEEDS
MACOMB COUNTY, MICHIGAN

For valuable consideration, the receipt of which is hereby acknowledged, the undersigned hereby grant and convey to THE DETROIT EDISON COMPANY, a corporation organized and existing concurrently under the laws of the States of Michigan and New York, of 2000 Second Avenue, Detroit, Michigan 48226 and the MICHIGAN BELL TELEPHONE COMPANY, a Michigan corporation, of 444 Michigan Avenue, Detroit, Michigan 48226 hereinafter referred to as "UTILITIES", the easement and right to erect, lay, maintain, reconstruct and replace underground facilities consisting of wires, cables, conduits, fixtures and appurtenances including the necessary above ground equipment, connections, poles and accessories which may from time to time be required in, under, upon, over and across the land located in the <a href="City">City</a> of <a href="St. Clair Shores">St. Clair Shores</a>, <a href="Macomb">Macomb</a> County, Michigan, and more particularly described on the attached Appendix "A", with the full right to the UTILITIES of ingress and egress upon said land for the purposes of this grant, and the further right to trim, cut down or otherwise control brush and trees within the easements herein described.

Said easements shall be \_\_\_\_\_\_ feet in width unless otherwise indicated and their route is described as follows: The exact location of said easements will be as shown on a drawing to be recorded within 90 days after construction.

In order to provide for the proper maintenance and protection of UTILITIES, the undersigned covenant and agree that:

- 1. The easements will be graded to within four (4) inches of final grade before the UTILITIES lines are installed and this ground elevation must be maintained after installation of utilities to avoid the pooling of water in, on or around above ground UTILITIES' equipment.
- 2. No buildings or structures other than UTILITIES equipment are to be placed within the easements herein granted. No excavation is to be permitted within said easement without approval of UTILITIES.
- 3. If the lines or facilities of UTILITIES are damaged by the acts of Owners, their agents, employes or contractors, repairs shall be made by the Utility company so damaged at the cost and expense of Owners. Owners are defined as those persons owning the land at the time the damage occurred.
- 4. No shrubs or foliage shall be planted or grown within five (5) feet of the front door of transformers or switching cabinet enclosures. UTILITIES shall not be responsible to Owners for damages to or removal of trees or plant life planted in front of said door or within the easement causing an interference with UTILITIES maintenance of their equipment.

THIS GRANT is declared to be binding upon the heirs, successors, lessees, licenses and assigns of the parties hereto.

IN WITNESS WHEREOF, the undersigned have hereunto set their hand and seal on this date.

Witnesses:

Grantors:

GORDON DEVELOPMENT, INC.

a Michigan Corporation

Michael J. McCabe

RECORDED IN MACOMB COUNTY

RECORDS AT: 2 BY:

Carol A. Wuschack

AUG 23 1991

Ronald J. Urbanczyk

Prepared By: Michael J. McCabe

15600 - 19 Mile Road

Mt. Clemens, Michigan 48044

Mt. Clemens, Michigan 48044

gred

DE 963-4187-10-79 CS (D.E. U.R.D -MBT)

RECORDED RIGHT OF THE NO. TAGE

## CORPORATION

STATE OF MICHIGAN

County of MACOMB

SS

LIBER 051810852
(LIBER 3844 PAGE 513

On this day of	, A.D. 19, before me,
the subscriber, a notary public in and for said County, app	eared Ronald J. Urbanczyk
	he is
to me personally known, who being by me duly sworn did	say that they are the Secretary
	o
GORDON DEVELOPMENT, INC., a Michigan Corporation	n .
and that the seal affixed to said instrument is the corporate sealed in behalf of said corporation by authority of its	
and	
acknowledged said instrument to be the free act and deed	Justil / Tu Cat
	Notary Public, County, Michigan
My commission expires:	MICHAEL 7. MICCABE 3.  Notary Public, Macomb County, MI DE 963-4182 10-79 CS

APPENDIX "A"

CLAIRE POINTE CONDOMINIUMS, PHASE II" Land in the City of St. Clair Shores, Macomb County, Michigan, being Lots 70 through 78 and all of vacated Vogt Avenue lying adjacent to said lots, except that part of Lots 70 and 71 and vacated Vogt Avenue described as follows: Beginning at the Southeast corner of Lot 70, thence along the arc of a curve to the right 235.62 feet to a point on the East line of Lot 77, said arc having a radius of 50 feet; thence South to Southwest corner of Lot 78; thence West to the point of beginning, also all of Lots 112, 113, and 114 also all of Lots 150 through 162 include and all of vacated Vogt Avenue lying adjacent to Lots 157 and 158 of Grove Pointe Gardens Subdivision, Liber 2 on Page 237, Macomb County records.

Date:

September 9, 1991

To:

Records Center MIM

From:

D. R. Sorensen, Supervising Engineer

Division Engineering

Macomb Division

Subject:

Right of Way Agreement for Underground Residential Distribution for Claire Pointe Condominiums, Phase II, located in part of Grove Pointe Gardens Subdivision, Liber 2, Page 237 (M.C.R.), City of St. Clair Shores, Macomb County, Michigan

Attached for Records Center is the executed Right of Way Agreement, dated October 7, 1985, and other pertinent papers for above named project.


Easement for this project was requested by Frank Goettl, Service Planner, Macomb Division. The Agreement was negotiated by Michael J. McCabe, Representative of Real Estate, Rights of Way and Claims, Macomb Division.

Detroit Edison Company and Michigan Bell Telephone Company made this agreement with ronald J. Urbanczyk, Secretary, Gordon Development, Inc., the developers of Claire Pointe Condominiums, Phase II..

Please make the attached papers a part of recorded Rights of Way file.

DRS/caw

Attachment

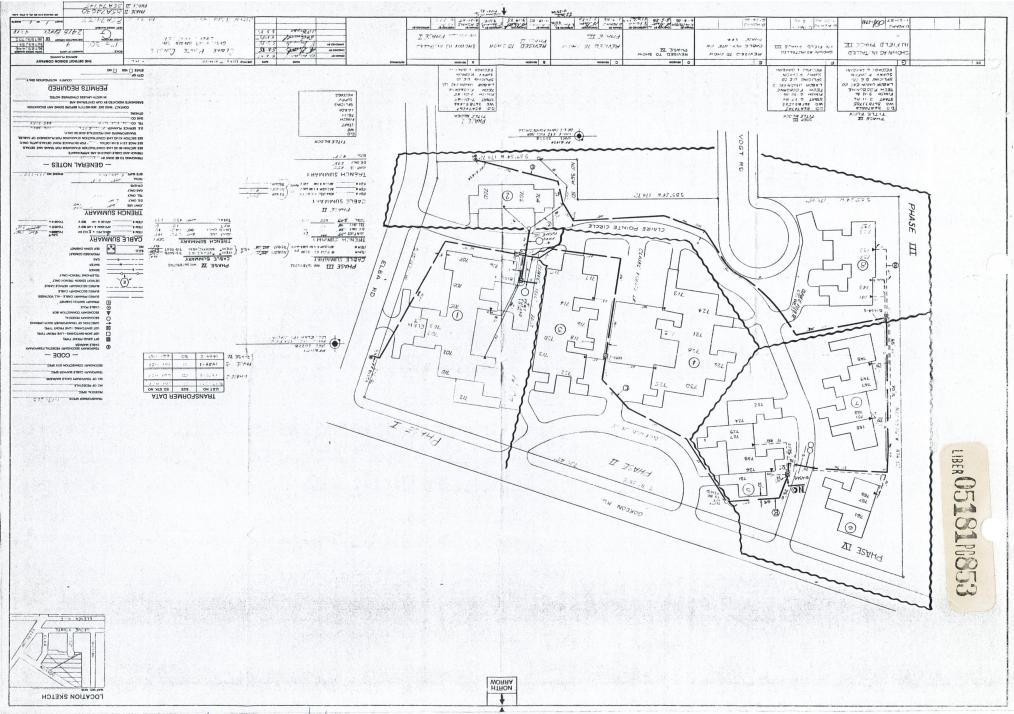

esoction in an action of the composition of the com