## RIGHT RIGHT OF WAY NO


## HURON-CLINTON METROPOLITAN AUTHORITY TREE REMOVAL PERMIT

13) 227-2757 or 1-800-247-2757	November 30	92

V		(313) 227-2757	or 1-800-247-2757	November 20	0.2
Pursuant to the terms and pro	visions of this Pa	rmit normission is hereby o	ranted to:	November 30	, 19
		mat, populasion is neleby gi	aned to.	•	
OWNER: Detroit Ed	ison				
CONTRACTOR:				·	<del></del>
Clinton Metropolitan Authority	at the following-d	rune, chip and/or remove trei escribed location:	es, snruds, drush or other	vegetation on, or across the prop	erly of the Huron-
Township of Commer	ce, Oakland	County, T2N, R8	E, Section 23, N	Marble Acres, Lot 1,	also part
of Lot 2 described	as beginni	ing at SW corner	of Lot 2, th N	165 ft., to NW Lot o	orner,
				ncave northeasterly,	
1514.38 ft., chord	bears, S 7	71°19'15" E 574.3	4 ft., th N 88°	00'00" W 839.98 ft.	to
beginning. Sidwel	1 No. 17-23	3-476-013.			
which statements and represe DRAWINGS AND SPECIFICA authorized representative of th INSURANCE. The Licensees Workman's Compensation Insulation damage liability) and separate PRECAUTIONS. The License properly safeguard the public of the Authority. ACCIDENT LIABILITY. The Libe owned by others, and shall Permit. PAVEMENT. No portion of the upon completion of the work, s WORK IN COUNTIES, TOWN Clinton Metropolitan Authority permission from any other age VIOLATION. The violation of a LIABILITY. The duties, respon-	intalions are incorditions. The worker Authority.  Ishall furnish, upourance, Comprehe Automobile Liabile eshall provide, ewhile the work is incensee shall be realled authority's roads such disturbed postilled or expensive which may any one of the consistibilities and liabilities.	porated in this permit as if so shall be accomplished in so shall be accomplished in so needed, evidence of such process. The Authority's received and maintain all necess in progress. The Authority's received accidents to persons and for ways shall be disturbed, exertions of the roadway shall be disturbed, exertions of this Permit shall continues of the permit shall continues of the permit shall be boreast to the permit shall continues of the permit shall be boreast to the permit shall continues of the permit shall continues of the permit shall be boreast to the permit shall continues of the permit shall continue the permit shall be permitted to the permit shall be permitted to the permitted to t	set forth at length herein), strict compliance with the hinsurance as shall be ance (not less than \$500,00 sary barricades, lights, was badways shall at no time to aused to the Authority's rowny damages to properly cept as specified above, we replaced in such a mar overs only that portion of s not release the Licens no specified property and/onstitute a forteiture of all	de by the Licensee in requesting and also upon the following term drawings and specifications or a salisfactory to the Authority. Lice 00.00 bodily injury liability, and \$2 arning signs and other precaution be closed to traffic without the private draways or structures and to strucy caused as a result of work permitten as shall be acceptable to the liner as shall be acceptable to the line property herein described to be from the responsibility of observed work.  I rights hereunder at the discretion Contractor jointly and severally.	as and conditions: as directed by the ensee shall carry 5,000.00 property mary measures to or written consent ctures which may formed under this he Authority; and e Authority, which the Hurontaining necessary
COMPLETION DATE. The wo	rk shall commend	66	<del> </del>		<del></del>
and shall be completed on or EFFECTIVE DATE: This Pern		fective until the Authority ha	as received at its Adminis	trative Offices (13000 High Ridg	e Drive, Brighton,
		e to the terms and condition	is hereof as duly signed b	y the Owner and the Contractor.	_
TOPE WORK TO BE DONE		Trim trees	to provide adeq	uate line clearance	for
TREE WORK TO BE DONE O				······································	
re-routed elect	rical serv.	ice.	<del> </del>		
OTHER REQUIREMENTS:	Remove a	and Dispose			
		and the same of th	er tronslation p. pt. population		
<del></del>	; ii.	di i e minute	no white it		
DISPOSITION OF WOOD	. <u> </u>		, , , , , , , , , , , , , , , , , , ,		
BRUSH	·	nti.	\$ \$1.7		
CHIDO		· · · · · · · · · · · · · · · · · · ·			
CHIPS	. <u> </u>	- ; ; ;	<u> </u>		
		ACCEP	TANCE		
We have read and are familiar by the terms and conditions the	with the terms an ereof.	nd provisions of the foregoing	Construction Permit and	we hereby agree jointly and seve	erally to be bound
Distant BAC	in Cour	DAN/d		7.7	
DEIROIT EDIS	OWNER	NIC 7		CONTRACTOR	
	•	(1) (1)	7		
1	ADDRESS			ADDRESS	
Mos es 9	Boom				
Ву	10000		Inspected and Approve	ed:	
Date: 12-4-92			8v —	MILL	

A Miller of the second of the

to a company

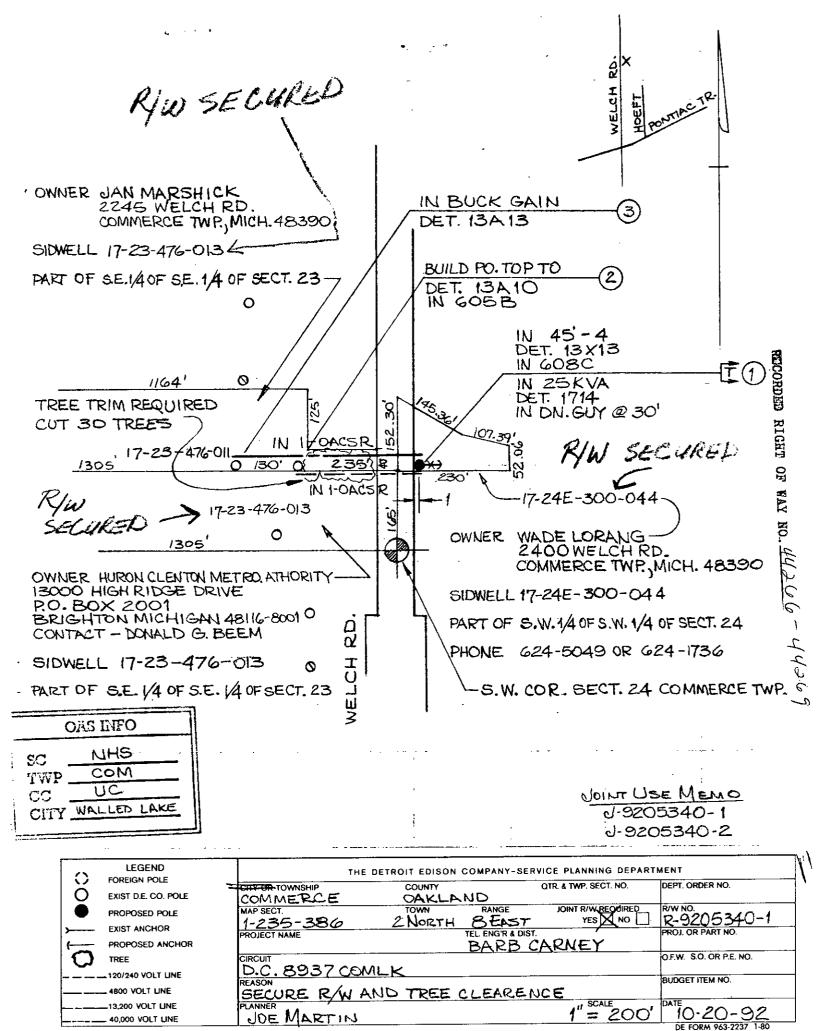

SP 11880A