## Detroit Edison

## LIBER 13404 7611 039

	UNDERGROUND EASEMENT (RIGHT OF WAY) NO. R-9208621-01
	On, 1992, for the consideration of system betterment, Grantor grants to Grantee a permanent underground easement ("Right of Way") in, on and across a part of Grantor's Land called the "Right of Way Area".  "Grantor" is:
	Joseph P. Salome and Beverly A. Salome, Husband and Wife, P.O. Box 81352, Rochester, Michigan 48308 "Grantee" is:
	The Detroit Edison Company, a Michigan corporation, 2000 Second Avenue, Detroit, Michigan 48226
	Michigan Bell Telephone Company, a Michigan corporation, 444 Michigan Avenue, Detroit, Michigan 48226
	United Artist of Oakland County, Inc., a Michigan corporation, 4500 Delemere, Royal Oak, Michigan 48073
2	- "Grantor's Land" is in Oakland Township, Oakland County, Michigan described as:
	Section 34, T4N, R11E, part of Northeast 1/4 beginning at point distant North 00°20'53" West 1837.95 feet and North
	00°20'10" West 365.36 feet and North 00°13'17" West 788.03 feet from South 1/4 corner, thence North 00°13'17" West 500
	feet, thence South 85°37'03" East 471.35 feet, thence South 45°15'00" West 659.05 feet to beginning. 2.69 Acres - Sidwell No:
	10-34-251-004
	The "Right of Way Area" is a part of Grantor's Land and is described as:  The South 10 feet of the North 40 feet of the West 180 feet of the East 250 feet of the Grantor's Land.  1. Purpose: The purpose of this Right of Way is to construct, reconstruct, modify, add to, operate and maintain underground
	The South 10 feet of the North 40 feet of the West 180 feet of the East 250 feet of the Grantor's Land.
	, , , , , , , , , , , , , , , , , , , ,
	utility line facilities consisting of poles, guys, anchors, wires, manholes, conduits, pipes, cables, transformers and accessories.
	utility line facilities consisting of poles, guys, anchors, wires, manholes, conduits, pipes, cables, transformers and accessories.  2. Access: Grantee has the right of access to and from the Right of Way Area.  3. Buildings or other Permanent Structures: No buildings or other permanent structures shall be placed in the Right of Way
	3. Buildings or other Permanent Structures: No buildings or other permanent structures shall be placed in the Right of Way  Area without Grantee's prior written consent.
	A December 1 As a company by Deblic 1 of 52 of 1024 MICC DIC must be called at 1 000 402 2121 before a company and the contract to
	the Right of Way Area.
	trees, bushes, branches and roots in the Right of Way Area (or that could grow into the Right of Way Area) and remove
	structures and fances in the Dight of Way Area that Grantee haliques could interfere with the safe and reliable construction
	operation and maintenance of Grantee's facilities. No trees, plant life, structures and fences shall be planted, grown or installed within 8 feet of the front door and within 2 feet of the other sides of transformers and switching cabinet enclosures. Grantee shall not be responsible to Grantor for damages to or removal of trees, plant life, structures and fences placed in front of transformer doors.
	within 8 feet of the front door and within 2 feet of the other sides of transformers and switching cabinet enclosures. Grantee
	shall not be responsible to Grantor for damages to or removal of trees, plant life, structures and fences placed in front of
	tialisioniae doors.
	6. Restoration: If Grantee's employees, contractors, vehicles or equipment damage Grantor's Land while entering Grantor's Land for the purposes stated in this Right of Way, then Grantee shall restore Grantor's Land as nearly as can be to its original
	condition.
	7 Successors: This Right of Way runs with the land and binds and benefits Grantor's and Grantee's successors, lessees,
	DETE DES JEETS DEED
	0001 MAR.16'93 12:36FM
	Witnesses: (type or pring name below signature) Grantor; (type or print in the below signature) 7,000 70000000000000000000000000000000
	1 manual 1
	1 Million Will relamed
′	THOMAS PAGANOS Joseph P. Salome
	Laura Graziani Duelly U. Salome
	LAURA ERAZIAN. Beverly A. Salome
	Acknowledged before me in MADNE County, Michigan, on
	by Joseph P. Salome and Beverly A. Salome, Husband and Wife.
	n792 PMR FFF (2011)
	J. THOMAS PAGANES

NOTARY PUBLIC MACOMB COUNTY, MICH MY COMMISSION EXPIRES 09-21-56 Notary's Stamp\_


\_Notary's Signature\_ (Notary's name, county and date commission expires)

Prepared by and Peturn to: Terry L. Benedict, 1970 Orchard Lake Road, Sylvan Lake Michigan 48320 ayın.

DATE NOVED AS TO FORM 12/15/92 DATE

LEGAL DEPARTMENT

O.K .- TS

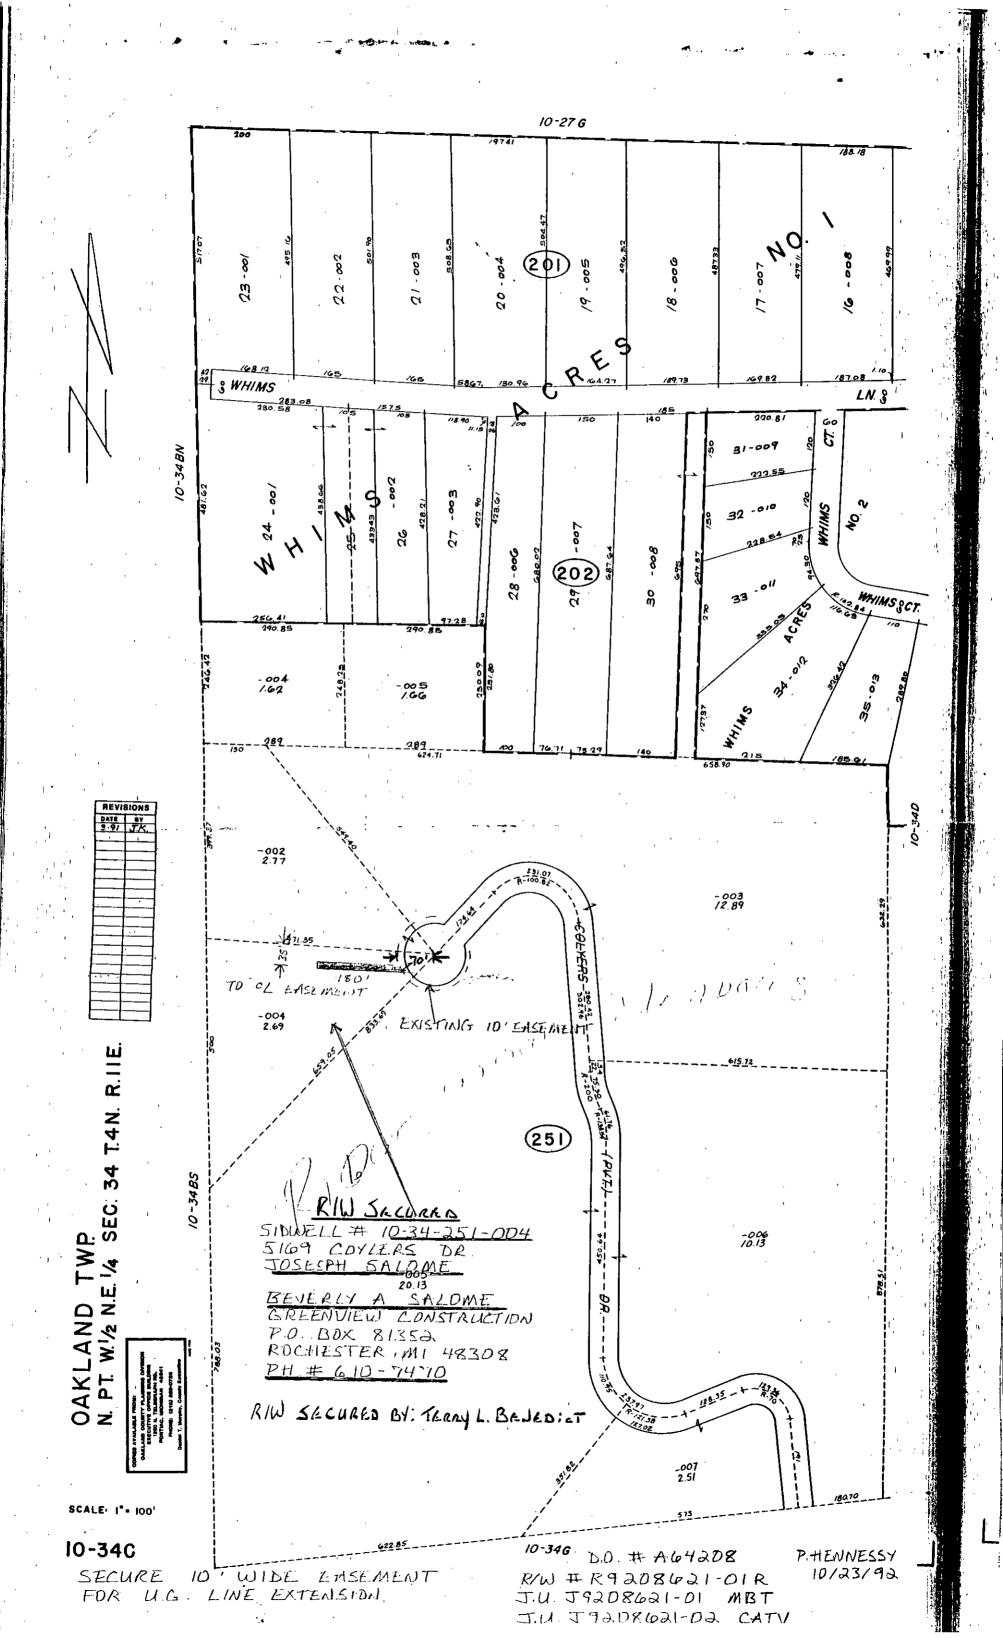

LYLYLO & LECORDED RIGHT OF WAY NO.