

OVERHEAD EASEMENT (RIGHT OF WAY) NO. O-1717

On 1-14, 1993, for the consideration of system betterment, Grantor grants to Grantee a permanent overhead easement ("Right of Way") in, on and across a part of Grantor's Land called the "Right of Way Area".

"Grantor" is:

Marilyn J. Dicks, survivor of herself and Ronald A. Dicks, her deceased husband, whose death certificate is recorded in Liber 5843, Page 131, Oakland County Records, of 2495 Charms Road, Milford, Michigan 48381-3000

"Grantee" is:

The Detroit Edison Company, a Michigan corporation, 2000 Second Avenue, Detroit, Michigan 48226

"Grantor's Land" is in Township of Milford, Oakland County, described as:

T2N, R7E, Section 24, part of E 1/2 of SE 1/4 beginning at point distant, N 00°40'30" E. 508.95 ft., from SE section corner, th N 00°40'30" E. 326.02 ft., th W 894.71 ft., th S 06°44'30" W. 328.20 ft., th E 929.07 ft. to beginning. 6.82 Acres. Sidwell No. 16-24-426-010.

The "Right of Way Area" is a part of Grantor's Land and is described as:

A 12 ft. wide easement with its centerline described as follows: Beginning at a point on the south property line, said point approximately 165 ft. west of the centerline of Charms Road, thence in a northerly direction to a point on the north property line, said point approximately 145 ft. west of the centerline of Charms Road and point of ending.

- 1. Purpose: The purpose of this Right of Way is to construct, reconstruct, modify, add to, operate and maintain overhead utility line facilities consisting of poles, guys, anchors, wires, cables, transformers and accessories.
2. Access: Grantee has the right of access to and from the Right of Way Area.
3. Buildings or other Permanent Structures: No buildings or other permanent structures shall be placed in the Right of Way Area without Grantee's prior written consent.
4. Trees, Bushes, Branches or Roots: Grantee may trim, cut down, remove or otherwise control any trees, bushes, branches or roots in the Right of Way Area (or that could grow into the Right of Way Area) that Grantee believes could interfere with the safe and reliable construction, operation and maintenance of Grantee's facilities.
5. Restoration: If Grantee's employees, contractors, vehicles or equipment damage Grantor's Land while entering Grantor's Land for the purposes stated in this Right of Way, then Grantee shall restore Grantor's Land as nearly as can be to its original condition.
6. Successors: This Right of Way runs with the land and binds and benefits Grantor's and Grantee's successors, lessees, licensees and assigns.

REG/DEEDS PAID 0001 JUL 21 '93 02:40PM 3564 MISC 7.00

Witnesses:(type or print name below signature)

Grantor:(type or print name below signature) B#92 REG/DEEDS PAID 0001 JUL 21 '93 02:40PM 3564 RMT FEE 2.00

James D. McDonald (signature) JAMES D. McDONALD

Marilyn J. Dicks (signature) MARILYN J. DICKS

OMER V. TRACINE (signature) OMER V. TRACINE

45010 RECORDED RIGHT OF WAY NO. 7.00 2.00 RMT

Acknowledged before me in OAKLAND County, Michigan, on 1-14, 1993 by MARILYN J. DICKS.


JAMES D. McDONALD Notary Public, Oakland County, MI My Commission Expires April 24, 1995

Notary's Stamp Notary's Signature James D. McDonald

Prepared by and Return to: James D. McDonald, 30400 Telegraph Road, Room. 277, Bingham Farms, Michigan 48025/PEW

Return-over

O.K. - TS

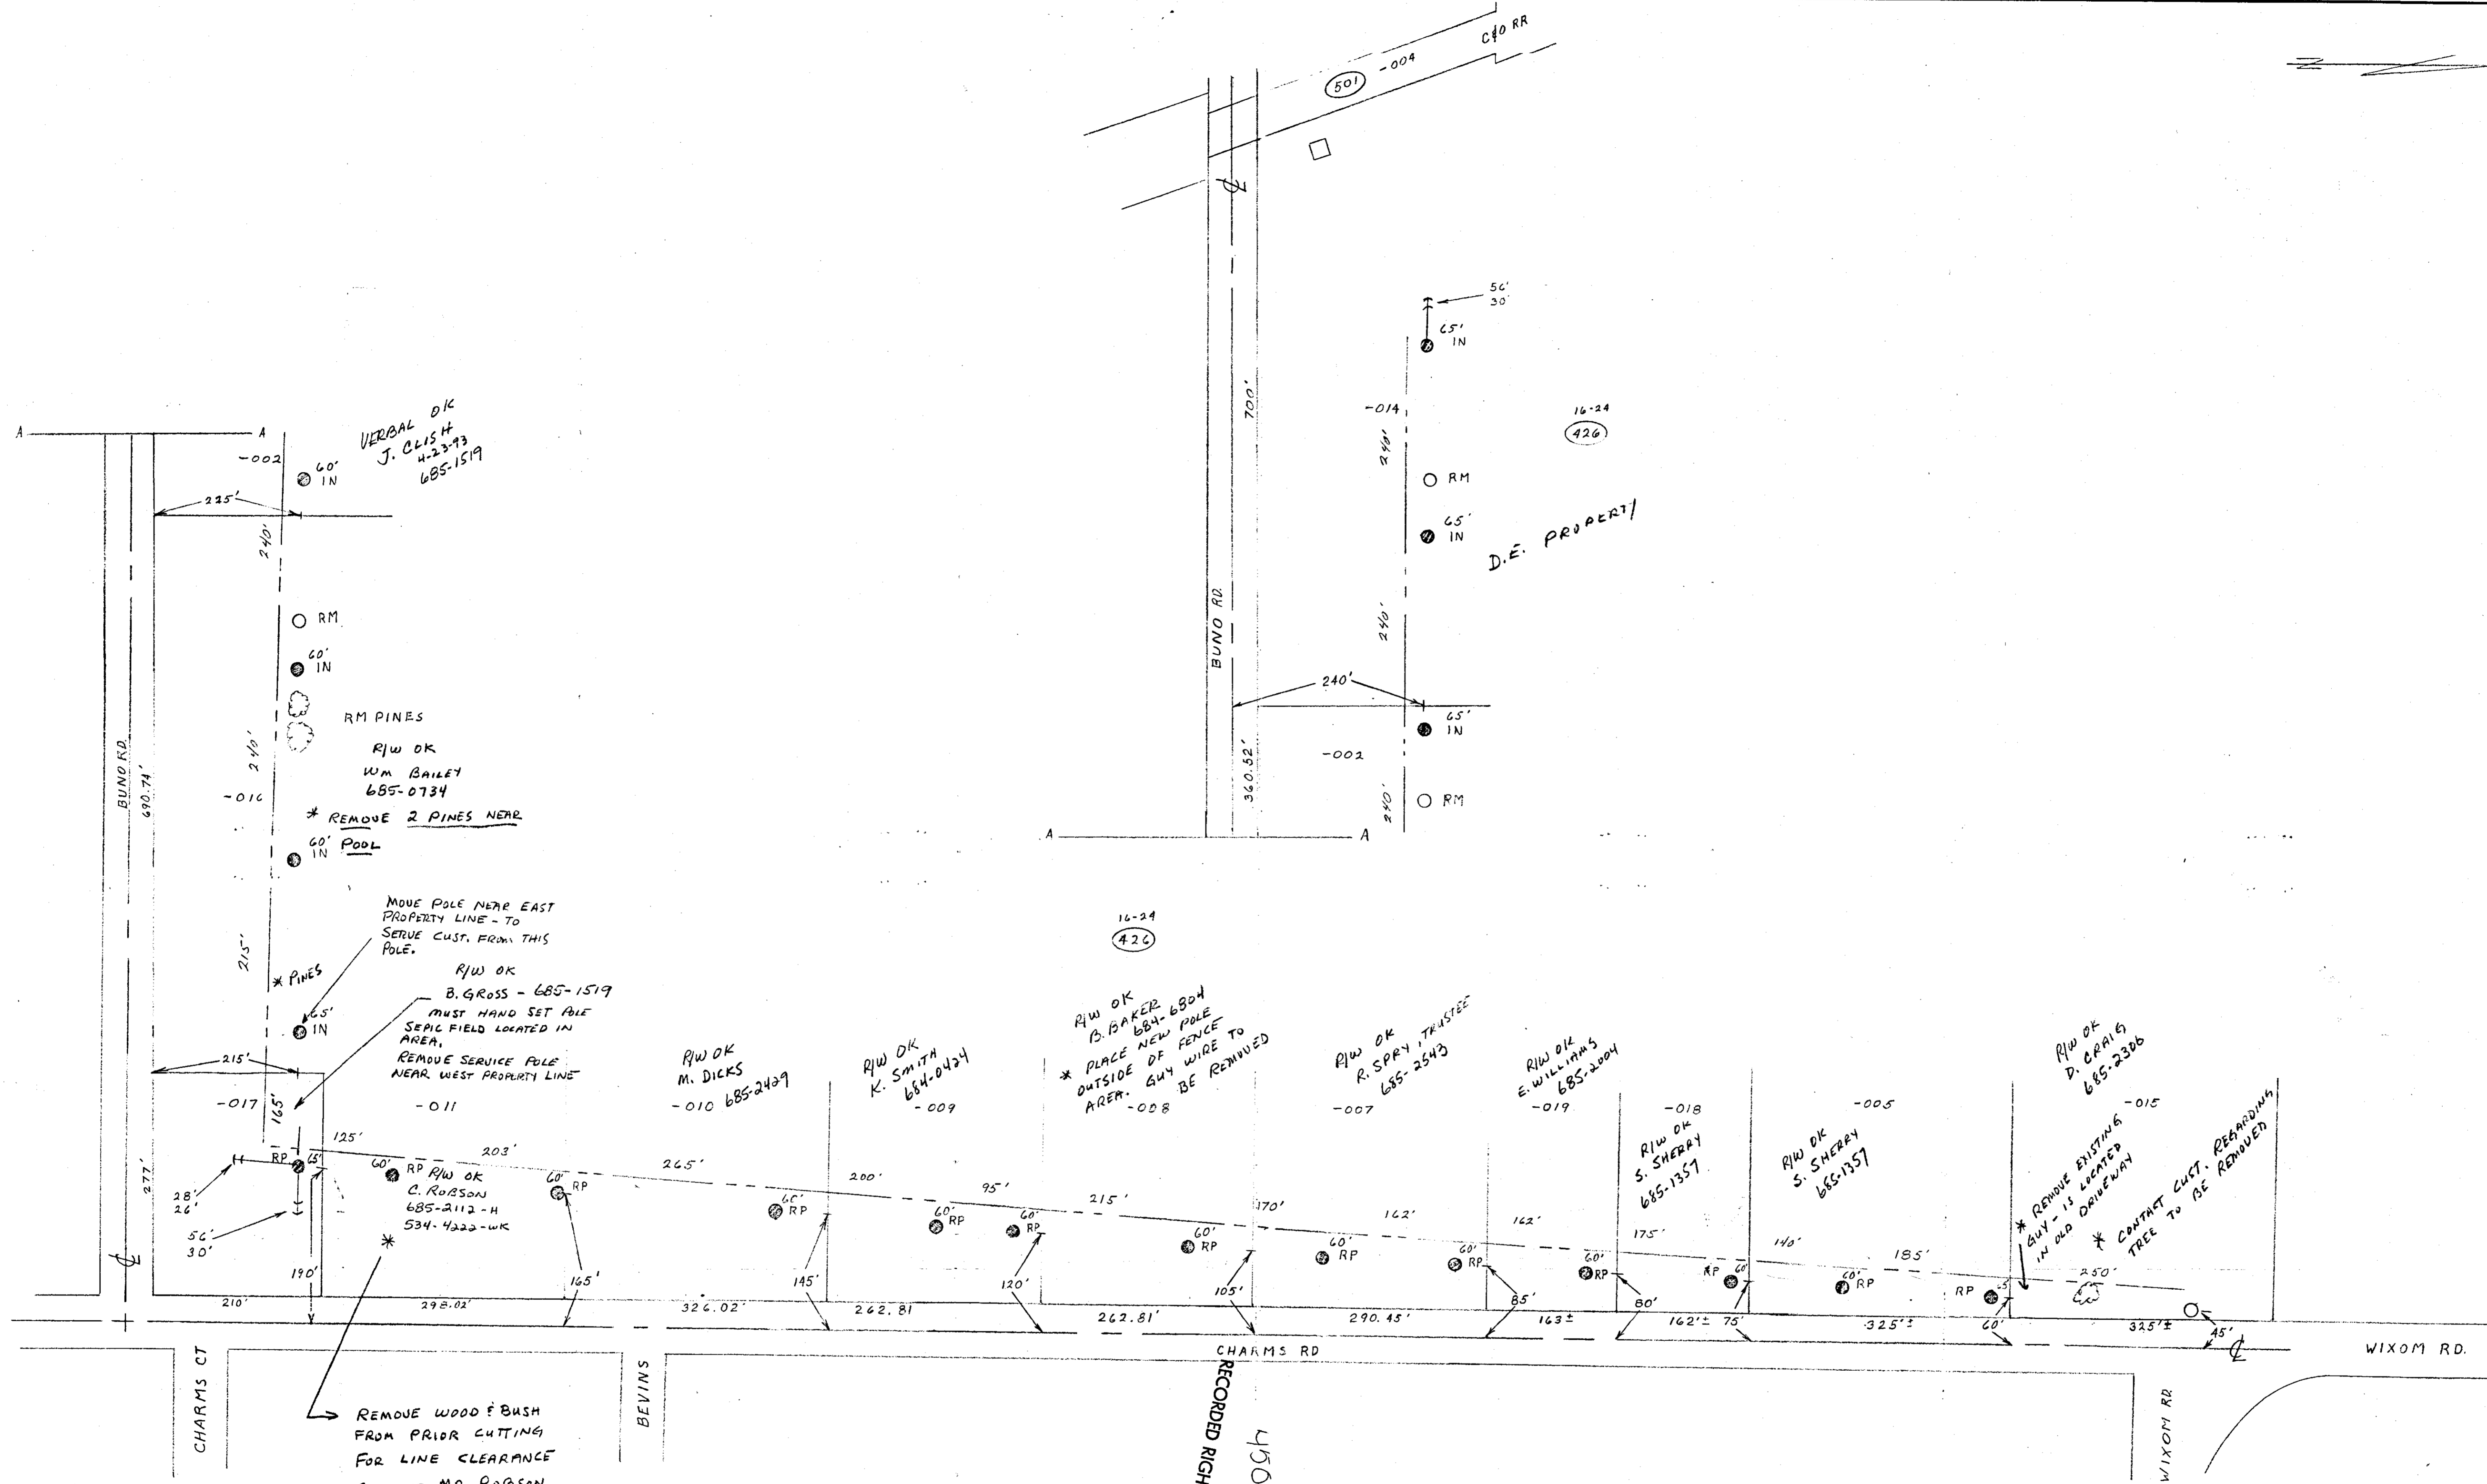

33321

ATLAS # 9200109			
City or Township MILFORD	County OAKLAND	Twp. Sect. No. 24	Dept Order No. C 50757
Map Sect. 1-205-389	Town 7E	Range 2N	Joint RW Required Yes <input type="checkbox"/> No <input checked="" type="checkbox"/>
Telephone Engineer 1-205-389 4L	Telephone District 7E	R/W No. R9200109-02	Project Name 2FAIE97H05
Circuit TIE 4412 #DC 8991 WIXOM		Budget Item No. 2FAIE-K1H	Reason INSTALL #/OR REBUILD IN CONJ. W/PROVD STA.
Layout By R.H. LANGE		Scale 1" = 100'	Date 11-6-92

RECORDED RIGHT OF WAY NO. 45006-45216