

2549 PAGE 618
RECEIVED
 OCT 31 2002
 CORPORATE REAL ESTATE SERVICES

CLERK REGISTER
 ST. CLAIR COUNTY
 RECEIVED FOR RECORD

OCT 14 2002
 LIBER 2549 PAGE 619 TIME 11:00 am
 Marilyn Dunn
 MARRLYN DUNN

Detroit Edison Overhead Easement (Right of Way) No. #436975

On September 30, 2002, for the consideration of system betterment, Grantor grants to Grantee a permanent overhead easement ("Right of Way") in, on and across a part of Grantor's Land called the "Right of Way Area."

"Grantor" is:

~~Carl and Helen Olson, husband and wife~~, 1732 Shore Club Drive, St. Clair Shores, Michigan 48080

John M. Olson, A Single Man

"Grantee" is:

The Detroit Edison Company, a Michigan corporation, 2000 Second Avenue, Detroit, Michigan 48226

"Grantor's Land" is in Riley Township, St. Clair County, Michigan described as:

Section 5 T6N R14E SW 1/4

S 1/2 OF SW 1/4 EXC N 330 FT OF S 887 FT OF W 1382 FT & W 1/2 OF SW 1/4 OF SE 1/4 89.53 A

The "Right of Way Area" is a part of Grantor's Land and is described as:

A 12 foot wide easement from an existing pole running in a Northwesterly direction for approximately 17 feet as shown on attached Right of Way drawing #436975/5 attached hereto and made a part hereof

1. **Purpose:** The purpose of this Right of Way is to construct, reconstruct, modify, add to, operate and maintain overhead utility line facilities consisting of poles, guys, anchors, wires, cables, transformers and accessories.
2. **Access:** Grantee has the right of access to and from the Right of Way Area.
3. **Buildings or other Permanent Structures:** No buildings or other permanent structures are allowed in the Right of Way Area without Grantee's prior written consent.
4. **Trees, Bushes, Branches, Roots, Structures and Fences:** Grantee may trim, cut down, remove or otherwise control any trees, bushes, branches and roots in the Right of Way Area (or that could grow into the Right of Way Area) and remove structures and fences in The Right of Way Area that Grantee believes could interfere with the safe and reliable construction, operation and maintenance of Grantee's facilities.
5. **Restoration:** If Grantee's employees, contractors, vehicles or equipment damage Grantor's Land while entering Grantor's Land for the purposes stated in this Right of Way, then Grantee will restore Grantor's Land as nearly as can be to its original condition.
6. **Successors:** This Right of Way runs with the land and binds and benefits Grantor's and Grantee's successors and assigns.

Grantor: (Type or print name below signature)

~~Carl Olson, a married man,~~

JOHN M. OLSON, A SINGLE MAN.

~~Helen Olson, his wife~~

Acknowledged before me in Macomb County, Michigan, on September 30, 2002,
 By ~~Carl and Helen Olson, husband and wife~~ **JOHN M. OLSON, A SINGLE MAN**

LAURINE E. RENKERT
 NOTARY PUBLIC MACOMB CO., MI
 MY COMMISSION EXPIRES Nov 11, 2005

Notary's Stamp _____ Notary's Signature Laurine E. Renkert


(Notary's name, county, and date commission expires)

RECORDED R/W FILE NO. 71598

RECORDED R/W FILE NO. 71598

REPORT OF PROPERTIES AND RIGHTS OF WAY DEPARTMENT R/W SECURED AS INDICATED ON THIS SKETCH		PERMITS TO:	
BY	10-2-02	RECORD CENTER	2
DATE		R/W FILES	
DATE WANTED	9-23-20	MBT	
DISTRICT FIELDMAN	<i>[Signature]</i>	ORIGINATOR	2
		TOTAL	2

EXHIBIT A

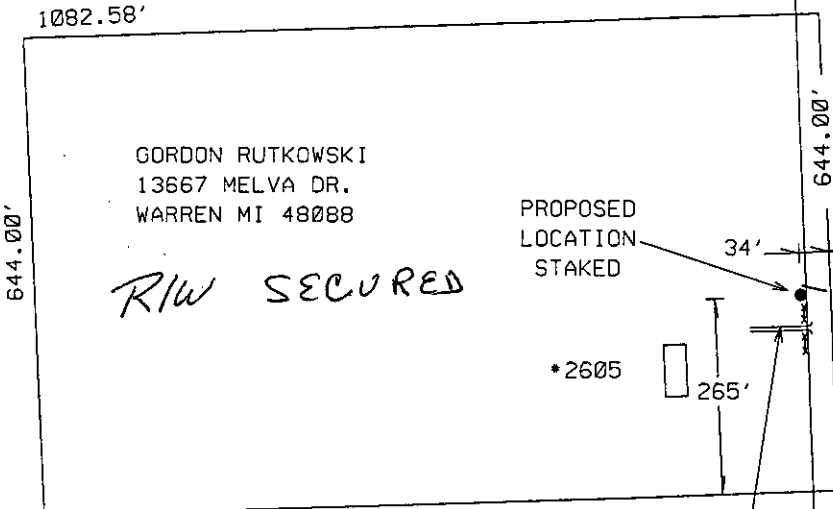

GORDON RUTKOWSKI
13667 MELVA DR.
WARREN MI 48088

R/W SECURED

PROPOSED LOCATION STAKED

*2605

265'

DRIVEWAY

RILEY CTR.

644.00'

945.18'

SE COR SEC 6

DUNN

REMOVE BRUSH TO ALLOW POLE REPLACEMENT
approx 140' from existing pole
to your north property line

R/W SECURED
DASON

NOTE:
ALL DIMENSIONS ARE APPROXIMATE.
ARMLESS CONSTRUCTION INVOLVED.
NO NEW ANCHORS REQUIRED.
NO TREE REMOVAL INVOLVED.
BRUSH REMOVAL REQUIRED AS NOTED.
EXISTING POLE TO BE REPLACED.

EXCEPTION

DASON

<p>LEGEND</p> <ul style="list-style-type: none"> ○ EXIST. D.E.CO. POLE ● PROPOSED POLE ○ FOREIGN POLE — EXIST. ANCHOR — PROPOSED ANCHOR ○ TREE --- 120/240 V LINE --- 4800 V LINE --- 13,200 V LINE --- 40,000 V LINE 		<p>THE DETROIT EDISON COMPANY-SERVICE PLANNING DEPARTMENT</p>			
<p>CITY OR TWP. RILEY TWP</p>		<p>COUNTY ST CLAIR</p>		<p>TWP SEC DTR 6</p>	
<p>MAP SECT.</p>		<p>TOWN RANGE 6N 14E</p>		<p>JOINT R/W REQ'D NO</p>	
<p>PROJECT NAME RUTKOWSKI</p>		<p>TEL. ENGR. & DIST. NONE</p>		<p>R/W NO. 436975/5</p>	
<p>TOWNSHIP</p>		<p>SERVICE CENTER</p>		<p>COMP. CODE</p>	
<p>CIRCUIT</p>		<p>MAILING CITY</p>		<p>CATV MEMO#</p>	
<p>REASON NEW HOUSE 2605 RILEY CENTER RD.</p>		<p>PLANNER GREG STOCKMAN</p>		<p>O.F.W.</p>	
<p>SCALE 1" = NONE'</p>		<p>DATE 8-19-02</p>		<p>BUDGET ITEM NO.</p>	

JPL 436975

North