

IN CONSIDERATION of the sum of One Dollar (\$1.00) and other valuable considerations, receipt of which is hereby acknowledged, We hereby grant to THE DETROIT EDISON COMPANY, its successors and assigns, the right to construct, operate and maintain its lines for the transmission and distribution of electricity and Company communication facilities, including the necessary poles, fixtures, guys and guy stubs, wires and equipment, and including also the right to trim or cut down any trees along said lines, which could fall into the lines or interfere in any way with their operation, upon, over and across OUR property located in St. Clair Township

STREET AND VILLAGE, OR SECTION AND TOWNSHIP

County of St. Clair, State of Michigan, and described as follows:

See description of property on sheet attached hereto and made a part hereof.

The route of the lines shall be as follows: As shown in red on attached sketch.

The Company, its successors and assigns, shall reimburse Us for all damage to growing crops, buildings or fences, caused by its men, teams, trucks and other vehicles and equipment in entering said property from time to time for the purposes set forth herein.

SEE RIDER ATTACHED AND MADE A PART HEREOF.

Witness:
Chas. G. Webster
Chas. G. Webster
George L. Friederichs
George L. Friederichs

(Signed) George W. Zimmer
George W. Zimmer
Monica S. Zimmer
Monica S. Zimmer


(Accepted)

THE DETROIT EDISON COMPANY

By Richard H. Taylor
RIGHT-OF-WAY AGENT
Richard H. Taylor

STATE OF MICHIGAN

County of St. Clair

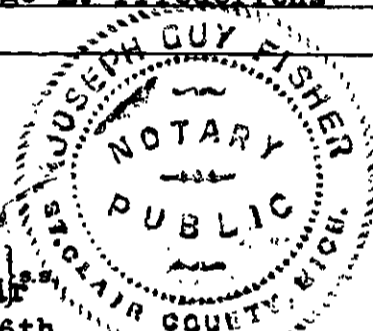

On this 16th day of April, A. D. 1951, before the undersigned, a notary public in and for said county, personally appeared George W. Zimmer and Monica S. Zimmer, his wife

known to me to be the person s who executed the foregoing instrument and acknowledged the same to be their free act and deed.

Joseph Guy Fisher
Joseph Guy Fisher
Notary Public, St. Clair County, Michigan

My Commission expires January 4, 1952.

688/168

RIGHT OF WAY FILE NO. 13827

RIGHT OF WAY PERMIT FOR MICHIGAN BELL TELEPHONE COMPANY

In addition to the provisions of the agreement to which this rider is attached, the right is hereby granted to the Michigan Bell Telephone Company, 1365 Cass Ave., Detroit 26, Michigan, its lessees, assignees and allied companies, to construct, reconstruct, operate, and maintain its lines of telephone and telegraph along the same route covered by the attached permit, and including poles, wires, cables, conduits, guys, anchors, and other fixtures and appurtenances.


It is further understood that the Michigan Bell Telephone Company is hereby given the right to cut and trim from time to time any and all trees and brush along said lines which may interfere therewith.

Date April 16 1951.

Property Owners George W. Zimmer
George W. Zimmer

Beginning at the intersection of the west line of Private Claim 305 and the centerline of Vine Street, thence north $45^{\circ}51'$ W. 747.74' along said centerline to intersection of said centerline with the north Section Line; thence west along the north Section line 298.37'; thence S. $13^{\circ}33'$ W. 363.94'; thence west 135.78'; thence south $13^{\circ}33'$ W. 604.51'; thence south $75^{\circ}.04'$ E. 974.77' to the westerly Private Claim line; thence north $14^{\circ}.01'$ East along the west Private Claim line 724.29' to Beginning, containing 20 Acres in Fractional Sec. 36, T5N, R16E and Private Claim 307.

RIGHT OF WAY FILE NO. 13827

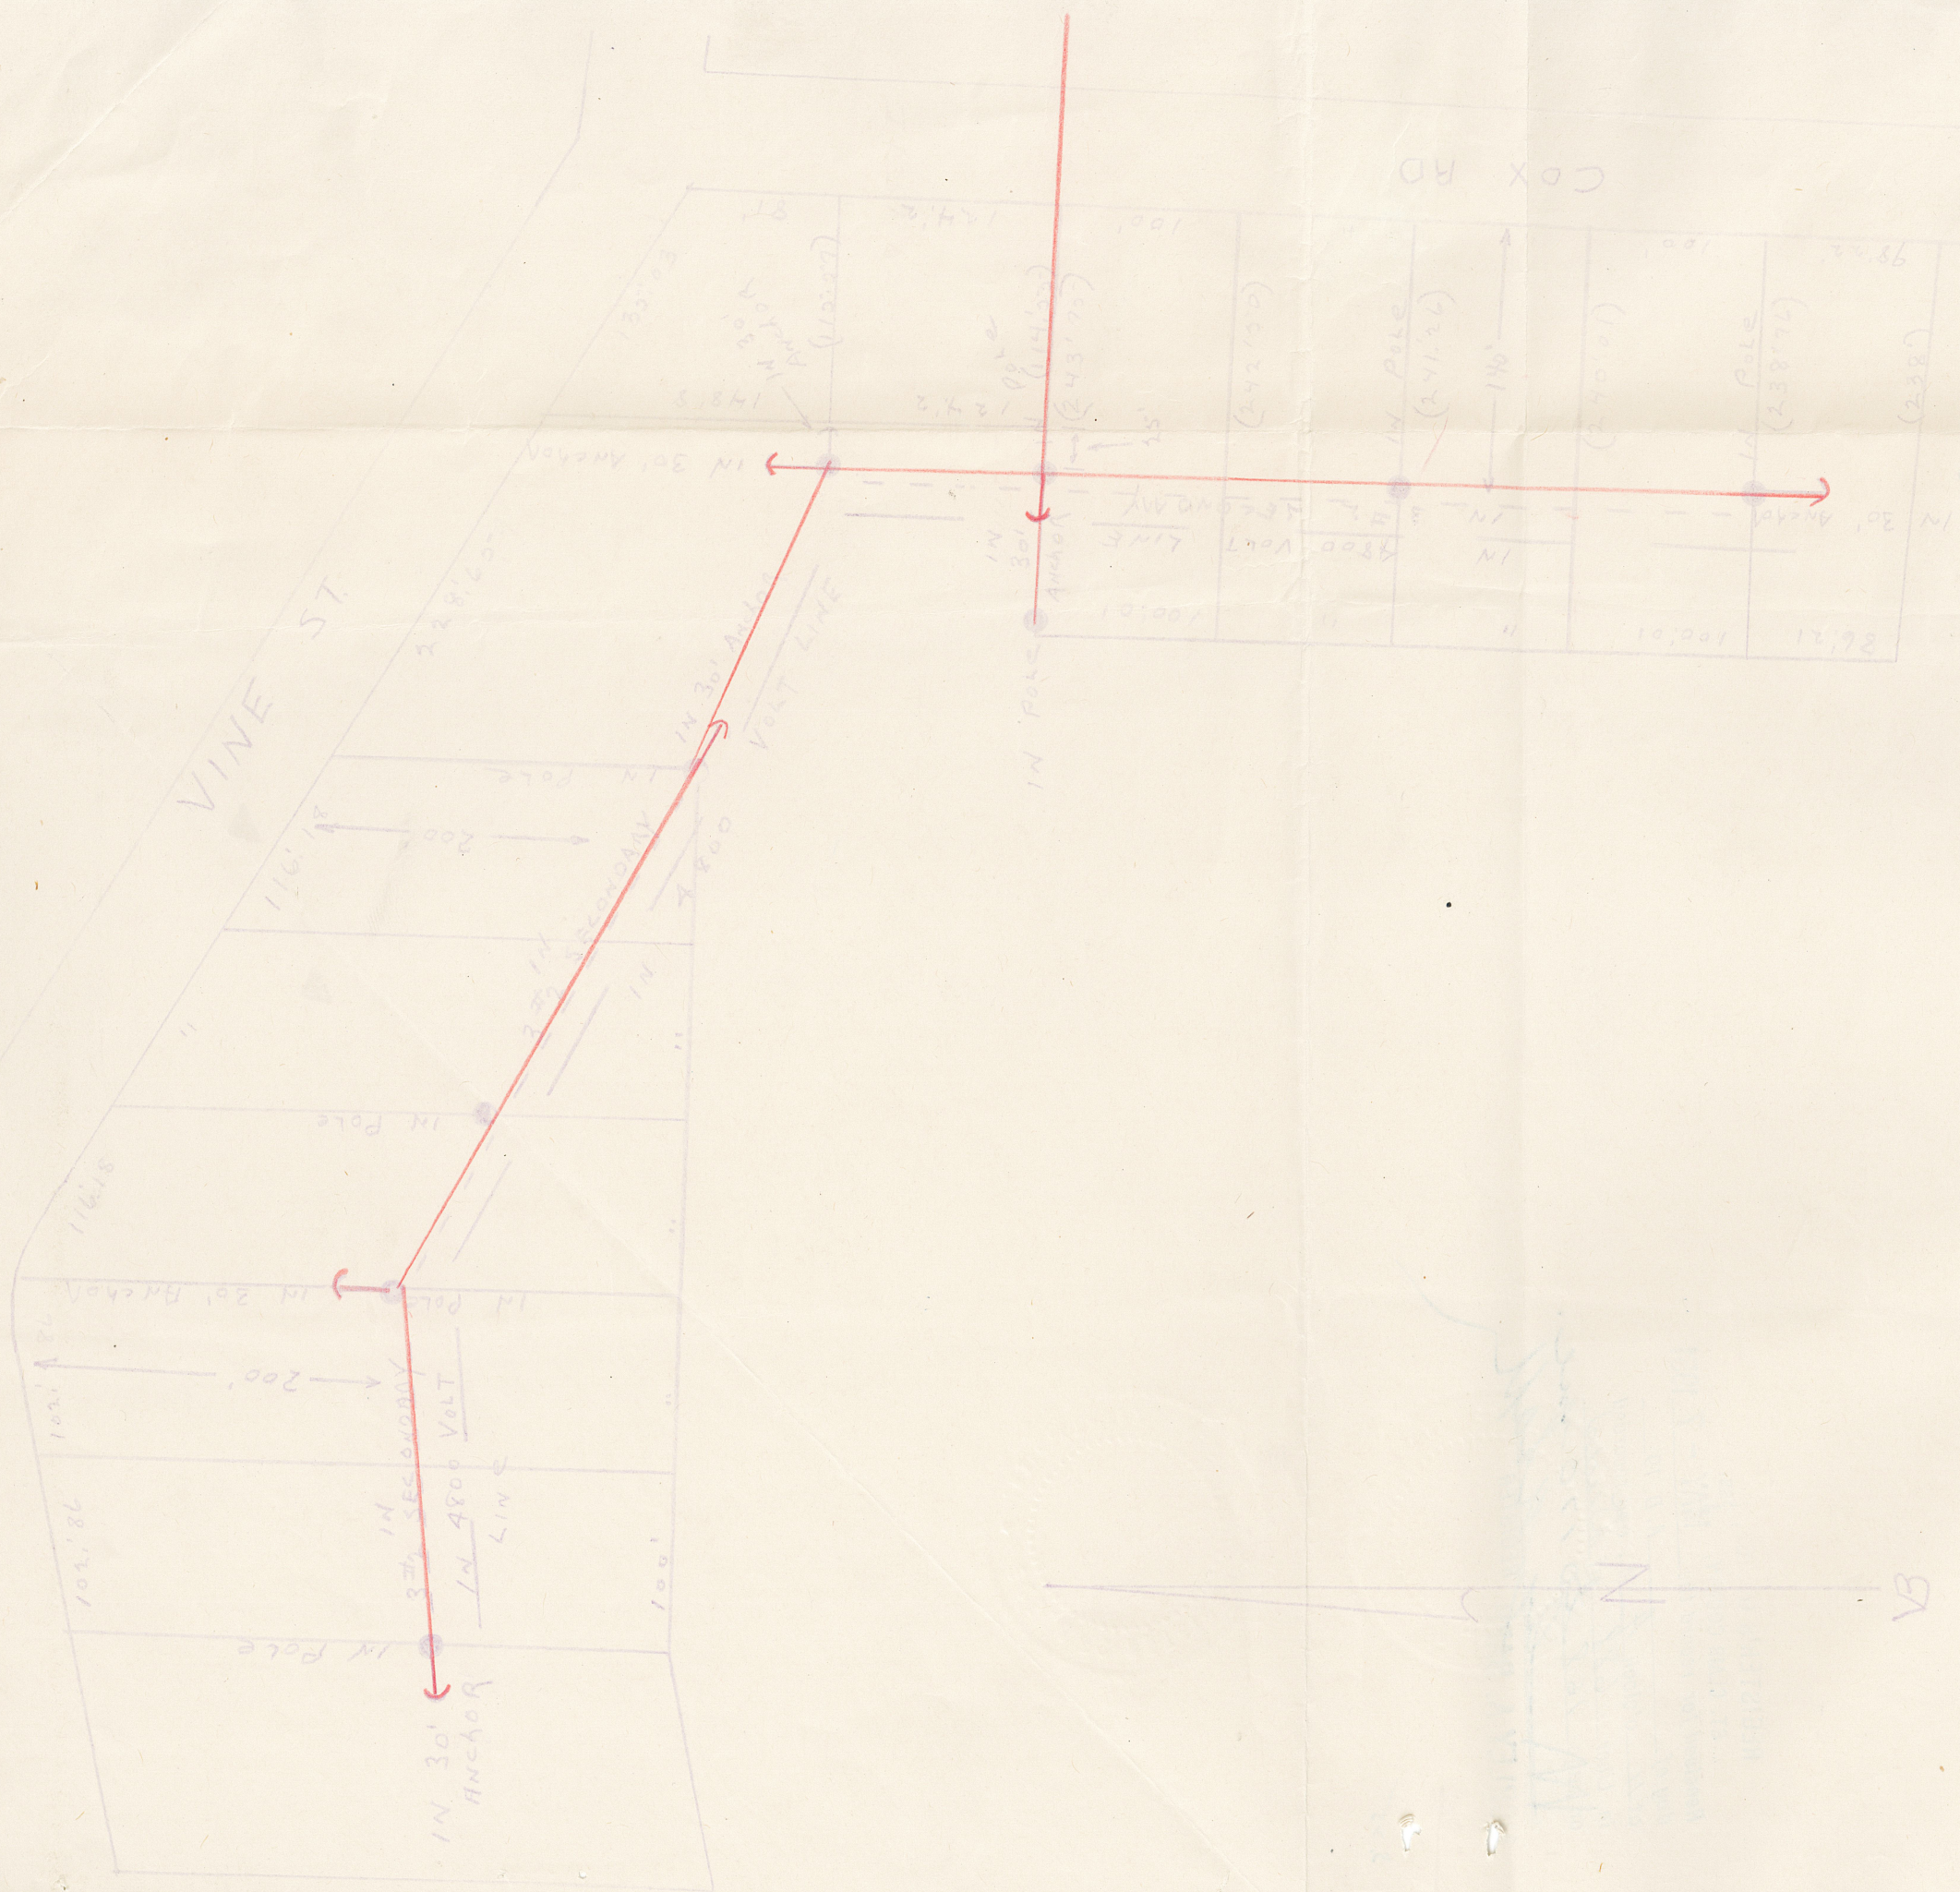

N
 W
 S
 E
 1/2
 SECTION
 36

ST. C 35 + 36-1


RETURN TO
RICHARD H. TAYLOR
The Detroit Edison Company
2000 SECOND AVENUE
DETROIT 26, MICHIGAN

RIGHT OF WAY FILE NO. 13827

REGISTER'S OFFICE,
ST. CLAIR COUNTY, } SS.
Received for record the MAY - 7 1951
day of _____ A. D. 19____
at 11 o'clock A M., and recorded
in Liber 688 of Serial
of Page 168 to 170 inc.
M. A. Smith

MORLEY A. SMITH REGISTER

688/170

325