

## EIGHT MILE - YOMING URBAN REDEVELOPMENT PLAT

PART OF THE S.W. 1/4 OF SECTION 4, T.I.S., R.I.E.

MASON L. BROWN & SON  
INCORPORATED  
CIVIL ENGINEERS AND LAND SURVEYORS  
16 MARSHALL AVENUE  
DETROIT - MICHIGAN  
242-2222

CITY OF DETROIT  
WAYNE COUNTY, MICHIGAN.

DESCRIPTION

The land embraced in the annexed plat of EIGHT MILE-YOMING URBAN REDEVELOPMENT PLAT of part of the S.W. 1/4 of Section 4, T. 1 S., R. 11 E., City of Detroit, Wayne County, Michigan, comprises Lots 1 to 68 both inclusive and Outlet "A", being a reprint of Lots 8 to 36 both inclusive and Lots 69 to 131 both inclusive and Lots 132 to 138 both inclusive and including all of vested streets and alleys adjoining said lots of Roth's Outer Drive Subdivision, recorded in Liber 66 of Plat, Page 32.

described as follows: Beginning at a point in the South line of Pembroke Ave., 66 ft. wide, which point is distant S. 88° 48' 00" E. 338.61 ft. along the E. and W. 1/4 line of Section 4 and S. 121° 43' E. 33.00 ft. from the center 1/4 corner of said Section 4; thence S. 121° 43' E. 1063.24 ft.; thence S. 88° 17' 00" E. 318.28 ft.; thence along the center line of said Cherrylawn Ave., 75 ft. wide, N. 1° 26' 30" W. 65.30 ft.; thence along the North line of Lot 8 of said Roth's Outer Drive Subdivision and its extension in the Easterly and Easterly direction S. 88° 17' 00" E. 100.30 ft.; thence along the East line of Sherwood Heights Sub'n., recorded in Liber 74 of Plat, Page 44 and Pembroke Drive Sub'n., recorded in Liber 73 of Plat, Page 38, N. 1° 33' 18" E. 971.82 ft.; thence along the South line of said Pembroke Ave. N. 88° 48' 00" E. 338.67 ft. to the point of beginning.

DEDICATION

KNOW ALL MEN BY THESE PRESENTS, That I, Robert D. Knox, Director-Secretary of the Detroit Housing Commission of the City of Detroit, County of Wayne, State of Michigan, pursuant to Section 8(a) of Act 344 of the Public Act of 1948, as amended, and a resolution of the Common Council of the City of Detroit adopted on MARCH 21, 1967 have caused the land embraced in the annexed Plat to be surveyed, laid out and platted to be known as "EIGHT MILE-YOMING URBAN REDEVELOPMENT PLAT of part of the S.W. 1/4 of Section 4, T. 1 S., R. 11 E., City of Detroit, Wayne County, Michigan," that title to alleys, highways, park, streets, and public easements, have been acquired by the municipality by purchase, dedication, or condemnation for public use, and that public easements, as shown on said plat, are hereby dedicated to the use of the public, and that Outlet "A" is hereby dedicated to the City of Detroit for public park purposes, and that no permanent structures shall be erected within the boundaries of the easements without the consent of the Common Council of the City of Detroit.

Signed in the  
presence of:

*James A. Luttrell,  
Chairman of the Board  
Robert D. Knox*

Detroit Housing Commission  
of the City of Detroit  
*Robert D. Knox*  
2811 Orleans Street  
Detroit, Michigan 48207

ACKNOWLEDGMENT

State of Michigan  
County of Wayne

On this 19<sup>th</sup> day of April, 1967, A.D., before me, a Notary Public in this County, personally came the above named Robert D. Knox, Director-Secretary of the Detroit Housing Commission of the City of Detroit, known to me to be the person who executed the above dedication and acknowledged the same to be his free act and deed as Director-Secretary of the Detroit Housing Commission.

*Jack J. Mann*  
Notary Public Wayne County, Michigan

My Commission Expires Dec 2, 1968

Approved by the Plat Board of Wayne County, Mich.

Year	Month	Day
1967	April	19
At the office of the Plat Board of Wayne County, Mich.		
Signed by the Plat Board of Wayne County, Mich.		
Arthur J. Gersbach, Chairman		
John V. Murphy, Vice-Chairman		

Approved as in compliance with all relevant regulations  
of the Plat Board of Wayne Co. Mich. APR 20, 1967

*Charles J. Ogle*  
Charles J. Ogle, County Plat Engineer

I hereby certify that the plat herein delineated is a correct one and that permanent metal monuments consisting of iron bars not less than one-half inch in diameter and 36 inches in length, encased in concrete cylinders at least 4 inches in diameter and 36 inches in depth have been placed at points marked thus (o) as shown at all angles in the boundaries of the land platted, at all the intersections of lines of streets, and at the intersections of lines of streets with the boundaries of the plat as shown on said plat except at points marked thus (e).

Prepared and Drafted By  
*Mason L. Brown*  
Mason L. Brown  
Registered Land Surveyor No. 8310  
Mason L. Brown & Son, Inc.  
118 Madison Avenue  
Detroit, Michigan 48226

I hereby certify that the legislative body of the City of Detroit approved this plat on OCTOBER 17, 1967 and is in agreement with Section 16  
and that the width and depth of the lots herein shown are  
in accordance with the rules and requirements adopted by  
the said body with the requirements of Act 172, P.A.  
2000, as amended.

*Robert E. Tuohy*

After examination of the above-mentioned plat  
I hereby certify that the title to land to be dedicated  
to the public in this plat is clear and free of all  
encumbrances.

CITY PLAN COMMISSION  
DETROIT, MICHIGAN

EXAMINED AND APPROVED  
Date APR 20, 1967

*Arnold Green*  
ALFRED GREEN  
STATE TREASURER  
ROBERT E. TUOHY

FIELD CHECKED ✓

26107

THE DETROIT EDISON COMPANY  
2000 SECOND AVENUE  
DETROIT, MICHIGAN 48226

(COPY OF THIS LETTER WENT TO ALL PROPERTY OWNERS  
IN THE EIGHT-MILE - WYOMING REHABILITATION PROJECT.)

Dear Sir:

The property restrictions on the property which you own in the Eight Mile - Wyoming Rehabilitation Project require installation of underground utility lines. These restrictions are recorded in Liber 16041, page 324, Wayne County Register of Deeds Records.

In order to conform with these restrictions, the Detroit Edison Company is removing its overhead lines within the area and will install an underground distribution system. The overhead distribution system on the east, south, and west boundaries of the area will remain.

When your new residence in this area is ready to have electric service connected, you must request the Edison Company to install the service lateral conductors between the Company facilities in the easement of the rear of the lot and the meter location on the rear wall of the residence. Upon such request, the Company will arrange to have a contractor install the conductors and will bill you \$180 for the work. This includes your share of the cost of the underground distribution system.

The contractor will also install the telephone service conductors in the same trench.

When you are ready to have this work done, or if you need further information, please call Mr. Bender on TYler - 8-9840.

We will appreciate your cooperation in making these arrangements.

Sincerely,

  
L. J. Van Tuyl  
Assistant Director  
Detroit Customers Service

LJV/jmf

RECORDED  
11/11/67  
26194

5/22/68 Wyoming - 8 mile

Talked with L Van Tuyl - We both are of the opinion that it would be useless to try to secure restrictions and agreements - Various owners.

Restrictions are on record for UG service by City - We must rely on common law rights if our lines are damaged. We will check recorded plot to see if we have proper easements.

JM & Sonne

RECORDED RIGHT OF WAY NO. 26104

Greenfield

See 4

SW 1/4

= int Mile-Wyoming Urban Renewal Plot

**MEMORANDUM ORDER**  
FOR GENERAL USE  
DE FORM MS 77 12-53

TO Art Giesen 1901 Second Street 106

DATE 3-67-68

TIME \_\_\_\_\_

Re: Underground Services, Wyoming-Eight Mile Union Tunnel, Encinit

No attempt will be made to secure our agreement or restrictions.

Our lines will be in concrete on flat. We will install house services on

payment of \$100.00 each. F. Zander, B-202, WDC, to coordinate on this.

COPIES TO:

R. H. Giesen 1901 Second Street 106

SIGNED

*Stephen C. S. Name*  
Stephen A. K. Hunter

REPORT

E. W. Tripp 728 U. S.

Staff Attorney, Law Dept./UDC

F. Zander, B-202, WDC

File

DATE RETURNED \_\_\_\_\_

TIME \_\_\_\_\_

SIGNED \_\_\_\_\_

*Wyoming 8 mile*

6. Miscellaneous Provisions

16041 p.324

A. Location of Utility Equipment

All utility equipment including facilities for transmission of distribution of gas, electricity, storm, water, or communications, except fire hydrants, lighting standards, related fixtures, and above ground utility equipment associated with subsurface utility installations, shall be located underground or enclosed entirely within a building. Any screening of above ground utility equipment associated with subsurface utility installations, which may be required by the City of Detroit shall be provided by the developer.

B. Easements

Easements for utilities shall be maintained at locations shown on the Land Use and Development Plan. Additional easements for subsurface utilities shall be provided by the owner as required for development of the property, subject to the approval of the utility companies and/or municipal departments affected. No structures may be erected or trees planted within these easements without permission of the Common Council of the City of Detroit.

7. Amending Restrictions

The Common Council of the City of Detroit may, after a public hearing, amend these restrictions applying to any undeveloped parcel or part thereof. Provided, however, that the restrictions may not be amended with respect to any of the parcels sold or contracted to be sold without the consent of the owners. Notice of time and place of the hearings shall be given by publication in a newspaper of general circulation not less than 30 days prior to the date set for such hearing. Notice of such hearing shall be mailed at least 25 days before such hearing to the last known owner of each parcel of land in the Eight Mile-Wyoming Rehabilitation Project at the last known address of such owner as shown by the records of the Assessor of the City of Detroit.

8. Severability

Invalidation of any one of these covenants by judgment or court order shall in no way affect any of the other provisions which shall remain in full force and effect.

RECORDED FIFTH OF MAY NO. 26104

## EIGHT MILE - WYOMING URBAN REDEVELOPMENT PLAT

PART OF THE S.W. 1/4 OF SECTION 4, T.18., R.18.

MASON L. BROWN & SON  
INCORPORATED  
CIVIL ENGINEERS AND LAND SURVEYORS  
110 MADISON AVENUE  
DETROIT - MICHIGAN.

CITY OF DETROIT  
WAYNE COUNTY, MICHIGAN.

SHEET 1  
OF 2 SHEETS  
RECEIVED AT 10:00 A.M.  
MAY 21  
PAGE 23124 WCR.

Wayne Co., Michigan

Scale : 1 in = 100 ft.

DETROYAL GARDENS SUBN.

L. 35, R. 77.

ASKEW PARK SUBN. L.42, P.83.

PEMBROKE AVE. 66 FT. WD.

N 88°49'00"E. 989.07 FT.

971.92 FT.  
N 1°39'16"W  
971.92 FT.

CHERRYWOOD HEIGHTS SUBN. L.74, R.44.

CHERRYLAWN AVE. 75 FT. WD.

CHERRYLAWN

N 88°17'00"W. 818.25 FT.



ROTH'S CUTTER

NORTHLAWN  
75DRIVE SUBN.  
150 FT. WD.ROSELAWN AVE. 75 FT. WD.  
S.1°23'53"E.  
ADRIIDGE  
Ave. 50'

106324 FT.

L. 46, P. 32.

L. 46, P. 32.

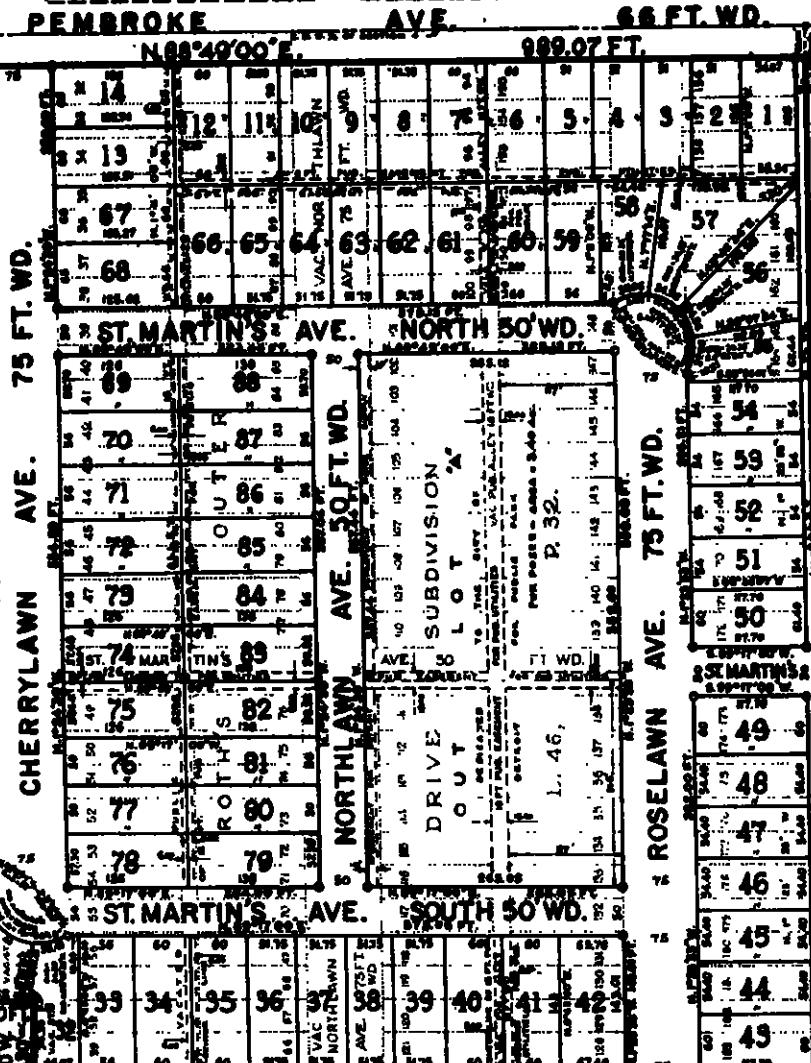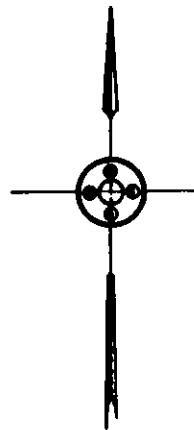

DETROIT CIVIL ENGINEERS

967 DEC 19 AM 10 04

DETROIT CIVIL ENGINEERS

501/92

Circulate to [Signature]  
D.J.P.

## INTERDEPARTMENT CORRESPONDENCE

GENERAL ENGINEERING DEPARTMENT  
WARREN SERVICE CENTER

April 15, 1968

MEMORANDUM TO: Mr. G. Layton Murphy, General Representative-  
Civic and Community Affairs Department

SUBJECT: Eight-Mile Wyoming Urban Renewal Plat

Attached are copies of General Engineering Sketch A68-35, referred to in your letter of April 2nd to Mr. Petoskey. The sketch shows cables and other underground equipment installed in dedicated easements to serve the interior lots, and underground services from overhead equipment in existing alleys and easements to serve peripheral lots. Transformer and conductor sizes are predicated on known requirements, but may be changed somewhat to accommodate proposed church load (Lots 1 through 8). It is understood that most of the lots have been sold, and building construction is under way on a large percentage of these lots.

Lorenz H. McKinney  
Lorenz H. McKinney

APPROVED:

N. E. Webb


N. E. Webb  
District Planning Engineer-Detroit

/jr

cc: E.W. Petoskey  
C.F. Ogden  
G. Hogg  
L.J. VanTuyl  
W.R. Milby  
H.W. Priebe  
M.F. Bender  
A. Lawrence

4-16-68


Robert B. Murphy

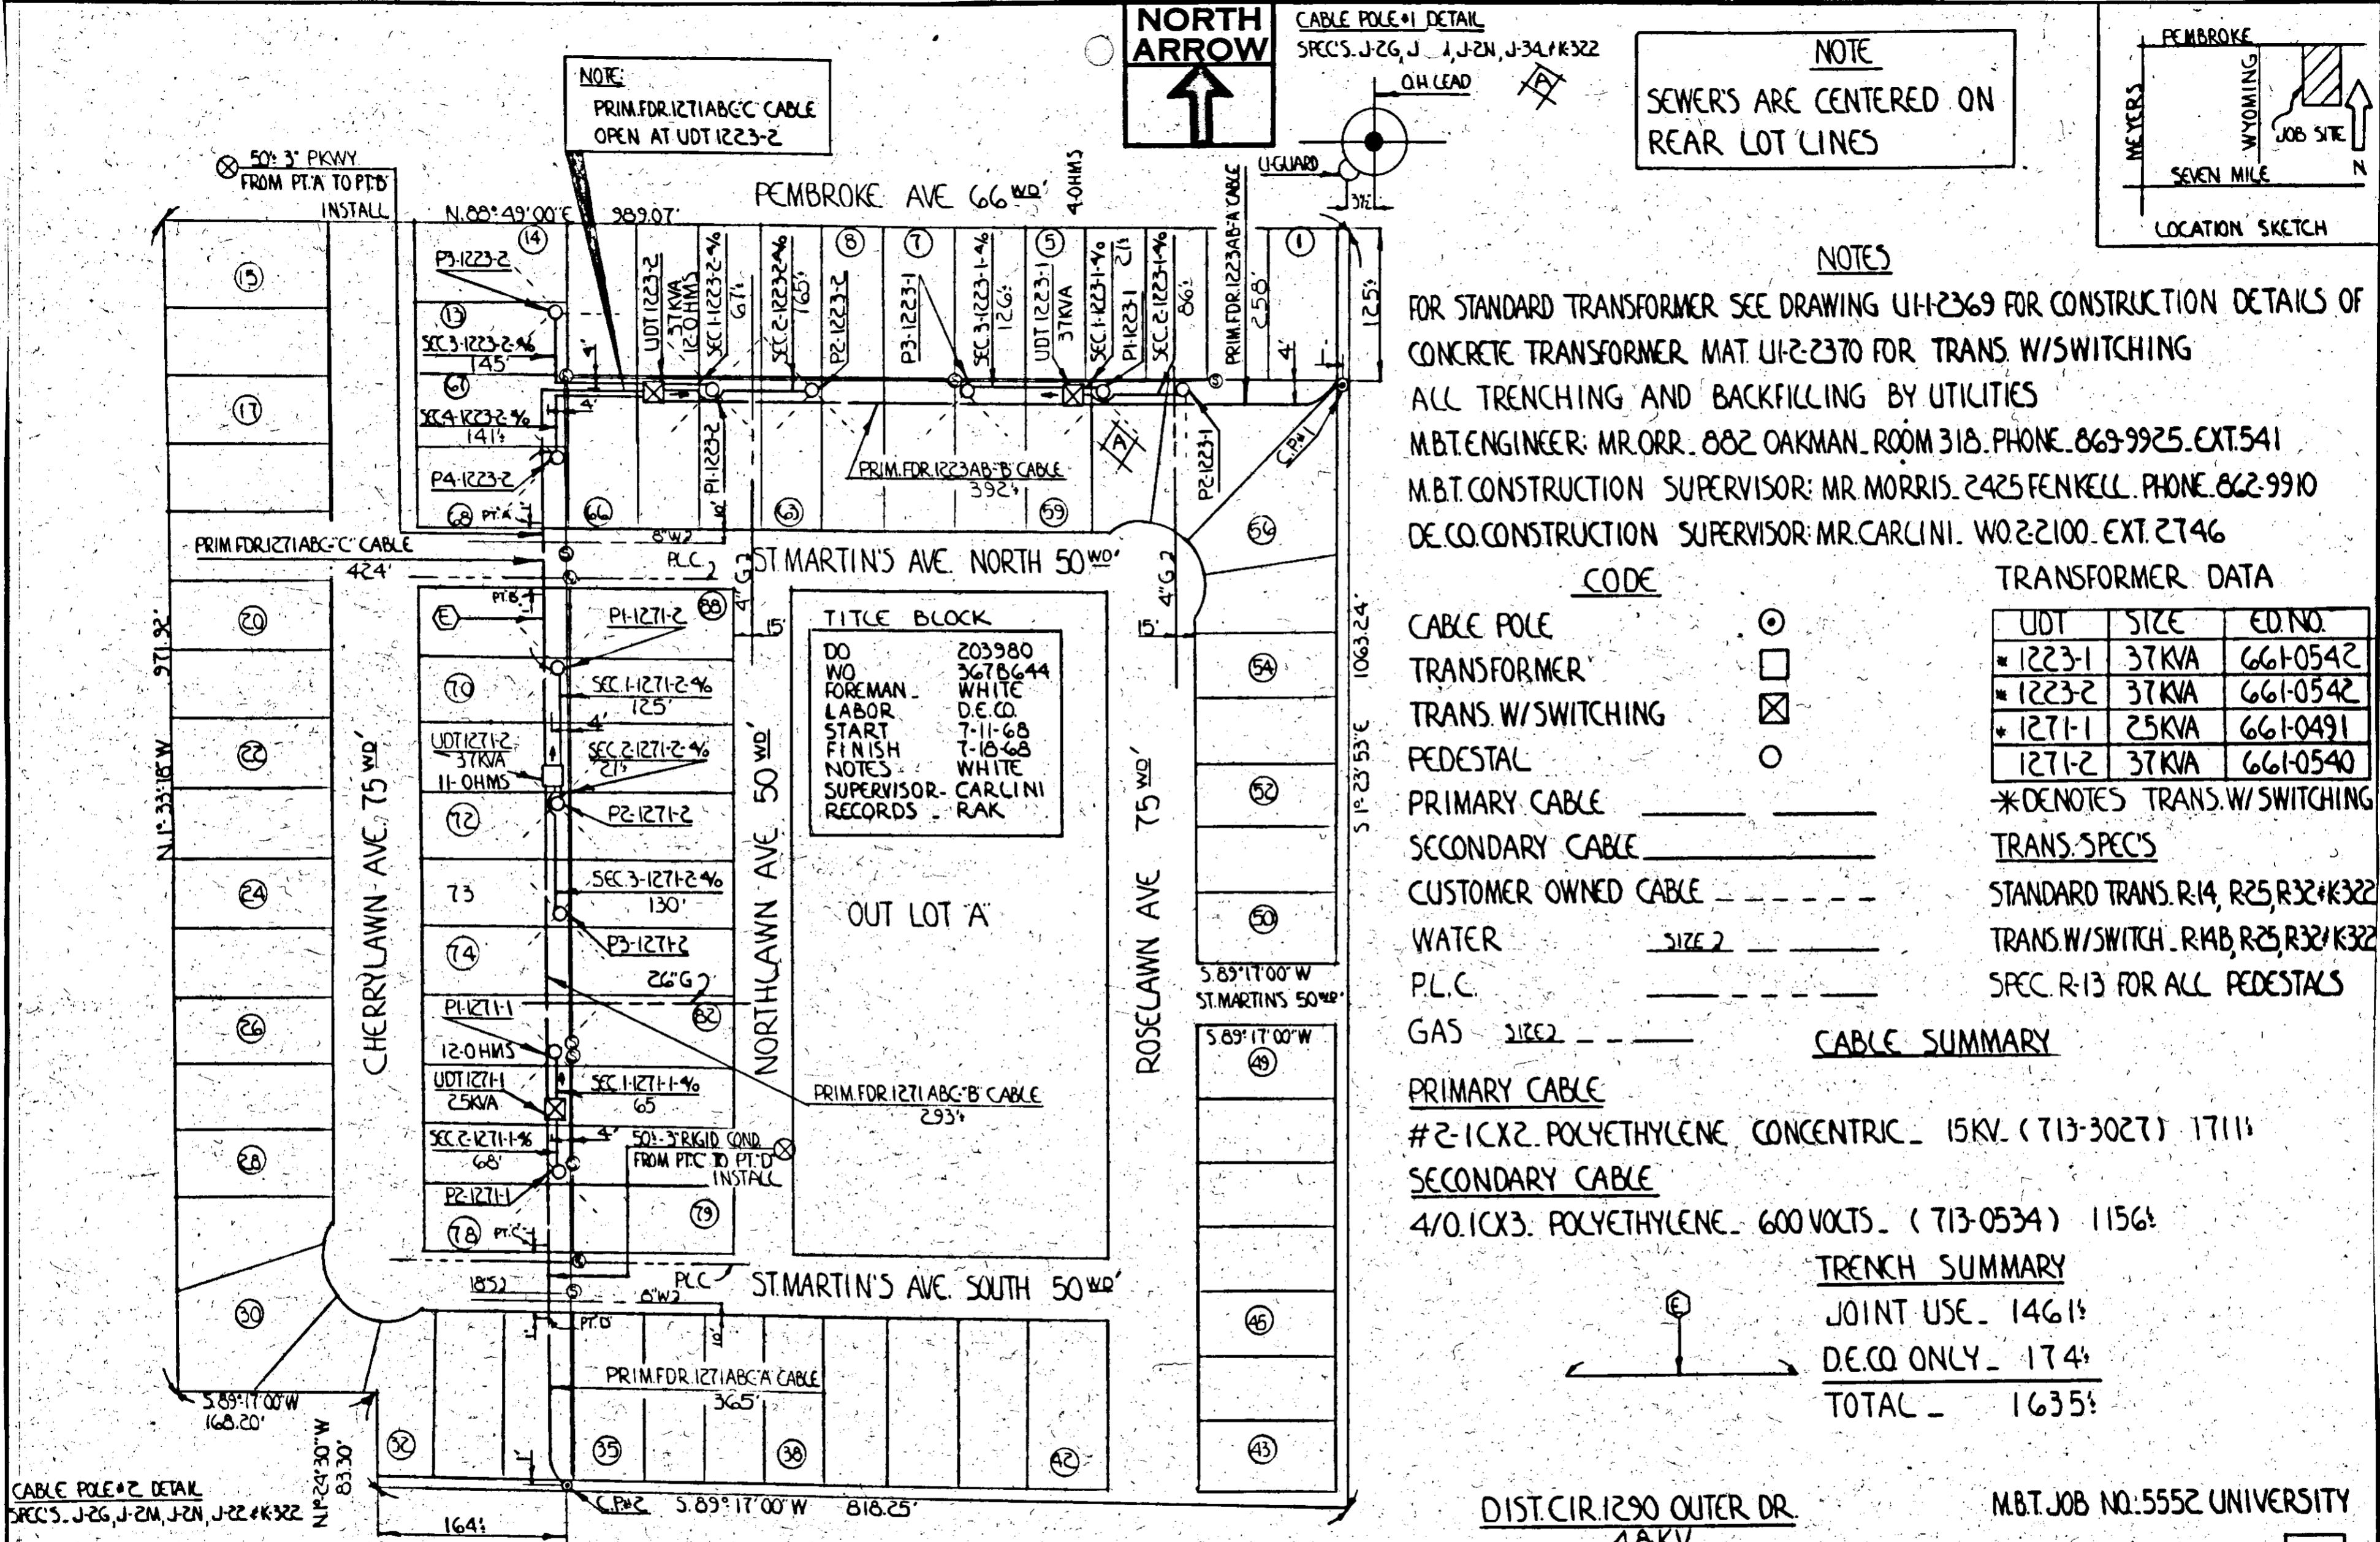

**CABLE POLE #2 DETAIL**

SPEC'S. J-2G, J-2M, J-2N, J-22 & K322

O.H. LEAD

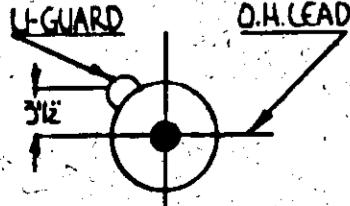

NOTE: REVISIONS: RETURN TO UNDERGROUND LINES  
DEPT. ALL PRINTS MADE PREVIOUS TO LAST REVISION  
• REVISED TO UDT 1223-1 CHANCE  
SHOW AS INSTALLED TO SWITCHER-3-3A  
IN FIELD WAS 3-22  
USE DIMENSIONS ONLY

SELECT E 1223-1 SELECT E 1223-2  
7-8-68 7-8-68 7-8-68

REF'D.  
ON  
APPROVED  
5-15-68  
5-15-68

SECRET 5-10-68  
REF'D. 5-15-68  
5-15-68  
CITY OF DETROIT WAYNE CO.

THE DETROIT EDISON COMPANY  
UNDERGROUND LINES DEPT. DETROIT, MICHIGAN  
SCALE 1=100' PRINTED 112-2-2254

DET. 258

DE FORM UL-2 PTC. 10-67

RECORDED RIGHT OF WAY NO. 26104