

100-Recorded
LIBER 1386 PAGE 538
-Page 1 of 8
APARTMENTS

LIBER 1349 PAGE 986

AGREEMENT - EASEMENT - RESTRICTIONS

This instrument made this 19th day of January, 1971,
by and between the undersigned Owners and THE DETROIT EDISON COMPANY, a corpora-
tion organized and existing concurrently under the laws of the states of
Michigan and New York, of 2000 Second Avenue, Detroit, Michigan 48226, hereinafter
called "EDISON", and MICHIGAN BELL TELEPHONE COMPANY, a Michigan corporation,
of 1365 Cass Avenue, Detroit, Michigan 48226, hereinafter called "BELL."

W I T N E S S E T H :

WHEREAS, Owners are erecting apartments known as Earhart Townhouses
Phase I and II, on land in the City of Ann Arbor,
County of Washtenaw, State of Michigan, as described in Appendix "A",
attached hereto and made a part hereof, and EDISON and BELL will install their
electric and communication facilities underground except necessary above ground
equipment.

NOW, THEREFORE, in consideration of the mutual promises and covenants
for the installation of underground utility service made by the parties hereto,
it is hereby agreed:

(1) The installation, ownership and maintenance of electric
services and the charges to be made therefor shall be subject to and in accordance
with the Orders and Rules and Regulations adopted from time to time by the
Michigan Public Service Commission.

(2) Owners must certify to EDISON and BELL that the easements are
graded to within four (4") inches of final grade before the underground facilities
are installed.

(3) If, subsequent to the installation by EDISON and BELL of their
facilities, it is necessary to move, modify, rearrange or relocate their
facilities to conform to a new plot plan or change of grade made by the Owners,
or if the utility facilities are damaged by acts of negligence on the part of
Owners or contractors for the Owners, the charges or repairs shall be made by
the utilities named herein, at the cost and expense of Owners, and shall be paid
forthwith to EDISON or BELL upon receipt of a statement therefor by Owners.
Owners are defined as those owning the land at the time changes are made or the
utilities are damaged.

(4) Owners hereby grant to EDISON and BELL easements for electric
and communication underground services in land herein described. When utility
lines are installed, this instrument shall be rerecorded with an "as installed"
drawing showing the location of utility facilities in relation to building lines
and indicating the easements by their centerlines. Easements herein granted shall
be six (6') feet in width unless otherwise indicated on said drawing.

(5) Easements herein granted are subject to the following
restrictions:

- a. Said easements shall be subject to Order of and the
Rules and Regulations adopted from time to time by the
Michigan Public Service Commission.
- b. Owners will place survey stakes indicating building plot
lines and property lines before trenching.

DE FORM LE 11 12 7005

THIS INSTRUMENT IS RE-RECORDED WITH "AS INSTALLED"
DRAWING AS STIPULATED IN PARAGRAPH 4.

RECEIVED
FOR RECORD

FEB 18 3 11 PM '71
PATRICIA NEWKIRK HIRBY
REGISTER OF CLERKS
WASHTENAW COUNTY, MICH.

RECEIVED
FOR RECORD

FEB 18 1972

RECORDED RIGHT OF WAY NO. 22558

- c. No shrubs or foliage shall be permitted on Owners' land within five (5') feet of front door of transformers or switching cabinet enclosures.
- d. Sanitary sewers shall be installed prior to installation of electric and communication lines. Sewer, water and gas lines may cross easements granted for electric and communication lines, but shall not be installed parallel within said easements.
- e. Owners shall make no excavations nor erect any structures within the easements identified on the "as installed" drawing. No excavations for fences shall be allowed within the limits of the utility easements provided for electric and communication lines unless prior written approval is secured from the utilities.
- f. Owners to provide for clearing the easements of trees, large stumps, and obstructions sufficiently to allow trenching equipment to operate.
- g. EDISON and BELL shall have the right of access at all times upon premises for the purposes of constructing, repairing, and maintaining their electric and communication lines and facilities.
- h. Any of the undersigned who are vendors on land contracts wherein a portion of the lands described herein are being sold shall not be liable to BELL or EDISON unless and until the interest of the vendees, under any such contracts, have been forfeited and damage to utility lines and equipment occurs after such forfeiture.

The provisions of this instrument shall run with the land and shall be binding upon and inure to the benefit of the respective heirs, administrators, executors, personal representatives, successors and assigns of the parties hereto.

IN WITNESS WHEREOF, the parties hereto have set their hands and seals this 19th day of January, 1971.

In the Presence of:

Margaret M. Stiefel
Margaret M. Stiefel

Irene C. Kata
IRENE C. KATA

THE DETROIT EDISON COMPANY

By [Signature]
R. Q. DUKE, DIRECTOR
Properties and Rights of Way Dept.

By Evelyn M. Lehman
Evelyn M. Lehman Assistant Secretary

MICHIGAN BELL TELEPHONE COMPANY

Marsha Pavelka
MARSHA PAVELKA

Karen Guenther
KAREN GUENTHER

By Carl T. Hall
CARL T. HALL Staff Supervisor
(Authorized Signatory)

Earhart Associates
A Michigan Co-partnership
860 W. Long Lake Road
Bloomfield Hills, Michigan

DE FORM LE 11 12 70CS

Alice J. Soper
Alice J. Soper

Dora M. Frederick
Dora M. Frederick

- 2 -

By: Richard D. Bleznak
Richard D. Bleznak, partner

By: Milton Smith
Milton Smith, partner
/D.

RECORDED RIGHT OF WAY NO. 10558

LIBER 1386 PAGE 540

Page 3 of 8
re-recorded

State of Michigan

County of Oakland


LIBER 1349 PAGE 988

On this 19th day of January, 19 71,

before me, a Notary Public, personally appeared Richard D. Bleznak and

Milton^{D.} Smith to me personally known, who being by me duly sworn, did
m respectively say that they (~~is~~, are) (~~is~~) member(s) of the partnership
known as Earhart Associates, a Michigan Co-partnership
which executed the within instrument and that they acknowledged said
instrument to be the free act and deed of the said partnership.

My commission expires: 12-22-72

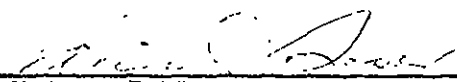
Notary Public
Alice J. Soper

Oakland County, Michigan

RECORDED RIGHT OF WAY NO. X6578

Page 4 of 8
re-recorded

STATE OF MICHIGAN)
) SS
COUNTY OF WAYNE)

On this 4th day of February, 1971, before me, the
subscriber, a Notary Public in and for said County, personally appeared
R. Q. Duke and Evelyn M. Lehman
to me personally known, who being by me duly sworn, did say that they are
the Director Prop. & R/W Dept. and an Assistant Secretary
of THE DETROIT EDISON COMPANY, a corporation organized and existing concurrently
under the laws of Michigan and New York, and that the seal affixed to said
instrument is the corporate seal of the said corporation, and that said instrument
was signed in behalf of said corporation by authority of its Board of Directors
and R. Q. Duke and Evelyn M. Lehman
acknowledged said instrument to be the free act and deed of said Corporation.

My Commission expires: June 24, 1972

Irene C. Kata
Notary Public IRENE C. KATA

Wayne County, Michigan

STATE OF MICHIGAN)
) SS
COUNTY OF OAKLAND)

On this 22nd day of JANUARY, 1971, before me, the
subscriber, a Notary Public in and for said County, appeared CARL T. HALL
to me personally known, who being by me duly sworn, did say that he is Staff
Supervisor of Right of Way, authorized by and for MICHIGAN BELL TELEPHONE COMPANY,
a Michigan Corporation, and that the said instrument was signed in behalf of said
Corporation, by authority of its Board of Directors, and CARL T. HALL
acknowledged said instrument to be the free act and deed of said Corporation.

My Commission expires: _____

Melford Hartman
Notary Public

County, Mich.

MELFORD HARTMAN
Notary Public, Wayne County, Mich.
Acting in Oakland County
My Commission Expires Oct. 3, 1971

RECORDED RIGHT OF WAY NO. 28558

re-recorded
LIBER 1386 PAGE 542

Page 5 of 8

APPENDIX "A"

LIBER 1349 PAGE 000

Being all of Outlot "K" and the south part of Outlot "G" of Earhart Subdivision is recorded in Liber 19 of Plats, Pages 20 through 25 Washtenaw County Records and more particularly described as: Earhart Townhouses; beginning at the S.E. corner of Outlot "K" of "Earhart Subdivision" a subdivision of part of the W. 1/2 of Section 25 and the E. 1/2 of Section 26 T2S, R6E, City of Ann Arbor, Washtenaw County as recorded in Liber 19, Pages 20 through 25 inc.; proceed thence N. 88° 02' 00" W. 676.22 ft. thence along the East line of Earhart road in the following courses: North 82.06 ft.; thence 193.46 ft. along the arc of a 1441.72 ft. radius curve concave to the Southeast through a central angle of 07° 41' 18" having a chord which bears N. 03° 50' 39" E. 193.32 ft., N. 07° 41' 18" E. 83.36 ft.; thence S. 82° 18' 42" E. along the Southerly line of Green Hills Drive; thence continuing along said Southerly line in the following two courses: 225.15 ft. along the arc of a 520.0 ft. radius curve concave to the Northwest having a central angle of 24° 48' 29" and a chord bearing N. 85° 17' 04" E. 223.40 ft.; 483.95 ft. along the arc of a 520.0 ft. radius curve concave to the Northwest having a central angle of 53° 19' 23" and a chord bearing N. 46° 13' 08" E. 466.67 ft.; thence South 709.57 ft. along the East line of said Outlot "K" to the Southeast corner of Outlot "K" and beginning at the Southwest corner of Outlot "G" of said Earhart Sub. thence along the Easterly line of Earhart Road in the following courses: N. 07° 41' 18" E. 58.50 ft. thence 209.56 ft. along the arc of a 1561.72 ft. radius curve concave to the Northwest having a central angle of 07° 41' 18" and a chord bearing N. 03° 50' 39" E. 209.41 ft. North 143.60 ft. thence S. 88° 02' 00" E. 470.65 ft. thence S. 01° 58' 00" W. 25.0 ft. thence S. 88° 02' 00" E. 115.71 ft. thence along the Northwesterly and Northerly line of Green Hills Drive in the following courses: 485.79 ft. along the arc of a 460.0 ft. radius curve concave to the Northwest having a central angle of 60° 30' 27" and a chord bearing S. 40° 01' 09" W. 463.52 ft. continuing 220.10 ft. along said 460.0 ft. radius curve having a central angle of 27° 24' 55" and a chord bearing S. 83° 58' 50" W. 218.01 ft. thence N. 82° 18' 42" W. 92.98 ft. to the point of beginning.

THE DETROIT EDISON COMPANY

ANN ARBOR DISTRICT

DISTRICT OFFICE
401 S. MAIN STREET
P.O. BOX 18
ANN ARBOR, MICH. 48107

October 7, 1970

Mr. Richard Blomak
Mr. Hy Stollman
Kerhart Assoc.
860 West Long Lake Road
Bloomfield Hills, Michigan 48013

Re: **Kerhart Townhouses, Step #1**
Ann Arbor City
Washtenaw County

Gentlemen:

Subject to our agreement with you for the installation of underground electric lines in the above project, The Detroit Edison Company, will own, install and maintain its electric lines and equipment and provide trenching in easements six (6') feet in width, which will be subsequently platted or provided by separate easement instrument at a cost to you of \$ 4,252.50 based on 3,150 estimated trench feet at the rate of \$ 1.35 per trench foot. This estimated cost is based on the location of lines and equipment as shown on the combined utility plan as approved on October 7, 1970. Upon completion, field measurements may require an adjustment in this cost figure.

Normally, trenching operations will not be undertaken during December, January, February, or March unless soil conditions are suitable. However, if you request us to trench under adverse conditions and will make payment to us for any additional costs to us over and above the trenching cost stated above, we will proceed with the installation.

The future maintenance of our electric lines in the proposed easements does not include repair of damage to our lines and equipment caused by you, your contractors, agents, employees, successors and assignees. If such damage should occur, we would expect reimbursement for repairs.

For your convenience, we will bill you on terms of thirty (30) days.

Please sign three of the enclosed copies and return them. You may retain the fourth copy for your file.

Very truly yours,

Howard E. Golder

Service Planner

ACCEPTED

Date: _____

Kerhart Assoc.
Richard D. Blomak

10/17/70

RECORDED RIGHT OF WAY NO.

26558

THE DETROIT EDISON COMPANY

ANN ARBOR DISTRICT

DISTRICT OFFICE
401 S MAIN STREET
P.O. BOX 18
ANN ARBOR, MICH. 48107

October 7, 1970

Mr. Richard Blaznak
Mr. Hy Stollman
Earhart Assoc
860 West Long Lake Road
Bloomfield Hills, Michigan 48013

Re: Earhart Townhouses, Step #2
Ann Arbor City
Washtenaw

Gentlemen:

Subject to our agreement with you for the installation of underground electric lines in the above project, The Detroit Edison Company, will own, install and maintain its electric lines and equipment and provide trenching in easements six (6') feet in width, which will be subsequently platted or provided by separate easement instrument at a cost to you of \$ 2,211.30 based on 1,638 estimated trench feet at the rate of \$ 1.35 per trench foot. This estimated cost is based on the location of lines and equipment as shown on the combined utility plan as approved on October 7, 1970. Upon completion, field measurements may require an adjustment in this cost figure.

Normally, trenching operations will not be undertaken during December, January, February, or March unless soil conditions are suitable. However, if you request us to trench under adverse conditions and will make payment to us for any additional costs to us over and above the trenching cost stated above, we will proceed with the installation.

The future maintenance of our electric lines in the proposed easements does not include repair of damage to our lines and equipment caused by you, your contractors, agents, employees, successors and assignees. If such damage should occur, we would expect reimbursement for repairs.

For your convenience, we will bill you on terms of thirty (30) days.

Please sign three of the enclosed copies and return them. You may retain the fourth copy for your file.

Very truly yours,

Edward E. Holden

Service Planner

ACCEPTED

Date: _____

Earhart Assoc
Richard A. Blaznak
10/13/70

RECORDED RIGHT OF WAY NO.

26-558

APARTMENTS

AGREEMENT - EASEMENT - RESTRICTIONS

This instrument made this 19th day of January, 1971, by and between the undersigned Owners and THE DETROIT EDISON COMPANY, a corporation organized and existing concurrently under the laws of the states of Michigan and New York, of 2000 Second Avenue, Detroit, Michigan 48226, hereinafter called "EDISON", and MICHIGAN BELL TELEPHONE COMPANY, a Michigan corporation, of 1365 Cass Avenue, Detroit, Michigan 48226, hereinafter called "BELL."

W I T N E S S E T H :

WHEREAS, Owners are erecting apartments known as Earhart Townhouses Phase I and II, on land in the City of Ann Arbor, County of Washtenaw, State of Michigan, as described in Appendix "A", attached hereto and made a part hereof, and EDISON and BELL will install their electric and communication facilities underground except necessary above ground equipment.

NOW, THEREFORE, in consideration of the mutual promises and covenants for the installation of underground utility service made by the parties hereto, it is hereby agreed:

(1) The installation, ownership and maintenance of electric services and the charges to be made therefor shall be subject to and in accordance with the Orders and Rules and Regulations adopted from time to time by the Michigan Public Service Commission.

(2) Owners must certify to EDISON and BELL that the easements are graded to within four (4") inches of final grade before the underground facilities are installed.

(3) If, subsequent to the installation by EDISON and BELL of their facilities, it is necessary to move, modify, rearrange or relocate their facilities to conform to a new plot plan or change of grade made by the Owners, or if the utility facilities are damaged by acts of negligence on the part of Owners or contractors for the Owners, the changes or repairs shall be made by the utilities named herein, at the cost and expense of Owners, and shall be paid forthwith to EDISON or BELL upon receipt of a statement therefor by Owners. Owners are defined as those owning the land at the time changes are made or the utilities are damaged.

(4) Owners hereby grant to EDISON and BELL easements for electric and communication underground services in land herein described. When utility lines are installed, this instrument shall be rerecorded with an "as installed" drawing showing the location of utility facilities in relation to building lines and indicating the easements by their centerlines. Easements herein granted shall be six (6') feet in width unless otherwise indicated on said drawing.

(5) Easements herein granted are subject to the following restrictions:

- a. Said easements shall be subject to Order of and the Rules and Regulations adopted from time to time by the Michigan Public Service Commission.
- b. Owners will place survey stakes indicating building plot lines and property lines before trenching.

- c. No shrubs or foliage shall be permitted on Owners' land within five (5') feet of front door of transformers or switching cabinet enclosures.
- d. Sanitary sewers shall be installed prior to installation of electric and communication lines. Sewer, water and gas lines may cross easements granted for electric and communication lines, but shall not be installed parallel within said easements.
- e. Owners shall make no excavations nor erect any structures within the easements identified on the "as installed" drawing. No excavations for fences shall be allowed within the limits of the utility easements provided for electric and communication lines unless prior written approval is secured from the utilities.
- f. Owners to provide for clearing the easements of trees, large stumps, and obstructions sufficiently to allow trenching equipment to operate.
- g. EDISON and BELL shall have the right of access at all times upon premises for the purposes of constructing, repairing, and maintaining their electric and communication lines and facilities.
- h. Any of the undersigned who are vendors on land contracts wherein a portion of the lands described herein are being sold shall not be liable to BELL or EDISON unless and until the interest of the vendees, under any such contracts, have been forfeited and damage to utility lines and equipment occurs after such forfeiture.

The provisions of this instrument shall run with the land and shall be binding upon and inure to the benefit of the respective heirs, administrators, executors, personal representatives, successors and assigns of the parties hereto.

IN WITNESS WHEREOF, the parties hereto have set their hands and seals this 19th day of January, 1971.

In the Presence of:

Margaret M. Stiefel
Margaret M. Stiefel

Irene C. Kata
IRENE C. KATA

Marsha Pavelka
MARSHA PAVELKA

Karen Guenther
KAREN GUENTHER

THE DETROIT EDISON COMPANY

By R. G. Duke
R. G. DUKE, DIRECTOR
Properties and Rights of Way Dept.

By Evelyn M. Lehman
Evelyn M. Lehman Assistant Secretary

MICHIGAN BELL TELEPHONE COMPANY

By Carl T. Hall
CARL T. HALL Staff Supervisor
(Authorized Signature)

By _____

Earhart Associates
A Michigan Co-partnership
860 W. Long Lake Road
Bloomfield Hills, Michigan

- 2 -

DE FORM LE II 12-70CS

Alice J. Soper
Alice J. Soper

Dora M. Frederick
Dora M. Frederick

BY: Richard D. Bleznak
Richard D. Bleznak, partner

BY: Milton Smith
Milton Smith, partner

D.

RECORDED RIGHT OF WAY NO. 26508

State of Michigan

County of Oakland

On this 19th day of January, 1971,

before me, a Notary Public, personally appeared Richard D. Bleznak and

Milton^{D.} Smith to me personally known, who being by me duly sworn, did

respectively say that they (~~is~~, are) (~~is~~ member(s) of the partnership

known as Earhart Associates, a Michigan Co-partnership

which executed the within instrument and that they acknowledged said

instrument to be the free act and deed of the said partnership.

My commission expires: 12-22-72

Alice J. Soper
Notary Public
Alice J. Soper

Oakland County, Michigan

RECORDED FIRST OF MAY 1971 26558

STATE OF MICHIGAN)
) SS
 COUNTY OF WAYNE)

On this 4th day of February, 1971, before me, the subscriber, a Notary Public in and for said County, personally appeared R. Q. Duke and Evelyn M. Lehman to me personally known, who being by me duly sworn, did say that they are the Director, Prop. & R/W Dept. and an Assistant Secretary of THE DETROIT EDISON COMPANY, a corporation organized and existing concurrently under the laws of Michigan and New York, and that the seal affixed to said instrument is the corporate seal of the said corporation, and that said instrument was signed in behalf of said corporation by authority of its Board of Directors and R. Q. Duke and Evelyn M. Lehman acknowledged said instrument to be the free act and deed of said Corporation.

My Commission expires: June 24, 1972

Irene C. Kata
 Notary Public **IRENE C. KATA**

Wayne County, Michigan

STATE OF MICHIGAN)
) SS
 COUNTY OF OAKLAND)

On this 22nd day of January, 1971, before me, the subscriber, a Notary Public in and for said County, appeared CARL T. HALL to me personally known, who being by me duly sworn, did say that he is Staff Supervisor of Right of Way, authorized by and for MICHIGAN BELL TELEPHONE COMPANY, a Michigan Corporation, and that the said instrument was signed in behalf of said Corporation, by authority of its Board of Directors, and CARL T. HALL acknowledged said instrument to be the free act and deed of said Corporation.

My Commission expires: _____

Melford Hartman
 Notary Public

_____ County, Mich.

MELFORD HARTMAN
 Notary Public, Wayne County, Mich.
 Acting in Oakland County.
 My Commission Expires Oct 3, 1971

RECORDED RIGHT OF WAY NO. 26558

APPENDIX "A"

Being all of Outlot "K" and the south part of Outlot "G" of Earhart Subdivision is recorded in Liber 19 of Plats, Pages 20 through 25 Washtenaw County Records and more particularly described as: Earhart Townhouses; beginning at the S.E. corner of Outlot "K" of "Earhart Subdivision" a subdivision of part of the W. 1/2 of Section 25 and the E. 1/2 of Section 26 T2S, R6E, City of Ann Arbor, Washtenaw County as recorded in Liber 19, Pages 20 through 25 inc.; proceed thence N. 88° 02' 00" W. 676.22 ft. thence along the East line of Earhart road in the following courses: North 82.06 ft.; thence 193.46 ft. along the arc of a 1441.72 ft. radius curve concave to the Southeast through a central angle of 07° 41' 18" having a chord which bears N. 03° 50' 39" E. 193.32 ft., N. 07° 41' 18" E. 83.36 ft.; thence S. 82° 18' 42" E. along the Southerly line of Green Hills Drive; thence continuing along said Southerly line in the following two courses: 225.15 ft. along the arc of a 520.0 ft. radius curve concave to the Northwest having a central angle of 24° 48' 29" and a chord bearing N. 85° 17' 04" E. 223.40 ft.; 483.95 ft. along the arc of a 520.0 ft. radius curve concave to the Northwest having a central angle of 53° 19' 23" and a chord bearing N. 46° 13' 08" E. 466.67 ft.; thence South 709.57 ft. along the East line of said Outlot "K" to the Southeast corner of Outlot "K" and beginning at the Southwest corner of Outlot "G" of said Earhart Sub. thence along the Easterly line of Earhart Road in the following courses: N. 07° 41' 18" E. 58.50 ft. thence 209.56 ft. along the arc of a 1561.72 ft. radius curve concave to the Northwest having a central angle of 07° 41' 18" and a chord bearing N. 03° 50' 39" E. 209.41 ft. North 143.60 ft. thence S. 88° 02' 00" E. 470.65 ft. thence S. 01° 58' 00" W. 25.0 ft. thence S. 88° 02' 00" E. 115.71 ft. thence along the Northwesterly and Northerly line of Green Hills Drive in the following courses: 485.79 ft. along the arc of a 460.0 ft. radius curve concave to the Northwest having a central angle of 60° 30' 27" and a chord bearing S. 40° 01' 09" W. 463.52 ft. continuing 220.10 ft. along said 460.0 ft. radius curve having a central angle of 27° 24' 55" and a chord bearing S. 83° 58' 50" W. 218.01 ft. thence N. 82° 18' 42" W. 92.98 ft. to the point of beginning.

RECORDED RIGHT OF WAY NO. 26558

MEMORANDUM ORDER
FOR GENERAL USE
DE FORM MS 77 12-53

TO Engineering Coordinator Supervisor
Dist: W H 250 Warren Service Center

DATE 1-29-71 TIME _____

Re: Underground Service, Karhart Townhouses Phase I and II, City of Ann Arbor,
Washtenaw County

Agreements and Easements received, OK to proceed with construction.

COPIES TO: H. Holden, Service Planner, Ann Arbor Office

SIGNED

Stephen A. McNamee
Stephen A. McNamee; lhd
Sr. Staff Attorney




REPORT _____

DATE RETURNED _____

TIME _____

SIGNED _____

RECORDED RIGHT OF WAY NO. 26558

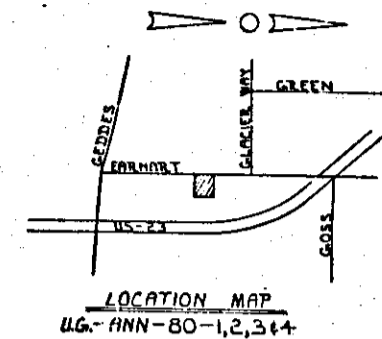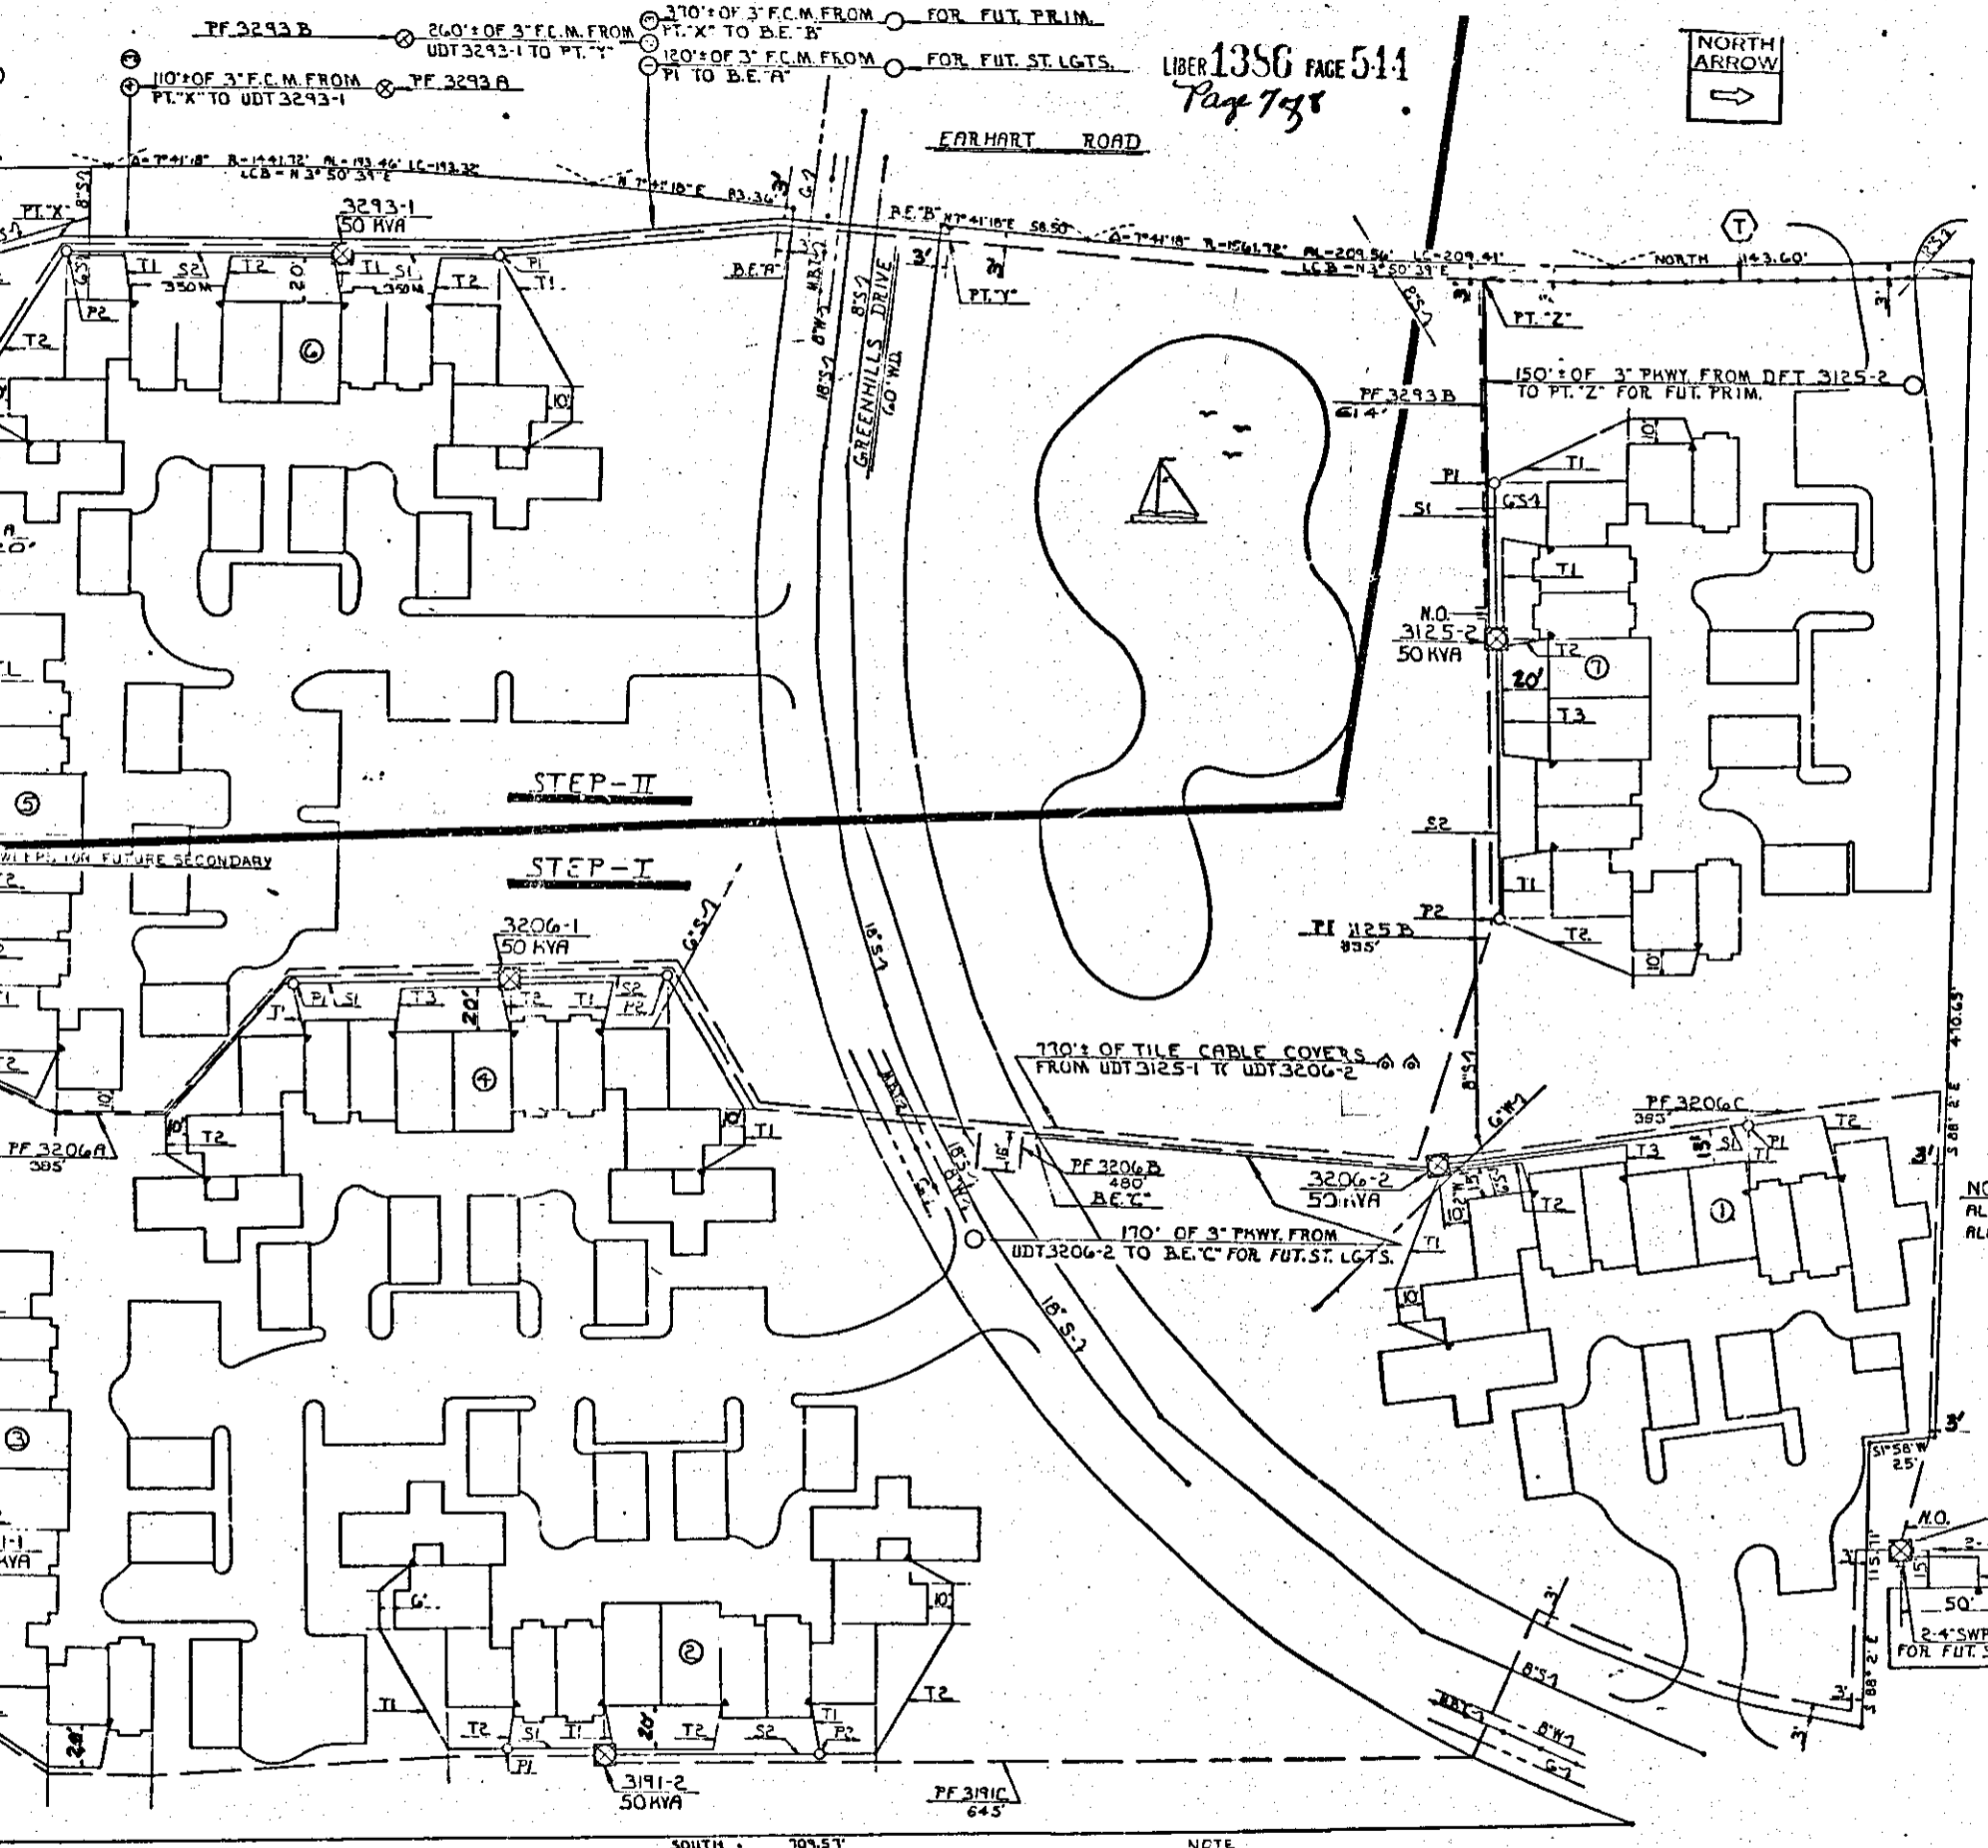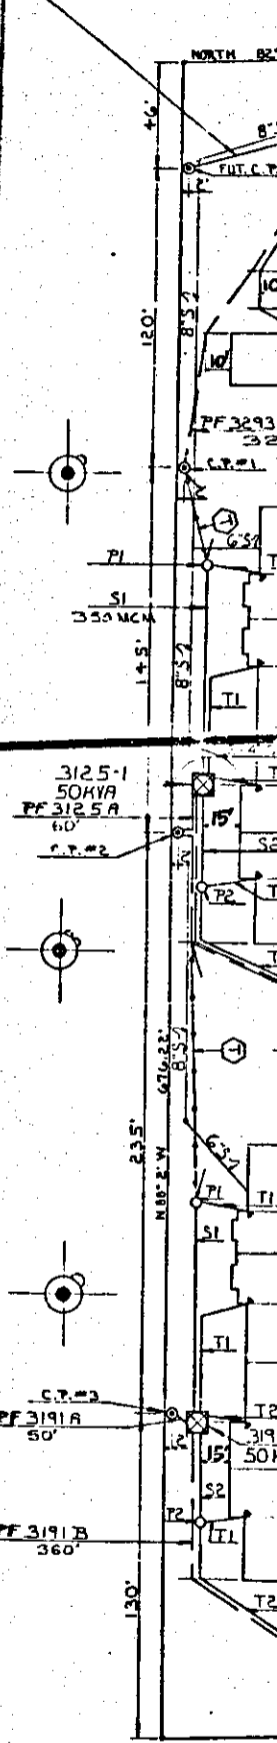

GENERAL NOTES
 M.B.T. TO DO ALL TRENCHING
 D.E.CO. CONSTRUCTION: MR. SCHMIDT
 PHONE: 662-0148
 M.B.T. ENGINEER: MR. LA BEAU
 PHONE: 761-0132
 M.B.T. CONTROL FOREMAN:
 PHONE: 665-8633
 SEE DRAWING U-1-2369 FOR CONC. MAT. DETAIL
 SEE DRAWING C.S.D.-675-11-DETAIL-'B' FOR ENTRANCE
 SERVICE PLANNER: MR. HOLDEN
 PHONE: 769-5880-EXT. 85353

CABLE SUMMARY	STEP-I	STEP-II
PRIMARY CABLE		
IT.NO. 455 2APECX1 132KX 713-3029	3,550'±	1,000'±
SECONDARY CABLE		
IT.NO. 445 500PEX2, 350X1 600X 713-0560	900'±	425'±
IT.NO. NONE 1/4"APX2, 1/4"X1 600X 713-0614	2,500'±	900'±

TRENCHING SUMMARY	STEP-I	STEP-II
JOINT USE	3,450'±	1,305'±
D.E.CO. ONLY		
M.B.T. ONLY	105'±	240'±
TOTAL	3,555'±	1,545'±

TRANS. DATA
 [8] 661-1152
 PEDESTAL SPEC. R-13 13-PEDESTALS
 CABLE POLE #14-3 SPECS. J-2F2, J-2M, J-2N, J-214-K-321
 CABLE POLE #2 SPECS. J-2F2, J-2M, J-2N, J-2214-K-321

NOTE:
 ALL SECONDARY TO PEDESTALS - 500M
 ALL SECONDARY TERMINALS - 1/4"

TITLE BLOCK - STEP I
 D.O. 213285
 W.O. 2678 616
 START 4-23-71
 FINISH 5-13-71
 FOREMAN L. PROSYK
 NOTES L. PROSYK
 RECORDS R. SCHMIDT
 G.F. KAUFFMAN

TITLE BLOCK - STEP II
 D.O. 213285
 W.O. 2678 616
 START 11-22-71
 LABOR D.E. CO.
 FOREMAN PROSYK
 NOTES PROSYK
 RECORDS SCHMIDT

CODE

□	PAD MOUNT TRANSFORMER
□	PAD MOUNT TRANSFORMER WITH SWITCHING
□	SECONDARY PEDESTAL
□	PRIMARY SWITCH CABINET
□	CABLE POLE
□	SECONDARY TERMINAL
→	DIRECTION TRANSFORMER DOOR OPENING
→	O.P.L. LIGHT FIXTURE
→	BURIED PRIMARY CABLE - ALL VOLTAGES
→	BURIED SECONDARY MAIN OR O.P.L. CABLE
→	DETROIT SECTION TRENCH ONLY
→	M.B.T. CO. TRENCH ONLY
→	PROPOSED CONDUIT
→	SEWER
→	WATER
→	GAS
→	BURIED CUSTOMER CABLE
⊠	DEAD FRONT TRANS.

NOTE:
 THE LOCATION OF SECONDARY SERVICES SHOWN ON THIS SKETCH ARE NOT GUARANTEED. CALL DETROIT EDISON BEFORE DIGGING ANY EXCAVATION.

DIST. CIR. 8248 WOLVERINE
 13.2 KV.
 M.B.T. JOB NO. 2259
 TID NO. NO. 267 B616

D	C	B	A	OTHER APPROVALS	DATE	BY	FOR
		AS INSTALLED IN FIELD JOB COMPLETE	AS INSTALLED IN FIELD JOB NOT COMPLETE				

PERMITS REQ'D
 CITY OF ANN ARBOR

DISTRICT DIRECT BURIED SYSTEM
 EARHART TOWNHOUSES
 N.W. 1/4 SECTION 25
 T. 2 S. R. 6 E.

CITY OF ANN ARBOR, WASHTENAW CO. AUG-4-2374 SHEET 1 OF 1 SHEETS

RECORDED RIGHT OF WAY NO. 26558