THIS C

MAS 1.

11. 7¹¹]

IN PARAGRAPH 4.

7741 ad a

(LIBER 5677 PAGE 324)

100 5776 BE 129

AG., Line TricTIONS

by and between the undersigned Comers and Tall LETROIT EDISON COLPAIN, a corporation organized and embrying concorrently under the laws of the states of Michigan and New York, of 2000 second Avenue, Letroit, Michigan, 46226, hereinafter called "EDISON", and MICHIGAN ELECTRICAL COMPANY, a Michigan corporation, of 1365 Cass Avenue, Detroit, Michigan, 46226, hereinafter called "BELL".

<u>WITNESSETH:</u>
WHEREAS, Owners are erecting apartments known as Fairmont Farms
, on land in the City of Pontiac ,
County of Oakland , State of Michigan, as described in Appendix "A", attache hereto and male a part hereof, and EDISON and EELL will install their electric and communication facilities underground except necessary above ground equipment.
NOW, THEREFORE, in consideration of the mutual promises and covenants for the installation of underground utility service made by the parties hereto, it is hereby agreed:
(1) The installation, ownership and maintenance of electric services and the charges to be made therefor shall be subject to and in accordance with the Orders and Rules and Regulations adopted from time to time by the Michigan Public Service Commission.
(2) Owners must certify to IDISON and BELL that the easements are graded to within four (4") inches of final grade before the underground facilities are installed.
(3) Owners further agree that if subsequent to the installation of the utility facilities of EDISON and BELL, it is necessary to repair, move, modify, rearrange or relocate any of their facilities to conform to a new plot plan or change of grade or for any cause or changes attributable to public authority having jurisdiction or to Owners action or request, Owners will pay the cost and expense of repairing, moving, rearrangement or relocating said facilities to EDISON or BELL upon receipt of a statement therefor. Further, if the lines or facilities of EDISON and BELL are damaged by acts of negligence on the part of the Owners or by contractors engaged by Owners, repairs shall be made by the utilities named herein at the cost and expense of the Owners and reimbursement shall be paid to EDISON or BELL upon receiving a statement therefor. Owners are defined as those persons owning the land at the time damage occurred.
(4) Owners hereby grant to EDISON and RELL easement for electric and communication underground services in land herein described. When utility lines are installed, this instrument shall be re-recorded with an "as installed" drawing showing the location of utility facilities in relation to building lines and indicatin the easements by their communication.
c. No shorts or Tolican shall be permitted on Owners land within five

(51) feet of front door of temps? Ors or switching cabinet enclosures.

26778

IN THE PRESENCE OF:

Terry

LIBER 5776 PAGE 130

- d. Sanitary sewers shall be installed prior to installation of electric and communication lines. Sewer, water and gas lines may cross casements granted for electric and communication lines, but shall not be installed <u>parallel</u> within said easements.
- e. Owners shall make no excavations nor erect any structures within the easements identified on the "as installed" drawing. No excavations for fences shall be allowed within the limits of the utility easements provided for electric and communication lines unless prior written approval is secured from the utilities.
- f. Owners to provide for clearing the easements of trees, large stumps, and obstructions sufficiently to allow trenching equipment to operate.
- g. EDISON and BELL shall have the right of access at all times upon premises for the purposes of constructing, repairing, and maintaining their electric and communication lines and facilities.
- h. Any of the undersigned who are vendors on land contracts wherein a portion of the lands described herein are being sold shall not be liable to EELL or EDISON unless and until the interest of the vendees, under any such contracts, have been forfeited and damage to utility lines and equipment occurs after such forfeiture.

The provisions of this instrument shall run with the land and shall be binding upon and inure to the benefit of the respective heirs, administrators, executors, personal representatives, successors and assigns of the parties hereto.

IN WITNESS WHEREOF, the parties hereto have set their hands and seals on the day and year forst above written.

THE DETROIT EDISON COMPANY

Salan Janes

Richard A. Roeser,

YKMYMMHXXXXXXXX Executive Vice President

Hazel L. Brandau

Hazel L. Brandau

Real Estate and Rights of Way Dept.

BY

MARSHA PAVELKA

MICHIGAN BELL TELEPHONE COMPANY

By

CARL T. HALL

Staff Supervisor, Right of Way

(Authorized Signature)

Company

C

State of Michigan

County of Oakland

	·
 -	May , 19 71 , before me appeared
Richard A. Poeser	and Walter P. Young
to me personally known, who being by	me severally duly sworn, did say that they
are respectively Executive Vice Pre	sident and Secretary
of Charles L. Langs Incorporated	, a corporation created and existing
under the laws of the State of Michi	gan and that the said instrument was signed
and sealed in behalf of said corpora	tion by authority of its Board of Directors
Richard A. Roeser and the said <u>MEMMMANNIMAM</u>	and Walter P. Young
acknowledged the said instrument to	be the free act and deed of the said
corporation	A Committee of the comm
My commission expires: 5-14-74	Notary Public Betty J. Sage
	Oakland County, Michigan

APPENDIX "A"

Part of the W 1/2 of the SE 1/4 of Section 18, T3N, R10E, City of Pontiac, Oakland County, Michigan is described as beginning at a point on the E & W 1/4 line of said Section 18, distant S. 85° 09' 27" W. along said E & W 1/4 line 1312.10 ft. from the E 1/4 corner of said Section 18, thence S. 1° 56' 33" E. along the west line of "Assessor's Plat No. 144" Subdivision (L. 5, P. 57, O.C.R.) 1099.65 ft., thence S. 87° 49' 06" W. 393.15 ft. thence N. 2° 02' 10" W. 1083.55 ft. to said E & W 1/4 line 395.32 ft. to the point of beginning.

Budding but a but we are 100 76/10

SYNTH OF HICHICAN)

SS

COUNTY OF MARKE)

MELFORD HARTMAN
Notary Public, Wayne Obunty, Mich.
Acting in C. R. ad County
My Control of Large 84, 604, 6, 1371

DO SHIP CO. STATE STATE SOUTHFILL NUMBER 4, 075

T MEMORANDUM ORDER FOR GENERAL USE DE FORM MS 77 12-53 TORIG. Coordinator Sup	CTV1865 - H-250 W.S.C. DATE 6-7-71 TIME
Fairmon	Farms - Pentiec - Oakland County
	ned OK to proceed with construction.
COPIES TO D. Hiller - Postiac Ser. Ctr.	signed
REPORT	P. A. Marquardt Low Department
	
DATE RETURNED TIME	
DATE RETURNED TIME	

RECORDED RIGHT OF

AGREFMENT - EASEMENT - RESTRICTIONS

This instrument made this 27th day of May by and between the undersigned Owners and THE DETROIT EDISON COMPANY, a corporation organized and existing concurrently under the laws of the states of Michigan and New York, of 2000 Second Avenue, Detroit, Michigan, 48226, hereinafter called "EDISON", and MICHIGAN BELL TELEPHONE COMPANY, a Michigan corporation, of 1365 Cass Avenue, Detroit, Michigan, 48226, hereinafter called "BELL".

WITNESSETH:

	WHEREAS,	Owners are	e erecting	apartments	known as_	Fairmont F	0.170S	<u>.</u>
		on	land in the	he City	of	Pontiac		
County of	Oakland		State of	Michigan,	as describe	ed in Appen	dix "A",	attached
hereto and	d made a	part hereo:	f, and EDI	SON and BEL	L will inst	tall their	electric	and
communica	tion faci	lities und	erground e	xcept neces	sary above	ground equ	ipment.	

NOW, THEREFORE, in consideration of the mutual promises and covenants for the installation of underground utility service made by the parties hereto, it is hereby agreed:

- (1) The installation, ownership and maintenance of electric services and the charges to be made therefor shall be subject to and in accordance with the Orders and Rules and Regulations adopted from time to time by the Michigan Public Service Commission.
- (2) Owners must certify to EDISON and BELL that the easements are graded to within four (4") inches of final grade before the underground facilities are installed.
- (3) Owners further agree that if subsequent to the installation of the utility facilities of EDISON and BELL, it is necessary to repair, move, modify, rearrange or relocate any of their facilities to conform to a new plot plan or change of grade or for any cause or changes attributable to public authority having jurisdiction or to Owners action or request, Owners will pay the cost and expense of repairing, moving, rearrangement or relocating said facilities to EDISON or BELL upon receipt of a statement therefor. Further, if the lines or facilities of EDISON and BELL are damaged by acts of negligence on the part of the Owners or by contractors engaged by Owners, repairs shall be made by the utilities named herein at the cost and expense of the Owners and reimbursement shall be paid to EDISON or BELL upon receiving a statement therefor. Owners are defined as those persons owning the land at the time damage occurred.
- (μ) Owners hereby grant to EDISON and BELL easement for electric and communication underground services in land herein described. When utility lines are installed, this instrument shall be re-recorded with an "as installed" drawing showing the location of utility facilities in relation to building lines and indicating the easements by their centerlines. Easements herein granted shall be six (6') feet in width unless otherwise indicated on said drawing.
 - (5) Easements herein granted are subject to the following restrictions:
- a. Said easements shall be subject to Order of and the Rules and Regulations on time to time by the Michigan Public Service Commission.

 b. Owners will place survey stakes indicating building plot lines and ines before trenching.

 c. No shrubs or foliage shall be permitted on Owners land within five of front door of transformers or switching cabinet enclosures. adopted from time to time by the Michigan Public Service Commission.
- property lines before trenching.
- (5') feet of front door of transformers or switching cabinet enclosures.

Harriset (har)

-1-

- d. Sanitary sewers shall be installed prior to installation of electric and communication lines. Sewer, water and gas lines may cross easements granted for electric and communication lines, but shall not be installed parallel within said
- e. Owners shall make no excavations nor erect any structures within the easements identified on the "as installed" drawing. No excavations for fences shall be allowed within the limits of the utility easements provided for electric and communication lines unless prior written approval is secured from the utilities.
- f. Owners to provide for clearing the easements of trees, large stumps, and obstructions sufficiently to allow trenching equipment to operate.
- g. EDISON and RELL shall have the right of access at all times upon premises for the purposes of constructing, repairing, and maintaining their electric and communication lines and facilities.
- h. Any of the undersigned who are vendors on land contracts wherein a portion of the lands described herein are being sold shall not be liable to BELL or EDISON unless and until the interest of the vendees, under any such contracts, have been forfeited and damage to utility lines and equipment occurs after such forfeiture.

The provisions of this instrument shall run with the land and shall be binding upon and inure to the benefit of the respective heirs, administrators, executors, personal representatives, successors and assigns of the parties hereto.

IN WITNESS WHEREOF, the parties hereto have set their hands and seals on the day and year forst above written.

IN THE PRESENCE OF:

THE DETROIT EDISON COMPANY

W. CARNOLD. DIRECTOR Real Estate and Rights of Way Dept.

CARROLL

ASST. SECRETARY

COM AVA 30 LAULE .

MICHIGAN BELL TELEPHONE COMPANY

ORD HARTMAN

CARL T. HALL

Staff Supervisor, Right of Way

(Authorized Signature)

Charles L. Lange Incorporated

A Michigan Corporation

785 Auburn Avenue Pomiliac, Michigan

MEMBERS, Executive Vice Presid

Richard Roeser

Walter P. Young, Secretary


County of Oakland	
On this <u>27th</u> day of Richard A. Roeser	May 19 71, before me appeared and Walter P. Young
to me personally known, who being by are respectively Executive Vice Pre	me severally duly sworn, did say that they
of Charles L. Langs Incorporated	a corporation created and existing
under the laws of the State of Michigan	gan and that the said instrument was signed
and sealed in behalf of said corporations and the said Theres Market	
acknowledged the said instrument to l	be the free act and deed of the said
corporation	
My commission expires: 5-14-74	Notary Public Betty J. Sage
	Oakland County, Michigan

APPENDIX "A"

Part of the W 1/2 of the SE 1/4 of Section 18, T3M, R10E, City of Pontiac, Oakland County, Michigan is described as beginning at a point on the E & W 1/4 line of said Section 18, distant S. 85° 09' 27" W. along said E & W 1/4 line 1312.10 ft. from the E 1/4 corner of said Section 18, thence S. 1° 56' 33" E. along the west line of "Assessor's Plat No. 144" Subdivision (L. 5, P. 57, O.C.R.) 1099.65 ft., thence S. 87° 49' 06" W. 393.15 ft. thence N. 2° 02' 10" W. 1083.55 ft. to said E & W 1/4 line 395.32 ft. to the point of beginning.

STATE OF MICHIGAN)			•	
SS COUNTY OF WAYNE)				
On this 9th day of	June	, 19 <u>_</u> 71,	before me, the	
subscriber, a Notary Public in and				
W. C. Arnold	and	Lillian ∫.H.	Carroll	_
to me personally known, who being				
the Director, RE & R/W Dept.	and a	n Assistant Sec	retary	
of THE DETROIT EDISON COMPANY, a c				rently
under the laws of Michigan and New	_			
instrument is the corporate seal o				
was signed in behalf of said corpo				•
and W. C. Arnold				
acknowledged said instrument to be				
. •				
My Commission expires: June 24, 19	972	Notary Publ	IC TRENE C KAT	
		•	ebz. O. KAI	A
		Way	ne Coun	ty, Michigan
STATE OF MICHIGAN)				
COUNTY OF OAKLAND)				
On this 1st day of 0.1.	1 MG	_, 19 <u>_7/</u> , be	fore me, the	
subscriber, a Notary Public invand				LL
to me personally known, who being				
Supervisor of Right of Way, author				
a Michigan Corporation, and that the	-			
Corporation, by authority of its B			CARL T. HALL	
acknowledged said instrument to be			fossid Corporatio	on.
_	arc 1100 d	Mind	1 this	
My Commission expires:		Notary Publ	C TWEEN	2n
		V	C,	ounty, Mich.
				,

MELFORD HARTMAN
Notary Public, Waken County, Mich.
Acting in Calland County
My Commission expires Oct. 3, 1971

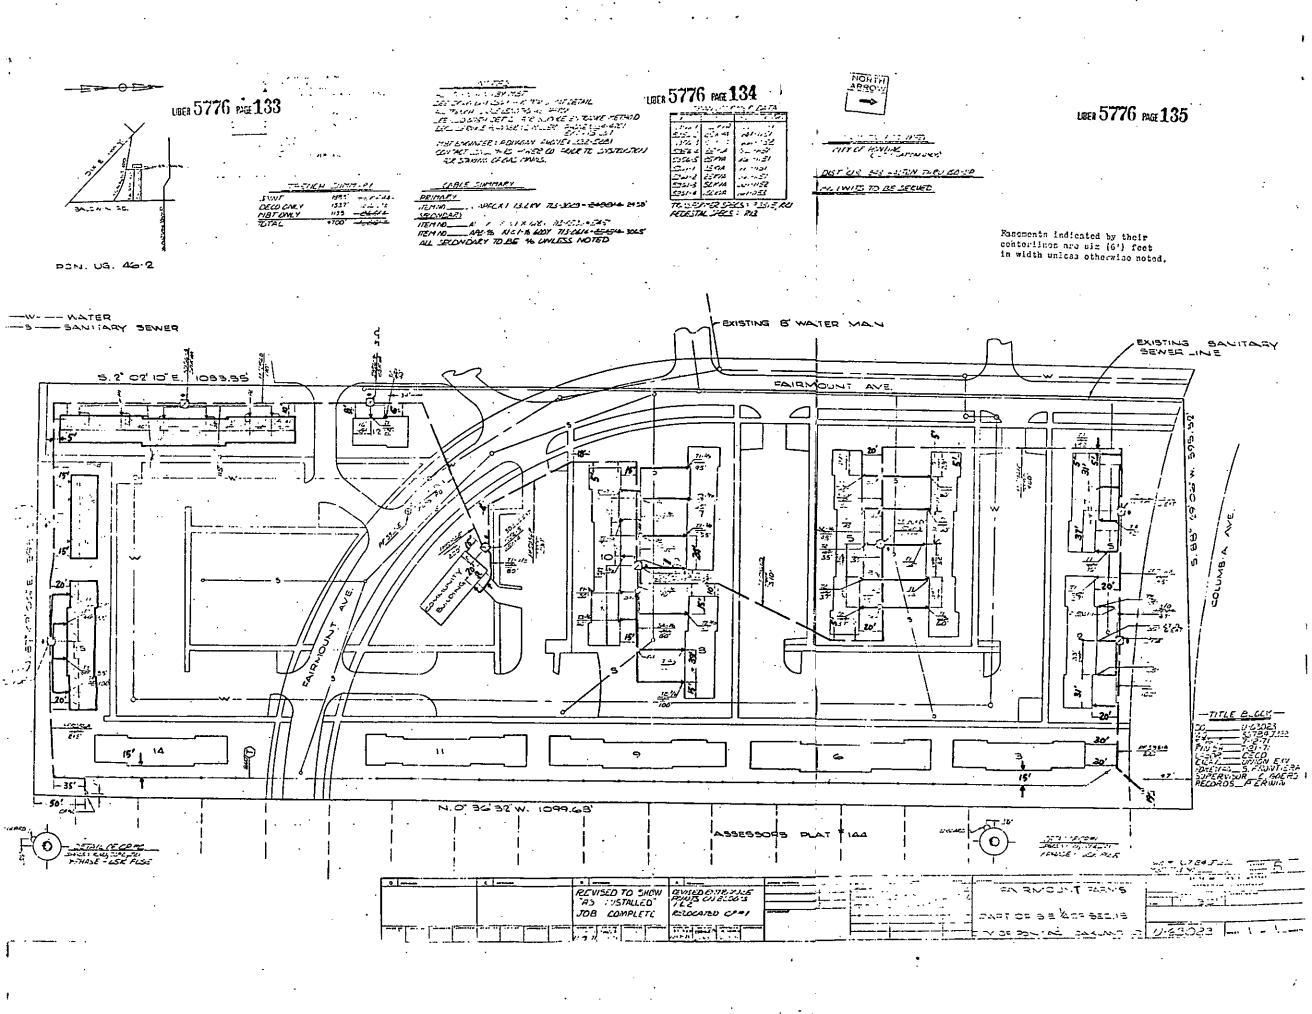

RECORDED RIGHT OF WAY NO. 26778