

2 11/21

IN CONSIDERATION of the sum of One Dollar (\$1.00) and other valuable considerations, receipt of which is hereby acknowledged, the right is hereby granted and conveyed to THE DETROIT EDISON COMPANY, 2000 Second Avenue, Detroit, Michigan, and the MICHIGAN BELL TELEPHONE COMPANY, 1365 Cass Avenue, Detroit, Michigan, their licensees, lessees, successors, and assigns, to construct line facilities for the purpose of providing electric service and communication service, including necessary poles, guys, anchors, wires, and equipment, in, upon, over, and across the property located in

City of Troy Township or Municipality County of Oakland State of Michigan,

further described as follows: Land in the City of Troy, Oakland County, Michigan, part of N.E. 1/4 of Section 21, Township 2 North, Range 11 East, described as beginning at a point on the East line of Section 21, Township 2 North, Range 11 East, distant North 0°21' East, 233.5 feet from the East 1/4 corner of said Section 21; thence North 0°21' East 90.5 feet to a point, thence North 89°51'30" West 1325.21 feet to a point; thence South 0°13' West 90.5 feet to a point; thence South 89°51'30" East, 1325 feet to the point of beginning.

with full right of ingress and egress upon the said premises to employes or appointees of the said grantees to construct, reconstruct, repair, operate, and maintain said line facilities, and to trim or cut down any trees which, in the opinion of the grantees, at any time interfere or threaten to interfere with the construction and operation of said line facilities.

The route of the line facilities is described as follows: In a northerly and southerly direction across said land, along a line 46 feet West of and parallel to the center line of Livernois Road.

In addition to the above consideration, the total sum of Five and no/100 (\$5.00) - - Dollars shall be paid to the grantee before construction is completed.

This grant is hereby declared binding upon the heirs, successors, and assigns of the undersigned grantor

IN WITNESS WHEREOF, we have hereunto set our hand and seal this 20TH day of OCTOBER 19 76

WITNESS Mrs. Thomas Ressler
MRS. THOMAS RESSLER

Paul E. Agroll
Walter E. Touchie
WALTER E. TOUCHIE

SIGNED Earl E. Amell
Earl E. Amell

Evelyn M. Amell
Evelyn M. Amell

Walter E. Touchie
30400 Telegraph
Birmingham, Michigan 48010

3533 LIVERNOIS
TROY, MI. 48084

DRAFTED BY ↑

STATE OF MICHIGAN }
County of OAKLAND } s s

On this 20TH day of OCTOBER A.D. 19 76, before me, the undersigned,

a notary public in and for said county, personally appeared EARL E. AMELL AND EVELYN M. AMELL, HIS WIFE."


known to me to be the person S named in and who executed the foregoing instrument as grantor S and acknowledged the same to be THEIR free act and deed. Walter E. Touchie

My commission expires JAN. 7, 1978

Notary Public WALTER E. TOUCHIE County, Michigan.

APPROVED AS TO FORM 6-6-77 DATE 3.00
LEGAL DEPARTMENT

RECORDED RIGHT OF WAY NO. 31124
OAKLAND COUNTY MICHIGAN REGISTER OF DEEDS RECORDS
817 AUG 26 PM 3:56
LYNN D. ALLEN CLERK-REGISTER OF DEEDS

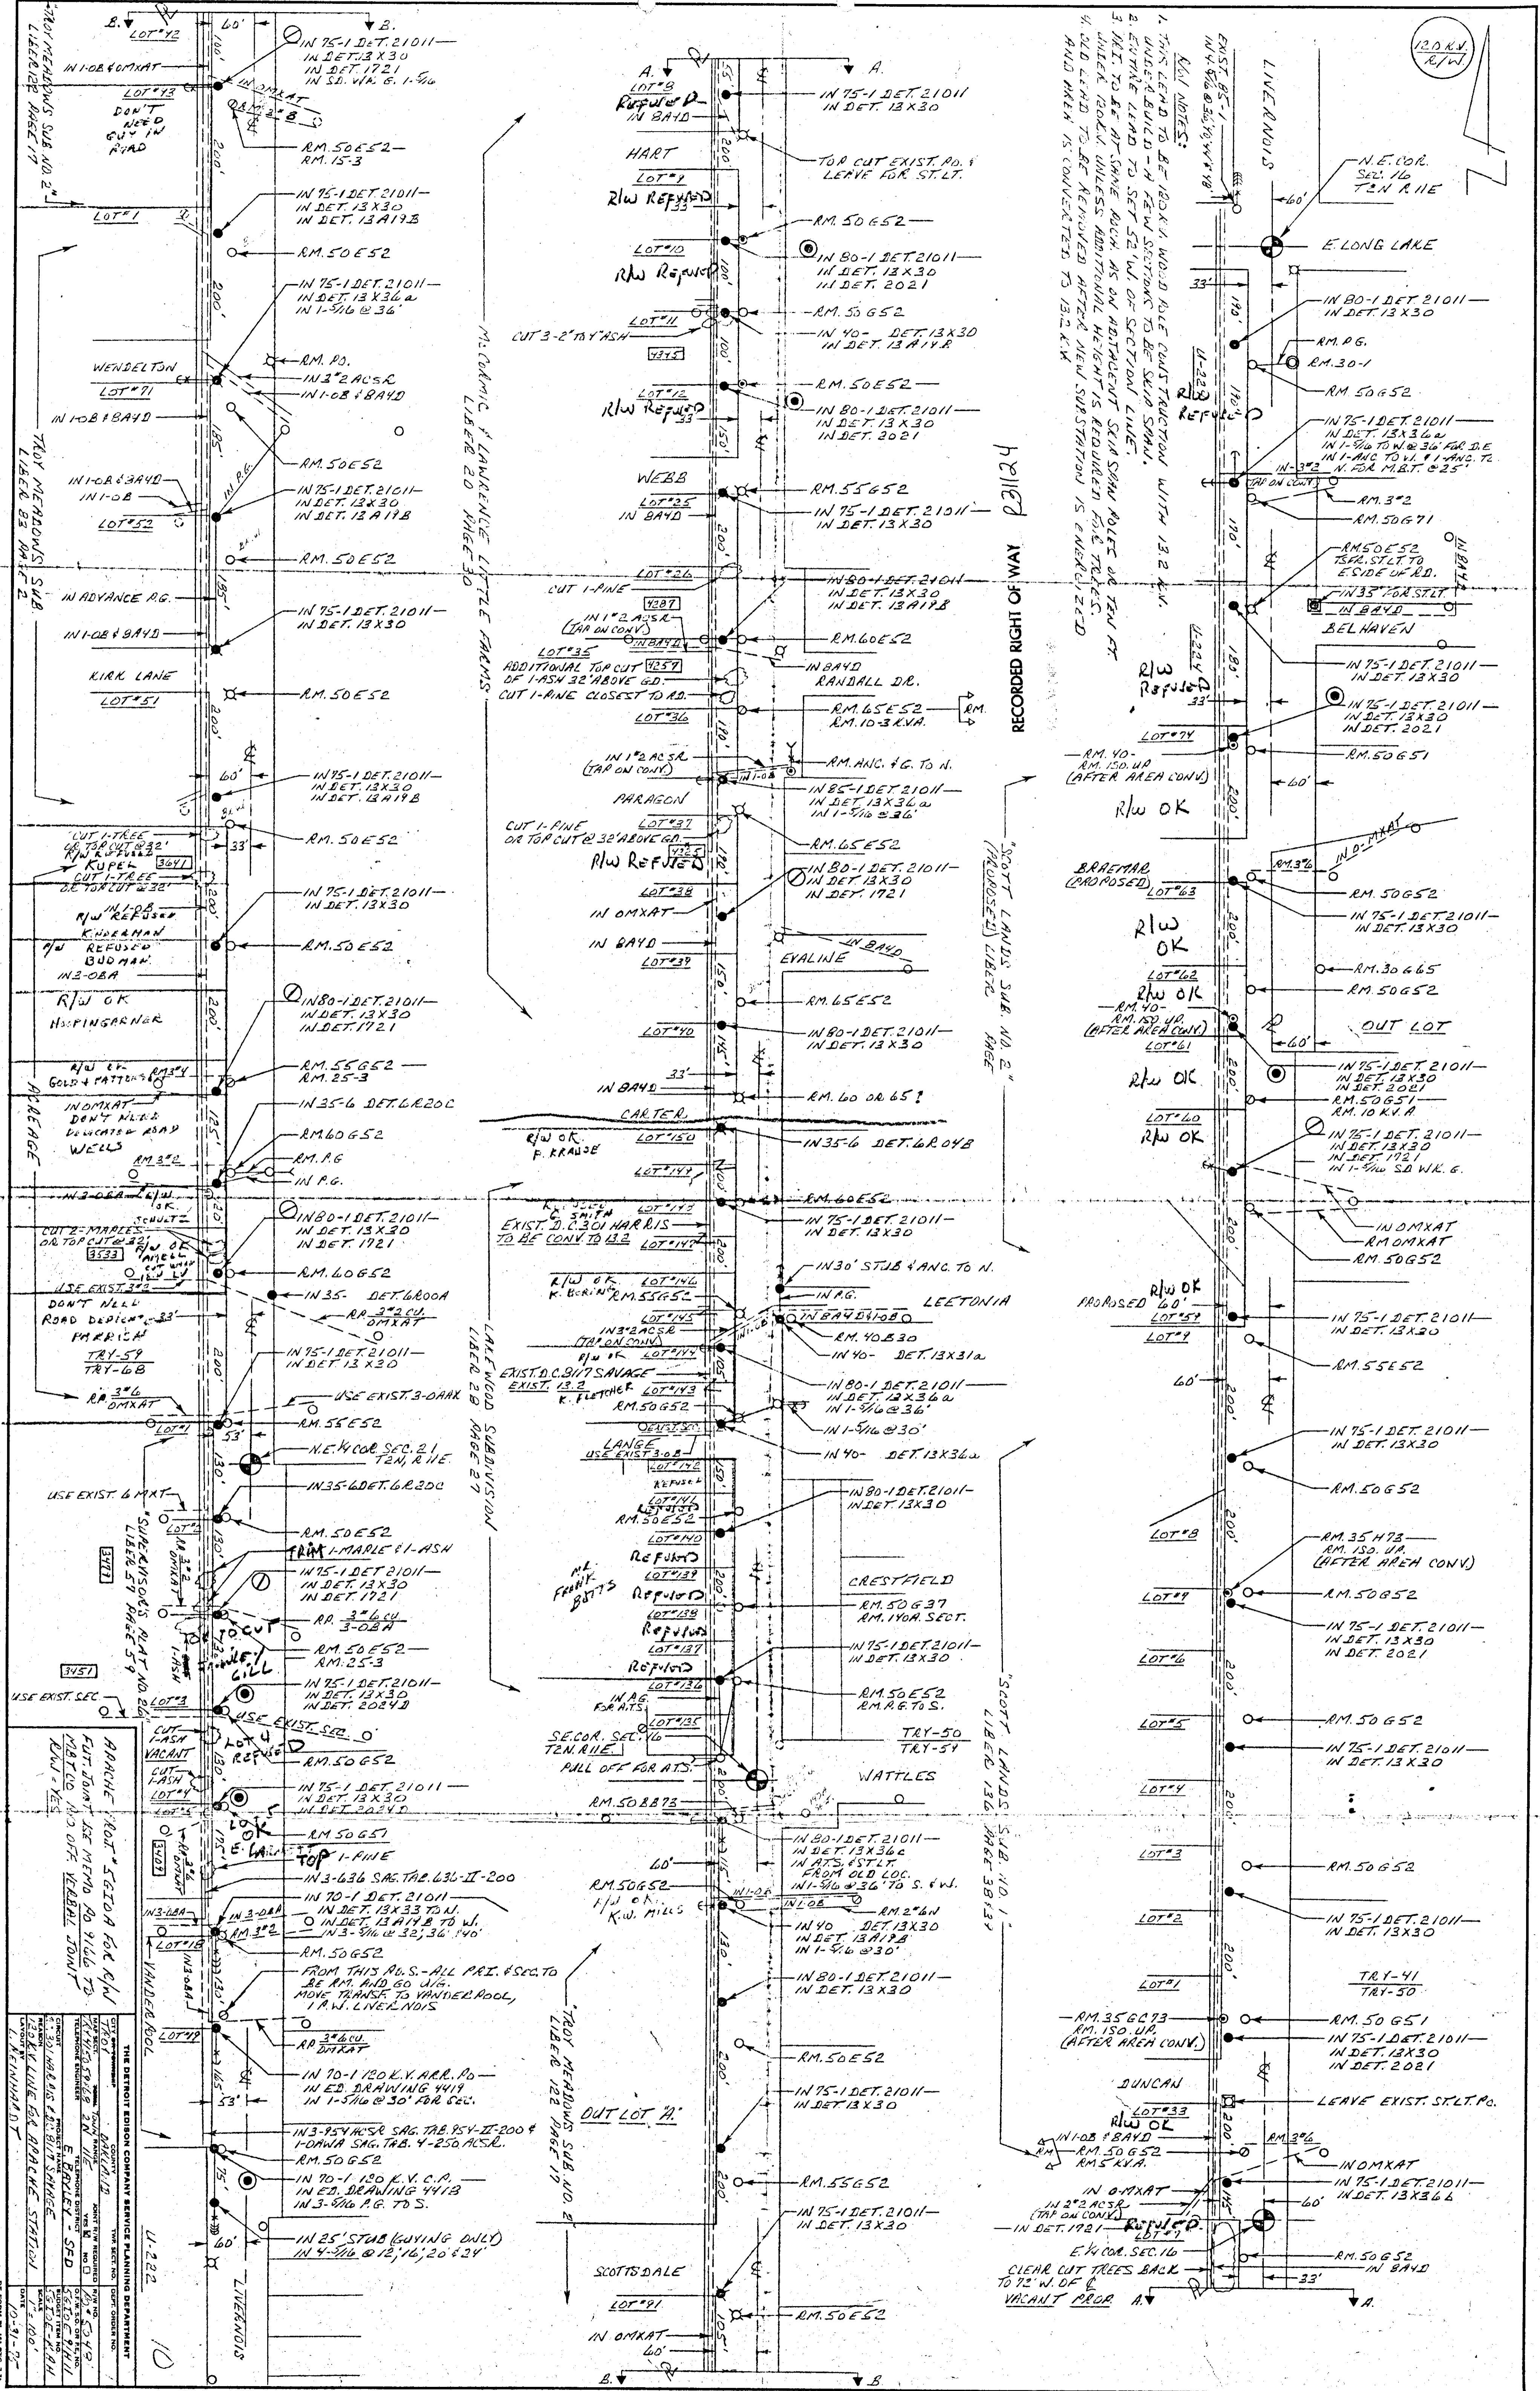


 N.E. COR. SEC. 16 T2N R11E
 E. LONG LAKE
 BELHAVEN
 SCOTT LANDS SUB. NO. 2

TROY MEADOWS SUB. NO. 2

 (SEE 3451)

THE DETROIT Edison COMPANY SERVICE PLANNING DEPARTMENT

120 K.V. R/W




R31124

RECORDED RIGHT OF WAY NO. 31123/4