

For good and valuable considerations, the right is hereby granted to THE DETROIT EDISON COMPANY, 2000 Second Ave. Detroit, Michigan, their licensees, lessees, successors and assigns, to construct aerial line facilities for the purpose of providing electric service and communication service including necessary poles, guys, anchors, conduits, wires, cables, manholes, transformers and equipment in, under, upon, over and across the property located in the village of

Lake Orion, County of Oakland, State of Michigan, further described as follows:

The East 12 feet of the West 29 feet of the following described property:

Part of the northeast 1/4, Section 11, Town 4 North, Range 10 East, Lot 57,

Assessor's Replat of Deckers Addition as Recorded in Liber 52 of Plats, Page

17, Oakland County Records.

with full right of ingress and egress upon the said premises to employes or appointees of the said grantees to construct, reconstruct, repair, operate and maintain said line facilities, and to trim or cut down any trees which in the opinion of the grantees at any time interfere or threaten to interfere with the construction and operation of said line facilities.

The route of overhead line facilities is described as follows:

In a northerly and southerly direction across said land, along a line approximately 52 feet East of and parallel to the centerline of Lapeer Road (M-24).

Underground lines are to be located in accordance with attached drawings which are hereby made a part of and incorporated into this grant.

This grant is hereby binding upon the heirs, successors and assigns of the undersigned grantors.

IN WITNESS WHERE OF we have hereunto set our hands and seal this 21st day of September 1979

WITNESS.

Marguerite V. Borst
Marguerite V. Borst

James D. McDonald
James D. McDonald

Bruce C. Jacobsen
Bruce C. Jacobsen

Marilyn E. Jacobsen
Marilyn E. Jacobsen

Harold S. Jacobsen Jr.
Harold S. Jacobsen Jr.

Marjorie J. Jacobsen
Marjorie J. Jacobsen A/K/A.
Marjorie Jacobsen

PREPARED BY:

James McDonald
30400 Telegraph
Birmingham, Michigan 48010

STATE OF MICHIGAN
County of Oakland

On this 21st day of September A.D. 1979, before me, the undersigned, a Notary Public in and for said county, personally appeared Bruce C. Jacobsen and Marilyn E. Jacobsen, husband and wife and to an undivided 1/2 interest, and Harold S. Jacobsen, Jr. and Marjorie J. Jacobsen, A/K/A. Marjorie Jacobsen, husband and wife and to an undivided 1/2 interest known to me to be the persons named in and who executed the foregoing instrument as grantors and acknowledged the same to be their free act and deed.

James D. McDonald
James D. McDonald

My commission expires: 5-9-83

Notary Public, Oakland County, Michigan

(Return over)

3.00


RECORDED RIGHT OF MAY NO. 38143

RECORDED
MICHIGAN
REGISTER OF DEEDS
OAKLAND COUNTY
APR 11 AM 11 00
48035

THE DETROIT Edison COMPANY SERVICE PLANNING DEPARTMENT	
TOTAL	
40	



NEW LEAD TO SET 112W OF Q OF LAPEER RD.
NEW POLES TO BE 204 OR HIGHER - 120KV CONST. WITH 13KV UNDERBUILD.

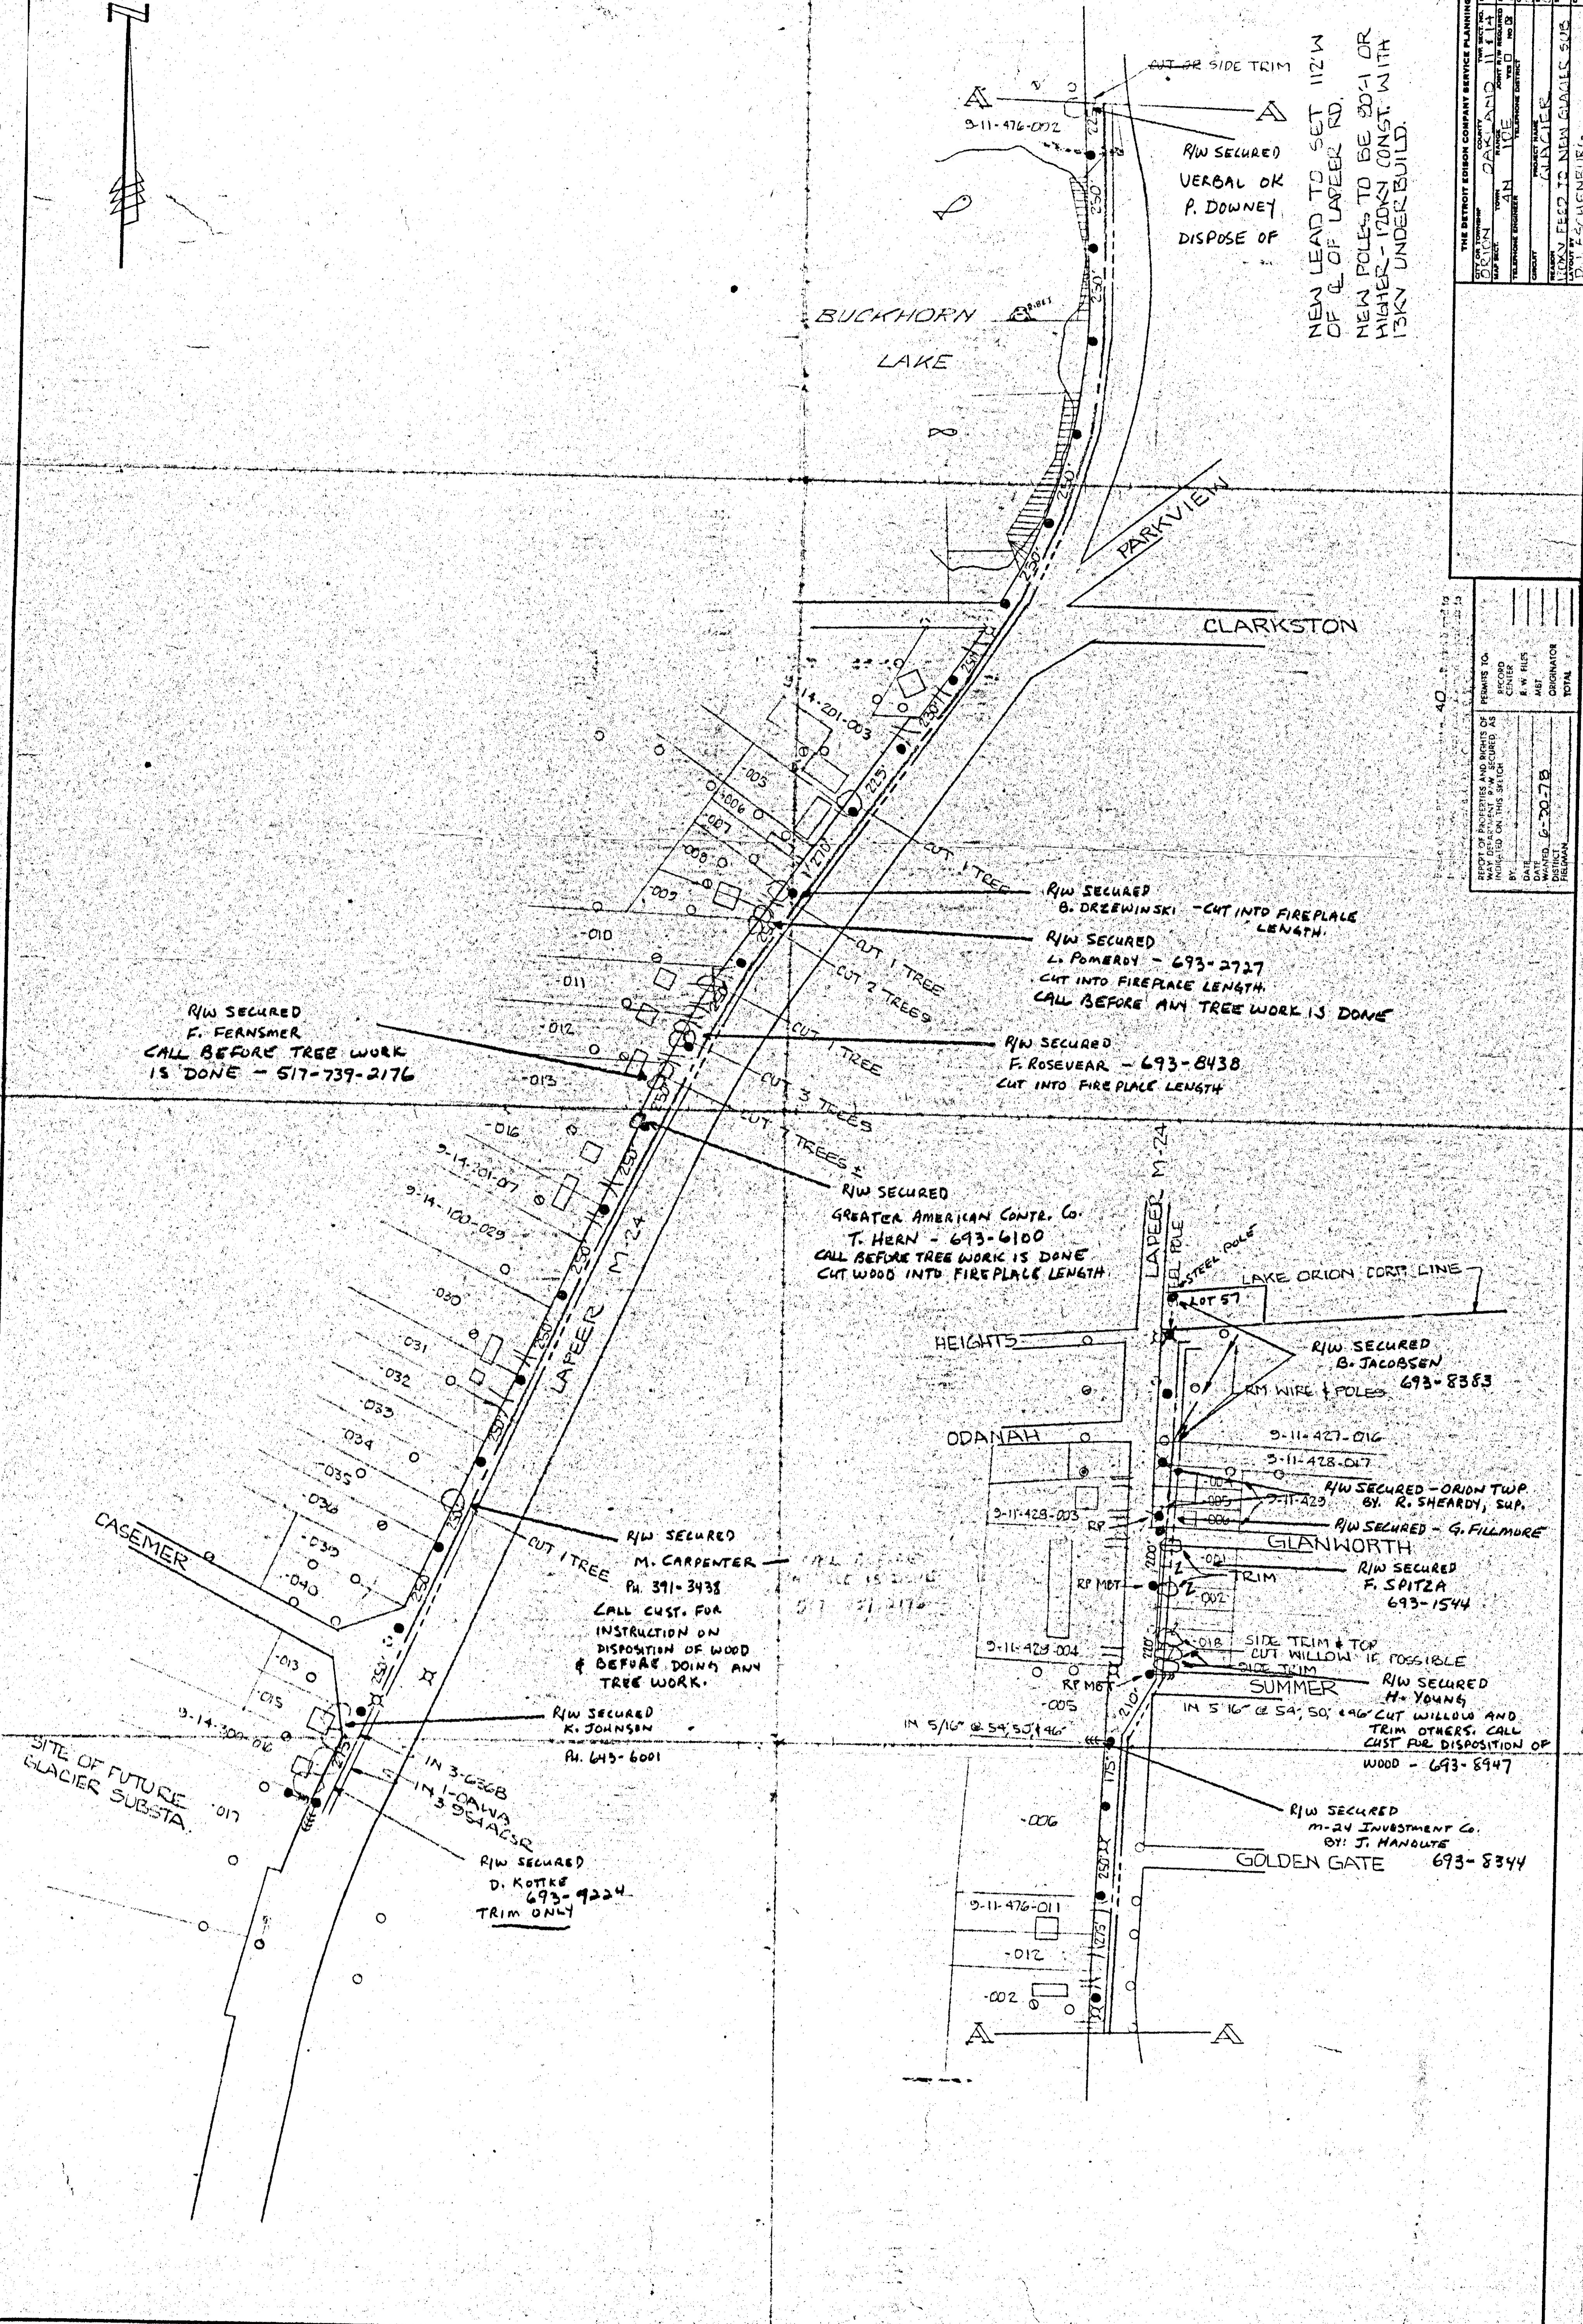

REPORT OF PROPERTIES AND RIGHTS OF WAY DEPARTMENT	PERMITS TO
INDICATED ON THIS SHEET	RECORD
TOTAL	
40	