

For good and valuable considerations, the right is hereby granted to THE DETROIT EDISON COMPANY, 2000 Second Ave. Detroit, Michigan, and the MICHIGAN BELL TELEPHONE COMPANY, 1365 Cass Avenue, Detroit, Michigan, their licensees, lessees, successors and assigns, to construct aerial and/or underground line facilities for the purpose of providing electric service and communication service including necessary poles, guys, anchors, conduits, wires, cables, manholes, transformers and equipment in, under, upon, over and across the property located in the TOWNSHIP of

INDEPENDENCE, County of OAKLAND, State of Michigan, further described as follows:
PART OF THE W 1/2 OF FRC, SECT 7, T4N R9E BEG AT THE S.W. COR OF SAID SECTION 7, TH N 0-07-40 W ALG THE W LINE OF SAID SECTION 7 A DIST OF 1990.36 FT; TH N 87-53-21 E 547.27 FT; TH ON A CURVE TO THE LEFT (RAD= 429.84 FT LONG CHORD BEARS S 42-04-03 W 233.18 FT) A DIST OF 236.07 FT, TH S 26-20 W 355.24 FT, TH ON A CURVE TO THE LEFT (RAD= 304.87 FT, LONG CHORD BEARS S 13-01-06 E 386.67 FT) A DIST OF 418.79 FT, TH S 49-43-30 W 220.25 FT; TH S 0-07-40 E 726.41 FT; TH S 27-51-42 W 319.61 FT TO P.O.B.

with full right of ingress and egress upon the said premises to employes or appointees of the said grantees to construct, reconstruct, repair, operate and maintain said line facilities, and to trim or cut down any trees which in the opinion of the grantees at any time interfere or threaten to interfere with the construction and operation of said line facilities.

The route of overhead line facilities is described as follows:

Underground lines are to be located in accordance with attached drawing which is a part of this instrument and easements are six feet in width unless otherwise noted on said drawing.

This grant is hereby binding upon the heirs, successors and assigns of the undersigned grantor.

IN WITNESS WHEREOF we have hereunto set our hands and seal this 13th day of NOV, 1980.

WITNESS:

William H. Scruggs
WILLIAM H. SCRUGGS
5510 CHICKADEE
CLARKSTON, MICH.
49016

WILLIAM H. SCRUGGS

Richard K. Hovitch
RICHARD K. HOVITCH

ADDRESS Gayle Susan Hovitch
GAYLE SUSAN HOVITCH, AKA
HIS WIFE, S. HOVITCH
ADDRESS 6441 OLD COACH TRAIL
WASHINGTON, MICH.
48094.

PREPARED BY: 12093 CHEVELLE ALFRED STEIGER
STEARNS RD M 48077

DON CRANKSHAW
1075 SUNCREST DR.
LAPEER, MICH.
48446.

ADDRESS

STATE OF MICHIGAN

County of Oakland } s.s.

On this 13 day of November A.D. 1980, before me, the undersigned, a Notary Public in and for said county, personally appeared Richard K. Hovitch & Gayle Susan Hovitch
AKA GAYLE S. HOVITCH, HIS WIFE known to me to be the person S named in and who executed

the foregoing instrument as grantor S and acknowledged the same to be their free act and deed.

PEGGY G. PIERCE
Notary Public in and for the State of Michigan
My Commission Expires December 21, 1981


Peggy G. Pierce
PEGGY G. PIERCE

My commission expires: December 21, 1981

Notary Public, Oakland County, Michigan

APPROVED AS TO FORM 1-28-81 DATE
LEGAL DEPARTMENT Bader

110

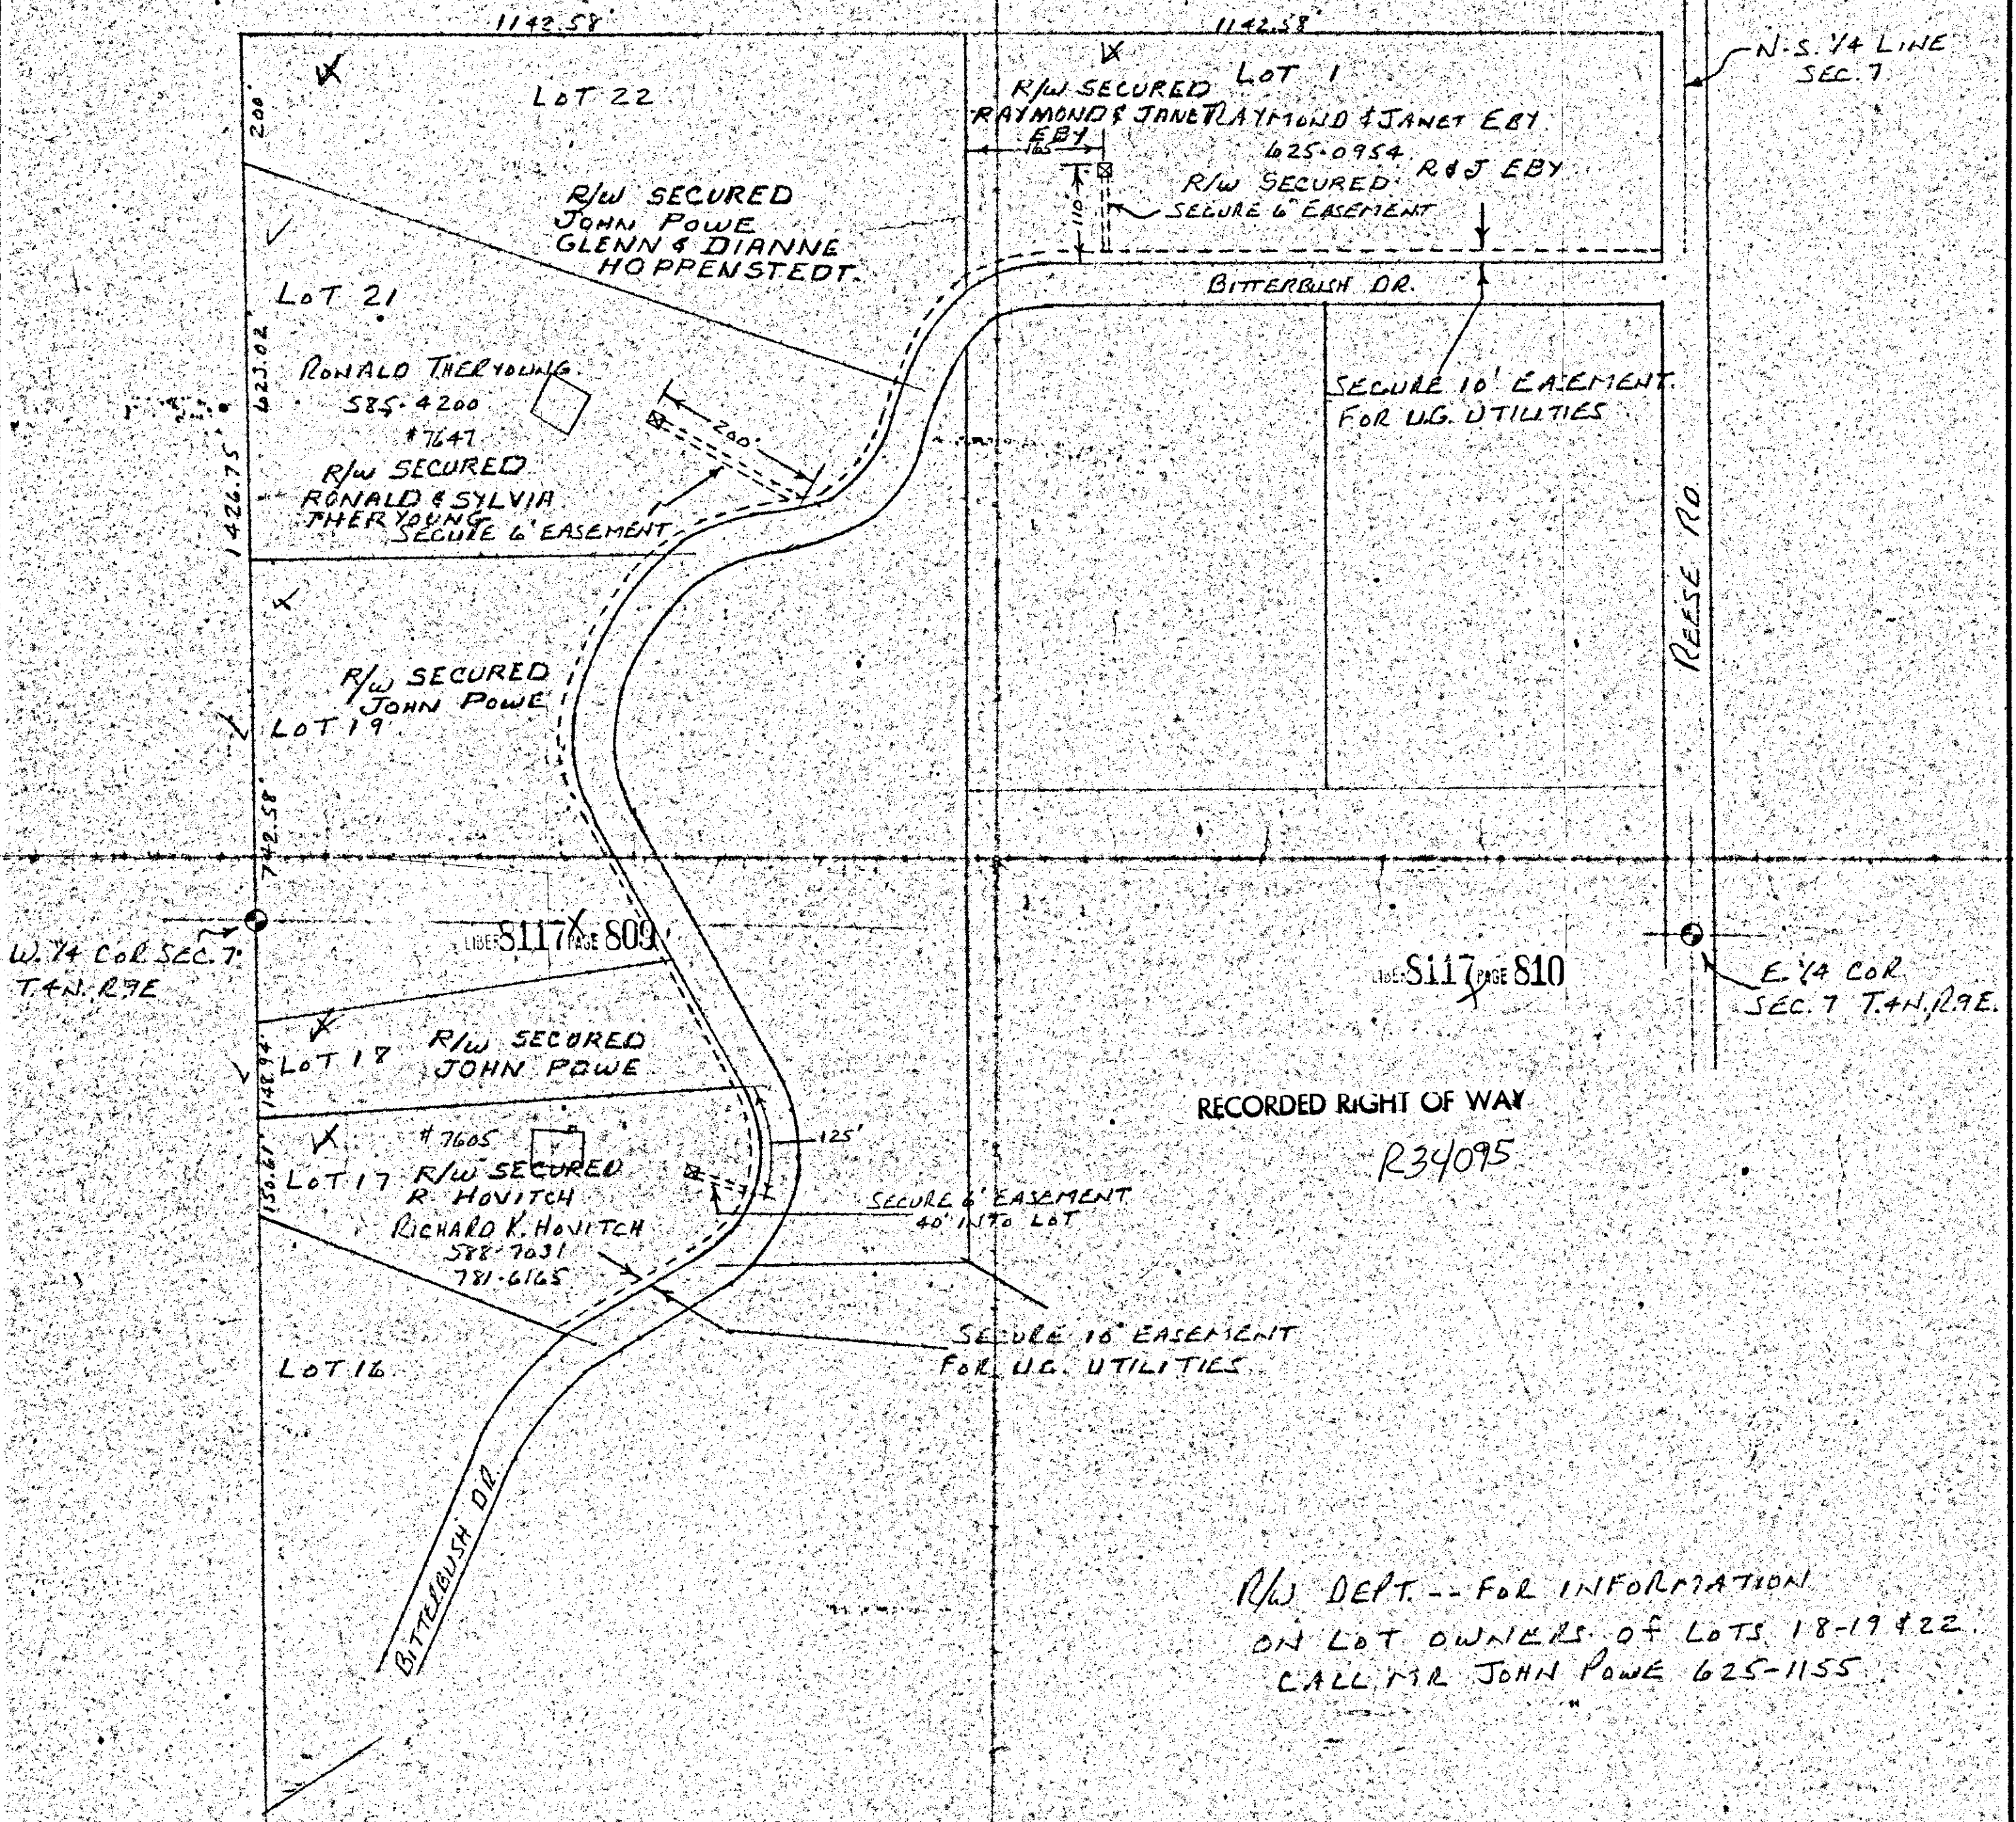

JOINT USE MEMO 0-6053

REPORT OF PROPERTIES AND RIGHTS OF WAY DEPARTMENT SECURED AS INDICATED ON THE SHEET	PERMITS TO:
BY _____	RECORD NUMBER <u>6</u>
DATE <u>1-9-81</u>	R/W F.S. <u>6</u>
DATE WANTED <u>NOV 18, 1980</u>	AMP. <u>6</u>
DISTRICT <u>D. Cranston</u>	OPERATOR <u>6</u>
FIELD <u>D. Cranston</u>	TOTAL <u>6</u>

LEGEND	
○	FOREIGN POLE
○	EXIST. O.E. CO. POLE
○	PROPOSED POLE
—	EXIST. ANCHOR
—	PROPOSED ANCHOR
○	TREE
—	120/240 V LINE
—	4800 V LINE
—	13,200 V LINE
—	50,000 V LINE

THE DETROIT EDISON COMPANY - SERVICE PLANNING DEPARTMENT			
DIST. OR TWP. <u>INDEPENDENCE</u>	COUNTY <u>OAKLAND</u>	GTR. & TWP. SECT. NO. <u>7</u>	DEPT. ORDER NO.
MAP SECT. <u>1ND-6</u>	TOWN <u>4N 9E</u>	RANGE <u>9E</u>	JOINT R/W REQUIRED <u>NO</u>
PROJECT NAME <u>J.O. BERRY</u>	TEL. ENG'R. & INST. <u>PONTIAC</u>	PROJ. OR PART NO.	R/W NO. <u>0-7111</u>
CIRCUIT <u>8119 CLARKSTON</u>	REASON <u>BITTERBUSH EASEMENTS</u>	PLANNED BY <u>DR. JOHNSON</u>	O.F.W. S.O. OR P.E. NO.
SCALE <u>1" = 150'</u>	DATE <u>7-31-80</u>	BUDGET ITEM NO.	

RETURN TO
J. A. ROBERTSON
THE DETROIT EDISON COMPANY
30400 TELEGRAPH ROAD, 272 OAKDH
BIRMINGHAM, MICHIGAN 48010

RECORDED RIGHT OF WAY NO.

34090/5

R34095