Spilo, ti Tup

Detroit Edison :

Date:	1/8/88	
To:	Record Center 130 General Offices	
From:	JAMES DAVENFORT OF Real Estate and Rights of Way Department Ann Arbor Division	
Subject:	Agreement-Easement-Restrictions for underground residential distribution for INTERNATIONAL PLACE APTS- located in YPSILANTI TOWNSHIP PHASE - WASHTENAW COUNTY	= ¥
are other p	r Records Center is the executed agreement dated 3-85 for the above named project. Also enclosed ertinent papers relative to this project or this project were requested by DON GIBSON	
Service Pla Ann Arbor D	nning Department, ANN ARBOR OFFICE	
The agreeme	of the Real Estate and Rights of Way Departments ivision. the attached papers a part of recorded Right of Way file. Information)	
	ED ED	
Please make	the attached papers a part of recorded Right of Way file.	
(Additional	Information)	
	DE A	
	NO.	
	Ly.	j
Attachment		}
Attachment		}



Right of Way Agreement

RECORDED IM YTHUOC W'PETHEA

ROBENT M. HARRISON COUNTY OF ERK/REGISTER

85

For valuable consideration, the receipt of which is hereby acknowledged, the undersigned hereby grant and convey to THE DETROIT EDISON COMPANY, a corporation organized and existing concurrently under the laws of the States of Michigan and New York, of 2000 Second Avenue, Detroit, Michigan 48226 and the MICHIGAN BELL TELEPHONE COMPANY, a Michigan corporation, of 444 Michigan Avenue, Detroit, Michigan 48226 hereinafter referred to as "UTILITIES", the easement and right to erect, lay, maintain, reconstruct and replace underground facilities consisting of wires, cables, conduits, fixtures and appurtenances including the necessary above ground equipment, connections, poles and accessories which may from time to time be required in, under, upon, over and across the land located in the Township of Ypsilanti, Washtinaw County, Michigan, and more particularly described on the attached Appendix "A", with the full right to the UTILITIES of ingress and egress upon said land for the purposes of this grant, and the further right to trim, cut down or otherwise control brush and trees within the easements herein described.

Said easements shall be twelve (12) feet in width unless otherwise indicated and their route is described as follows: The exact location of said easements will be as shown on a drawing to be recorded within 180 days after construction.

In order to provide for the proper maintenance and protection of UTILITIES, the undersigned covenant and agree that:

- 1. The easements will be graded to within four (4) inches of final grade before the UTILITIES lines are installed and this ground elevation must be maintained after installation of utilities to avoid the pooling of water in, on or around above ground UTILITIES' equipment.
- 2. No buildings or structures other than UTILITIES equipment are to be placed within the easements herein granted. No excavation is to be permitted within said easement without approval of UTILITIES.
- 3. If the lines or facilities of UTILITIES are damaged by the acts of Owners, their agents, employes or contractors, repairs shall be made by the Utility company so damaged at the cost and expense of Owners. Owners are defined as those persons owning the land at the time the damage occurred.
- 4. No shrubs or foliage shall be planted or grown within five (5) feet of the front door of transformers or switching cabinet enclosures. UTILITIES shall not be responsible to Owners for damages to or removal of trees or plant life planted in front of said door or within the easement causing an interference with UTILITIES maintenance of their equipment.

THIS GRANT is declared to be binding upon the heirs, successors, lessees, licenses and assigns of the parties hereto.

IN WITNESS WHEREOF, the undersigned have hereunto set their hand and seal on this date.

Grantors: Witnesses: Husband & Wife Claudia Cardinali, Husband & Wife **Y**inda Byrd-6∕eorge Prepared By: James Davenport Address: 24567 Northwestern Suite 400B SECOND 2000 Southfield, MI 48075 DETROIT MI 48226

This instrument is re-recorded to show as installed drawing as stipulated above.

006-011-20

05 <u>XC.-28 19 87</u> ROBERT M. HARRISON トレくりとくししつ

RECORDED 엵

DE 963-4187 10-79 CS (DE URD -MBT)


International Place Apts., Phase 4 Rage 2,5

STATE OF MICHIGAN	, m			
County of Voakland)SS	ξ. α. 			
	$\tilde{\mathbf{z}}$			
On this 13th day of November	A.D.:19 <u>:85</u> , before			
me, the undersigned, a notary public in and	for said county, personally appeared			
Mark T. Jacobson and Mildred Jacobson, Hu				
	known to me to be the persons			
who executed the foregoing instrument, and a	acknowledged the same to betheir			
free act and deed.				
	O A			
	Enfetta Mapers			
	Notary Public, County, Michigan			
My commission expires:	- P EMPLETIA P. MAPLES			
	States Public, Oakland County, Michigan Sty Commission Expires February 27, 1989			
STATE OF MICHIGAN	₩ G			
County of V Oakland)SS				
On this V 13th day of V November	, A.D. 19 <u>85</u> , before			
me, the undersigned, a notary public in and for said county, personally appeared				
Mario O. Cardinali and Claudia Cardinali,	Husband & Wife			
	known to me to be the person s			
who executed the foregoing instrument, and a	acknowledged the same to betheir			
free act and deed.				
	2006			
	Carfitla I Maple			
	Notary Public,County, Michigan			
My commission expires:	EARLETTA F. MAPLES Notary Public, Oakland County, Michigan			
	My Commission Expires February 27, 1989			

10 10 10 10 APPÉNDIX "A"

BEG AT W 1/4 COR OF SEC 6, TH N 0-41 E 238.95 FT. TH N 81-9 E 258.27 FT. TH N 88-6-30 E 567.6 FT. TH N 85-40-50 E 156.93 FT. TH S 0-41 W 334.6 FT. TH N 88-31 W 978.15 FT TO POB PART NW 1/4 SEC 6 T3S R7E 6.64 AC


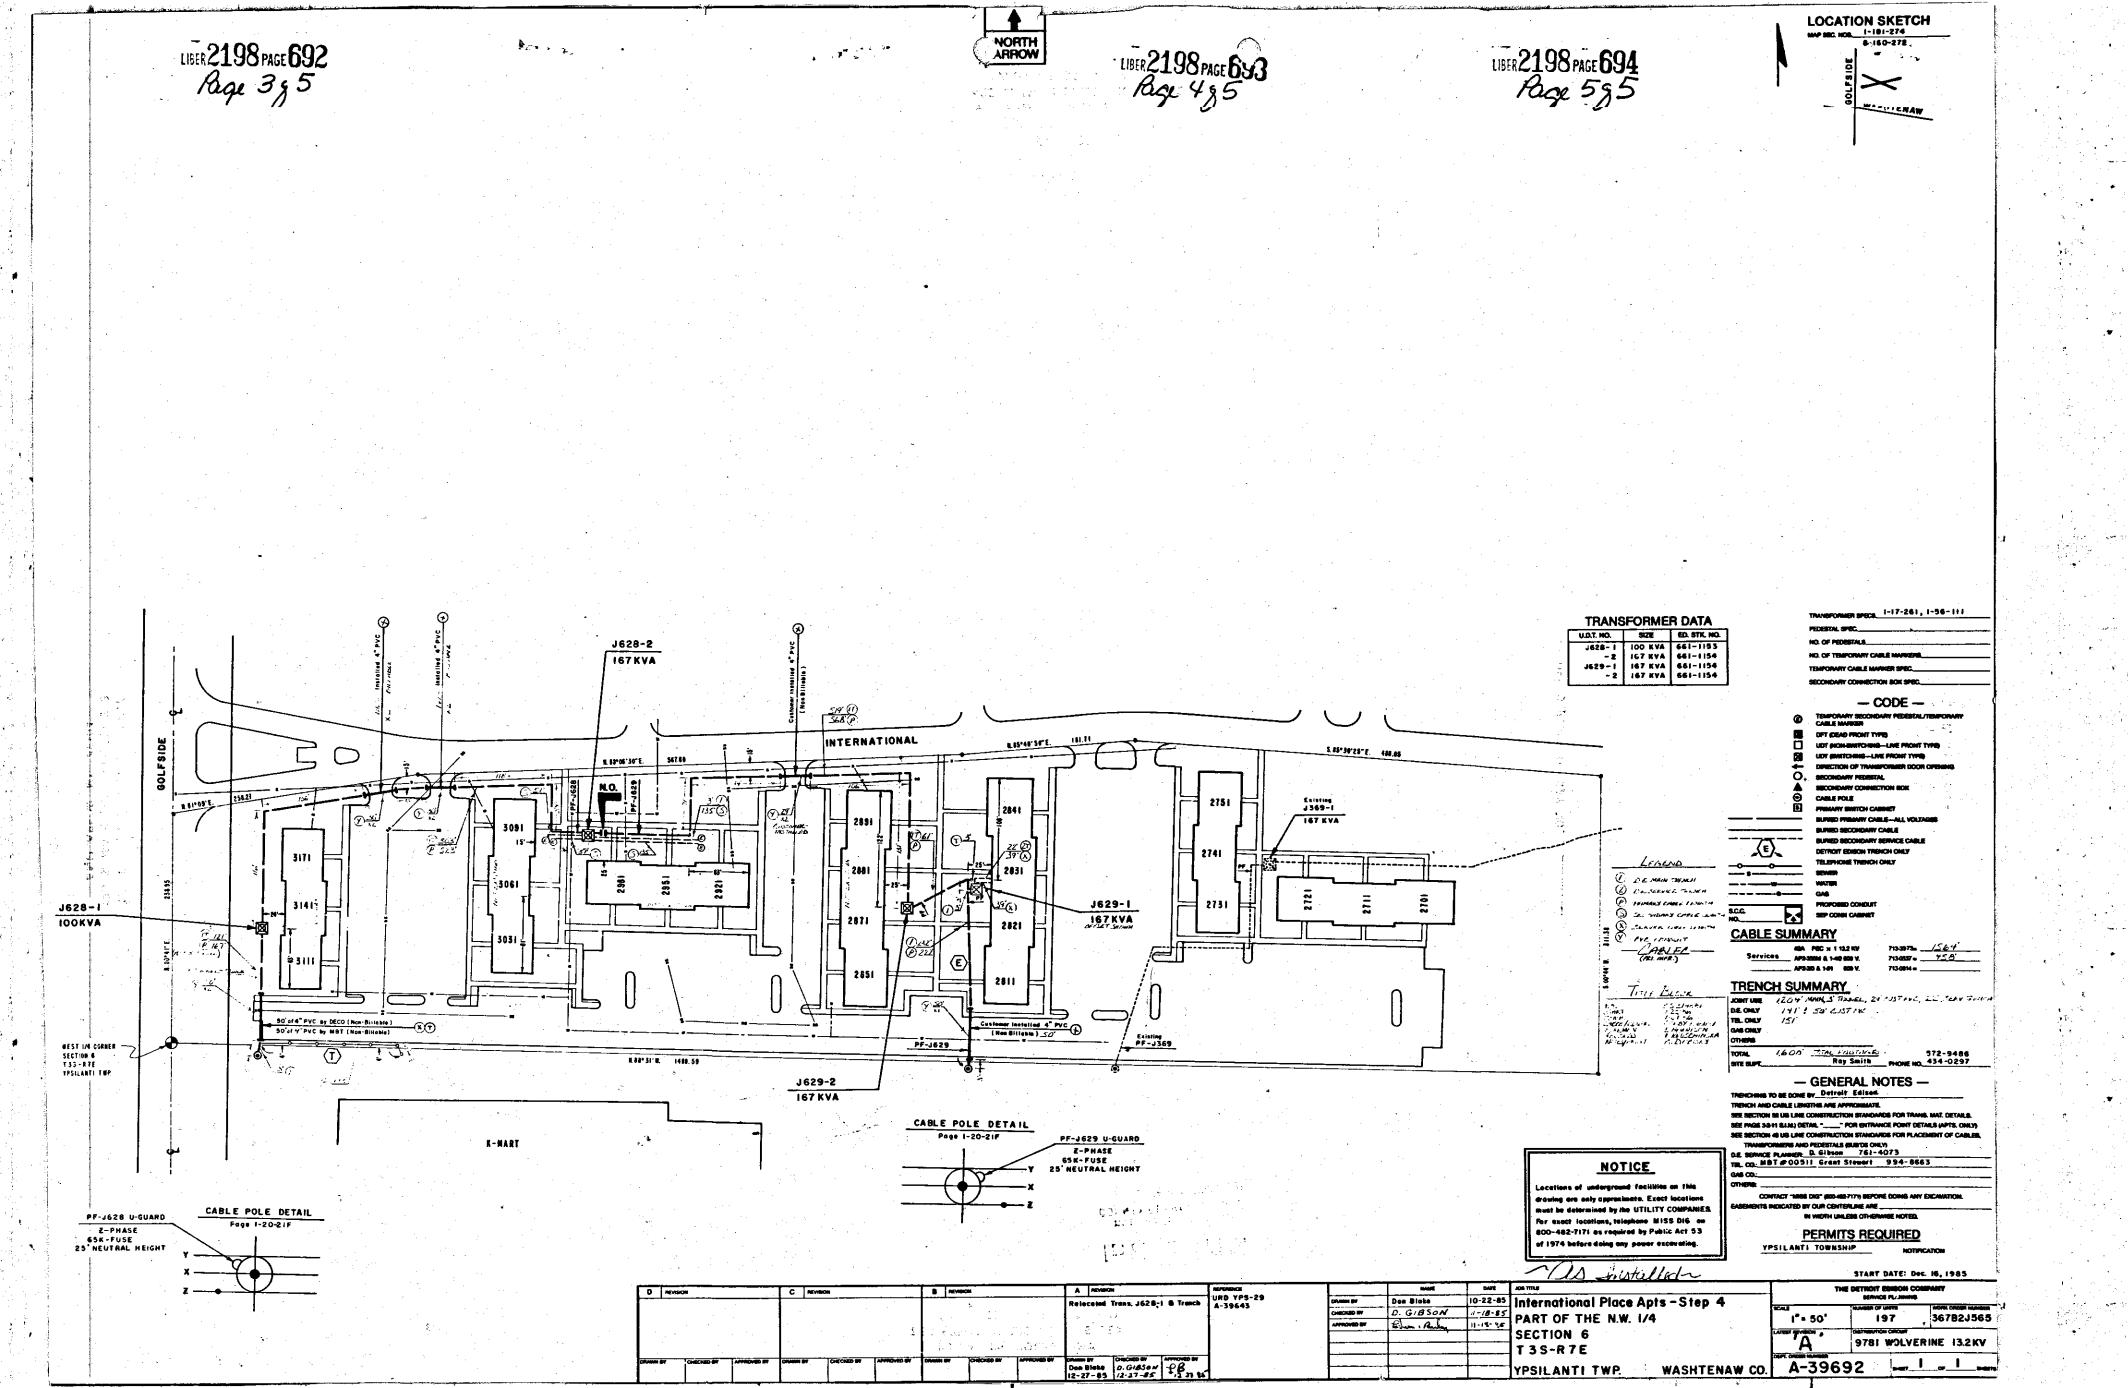

RETURN TO:
RICHARD LONGWISH
THE DETROIT EDISON COMPANY
A25 S. MAIN STREET, ROOM 332
A26 S. MAIN STREET, ROOM 332

Was directed motest

L8, Hd 50 Z 87 330



THE DETROIT EDISON COMPANY

A25 S. MAIN STREET, ROOM 332

ANN ARBOR, MI 48104

NUMB 308 MISC 13.00 B333 0333003 9227 2:00PM 12/28/87

13.00

RECORDED RIGHT OF WAY NO. 37943

RETURN TO:
RICHARD LONGWISH
THE DETROIT EDISON COMPANY
425 S. MAIN STREET, ROOM 332
ANN ARBOR, MI 48104

RETURN TO:
RICHARD LONGWISH
THE DETROIT EDISON COMPANY
425 S. MAIN STREET, ROOM 332
ANN ARBOR, ML 48104