Detroit Edison

Real Estate and Rights of Way July 1t Overhead Right of Way Agreement


For good and valuable consideration of system better DETROIT EDISON COMPANY, a Michigan corporation of State of the Control of	10/5 , 19 88
referred to collectively as "UTILITY," the right to con- overhead line facilities consisting of poles, guys, anche provide electric and communication services in, upon	of 2000 Second Avenue, Detroit, Michigan, and MICHIGAN of 444 Michigan Avenue, Detroit, Michigan, hereinafter instruct, reconstruct, modify, add to, operate and maintain ors, wires, cables, transformers and accessories required to in, over and across property located in the Township
of Chesterfield	, County of Macomb , State of
of Section 8, T3N, R14E, Chesterfield Towns particularly described as follows: Commer thence 683.43 feet N 89°30'05" West along to 1181.21 feet, S 01°34'03" West and 100.05 feet.	the East and West 1/4 line of said Section 8 and feet S 89°44'53" West to the point of beginning 43 feet; thence N 00°15'07" West 181.97 feet:
beginning.	or of oo E logget reet to the point of
•	·
	•
,	
The route of the line facilities is described as follows:	In an easterly and westerly direction across
said land.	
and agreed that UTILITY shall, at no time, trim or cut of necessary to do so. UTILITY shall restore premises to damages caused by its employes, contractors, vehicles a herein. No buildings or structures are to be placed with consent of the GRANTEE. This grant is declared to be bir	or operation of the line facilities. It is expressly understood down any trees unless, in UTILITY'S opinion, it is absolutely its original condition or as near as can be in the event of and equipment entering premises for the purposes set forth
of the parties hereto.	nding upon thr heirs, sucessors, lessees, licensees and assigns
Witnesses:	set their hand(s) on the date of this agreement. Grantors:
Witnesses: X MICHAEL J. MCCABE X Carel Washard X Carel Washard	set their hand(s) on the date of this agreement. Grantors: Tracy Leslie


APPLICATION FOR RIGHT OF WAY

DE 963-0011 5-7455 (MS 80)

Menterfield Twp

PLEASE SECURE RIGHT OF WAY AS FOLLOWS DATE August 24, 1988 LOCATION Bertrand & Chesterfield APPLICATION NO. MC-H766 DEPT. ORDER NO. CITY OR VILLAGE O. F. W. NO. Chesterfield Macomb _ COUNTY _ TOWNSHIP BUDGET ITEM NO. _ 9-5-88 DATE BY WHICH RIGHT OF WAY IS WANTED _ INQUIRY NO. JOINT RIGHT OF WAY REQUIRED YES X NO \square NOTE: Identify on print or sketch the subdivisions as to section location and liber and page. KIND AND DESCRIPTION OF RIGHT OF WAY REQUESTED 10' easement Easterly Westerly along South prop. line of Parcel's 1-4, also 10' ease. along East I, in Northerly Southerly, direction of 27645 Bertrand. Trees to be cut to ground in exist 18' eas. for OH lines to feed future U.G. system PURPOSE OF RIGHT OF WAY Provide U.G. elect. service to above mentioned parcels. Mac. Div. Hdqtr. Service Planning REPORT OF REAL ESTATE AND RIGHTS OF WAY DEPT. R/W Secured as requested PERMITS IN RECORD CENTER R.E. & R/W DEPT. FILE _

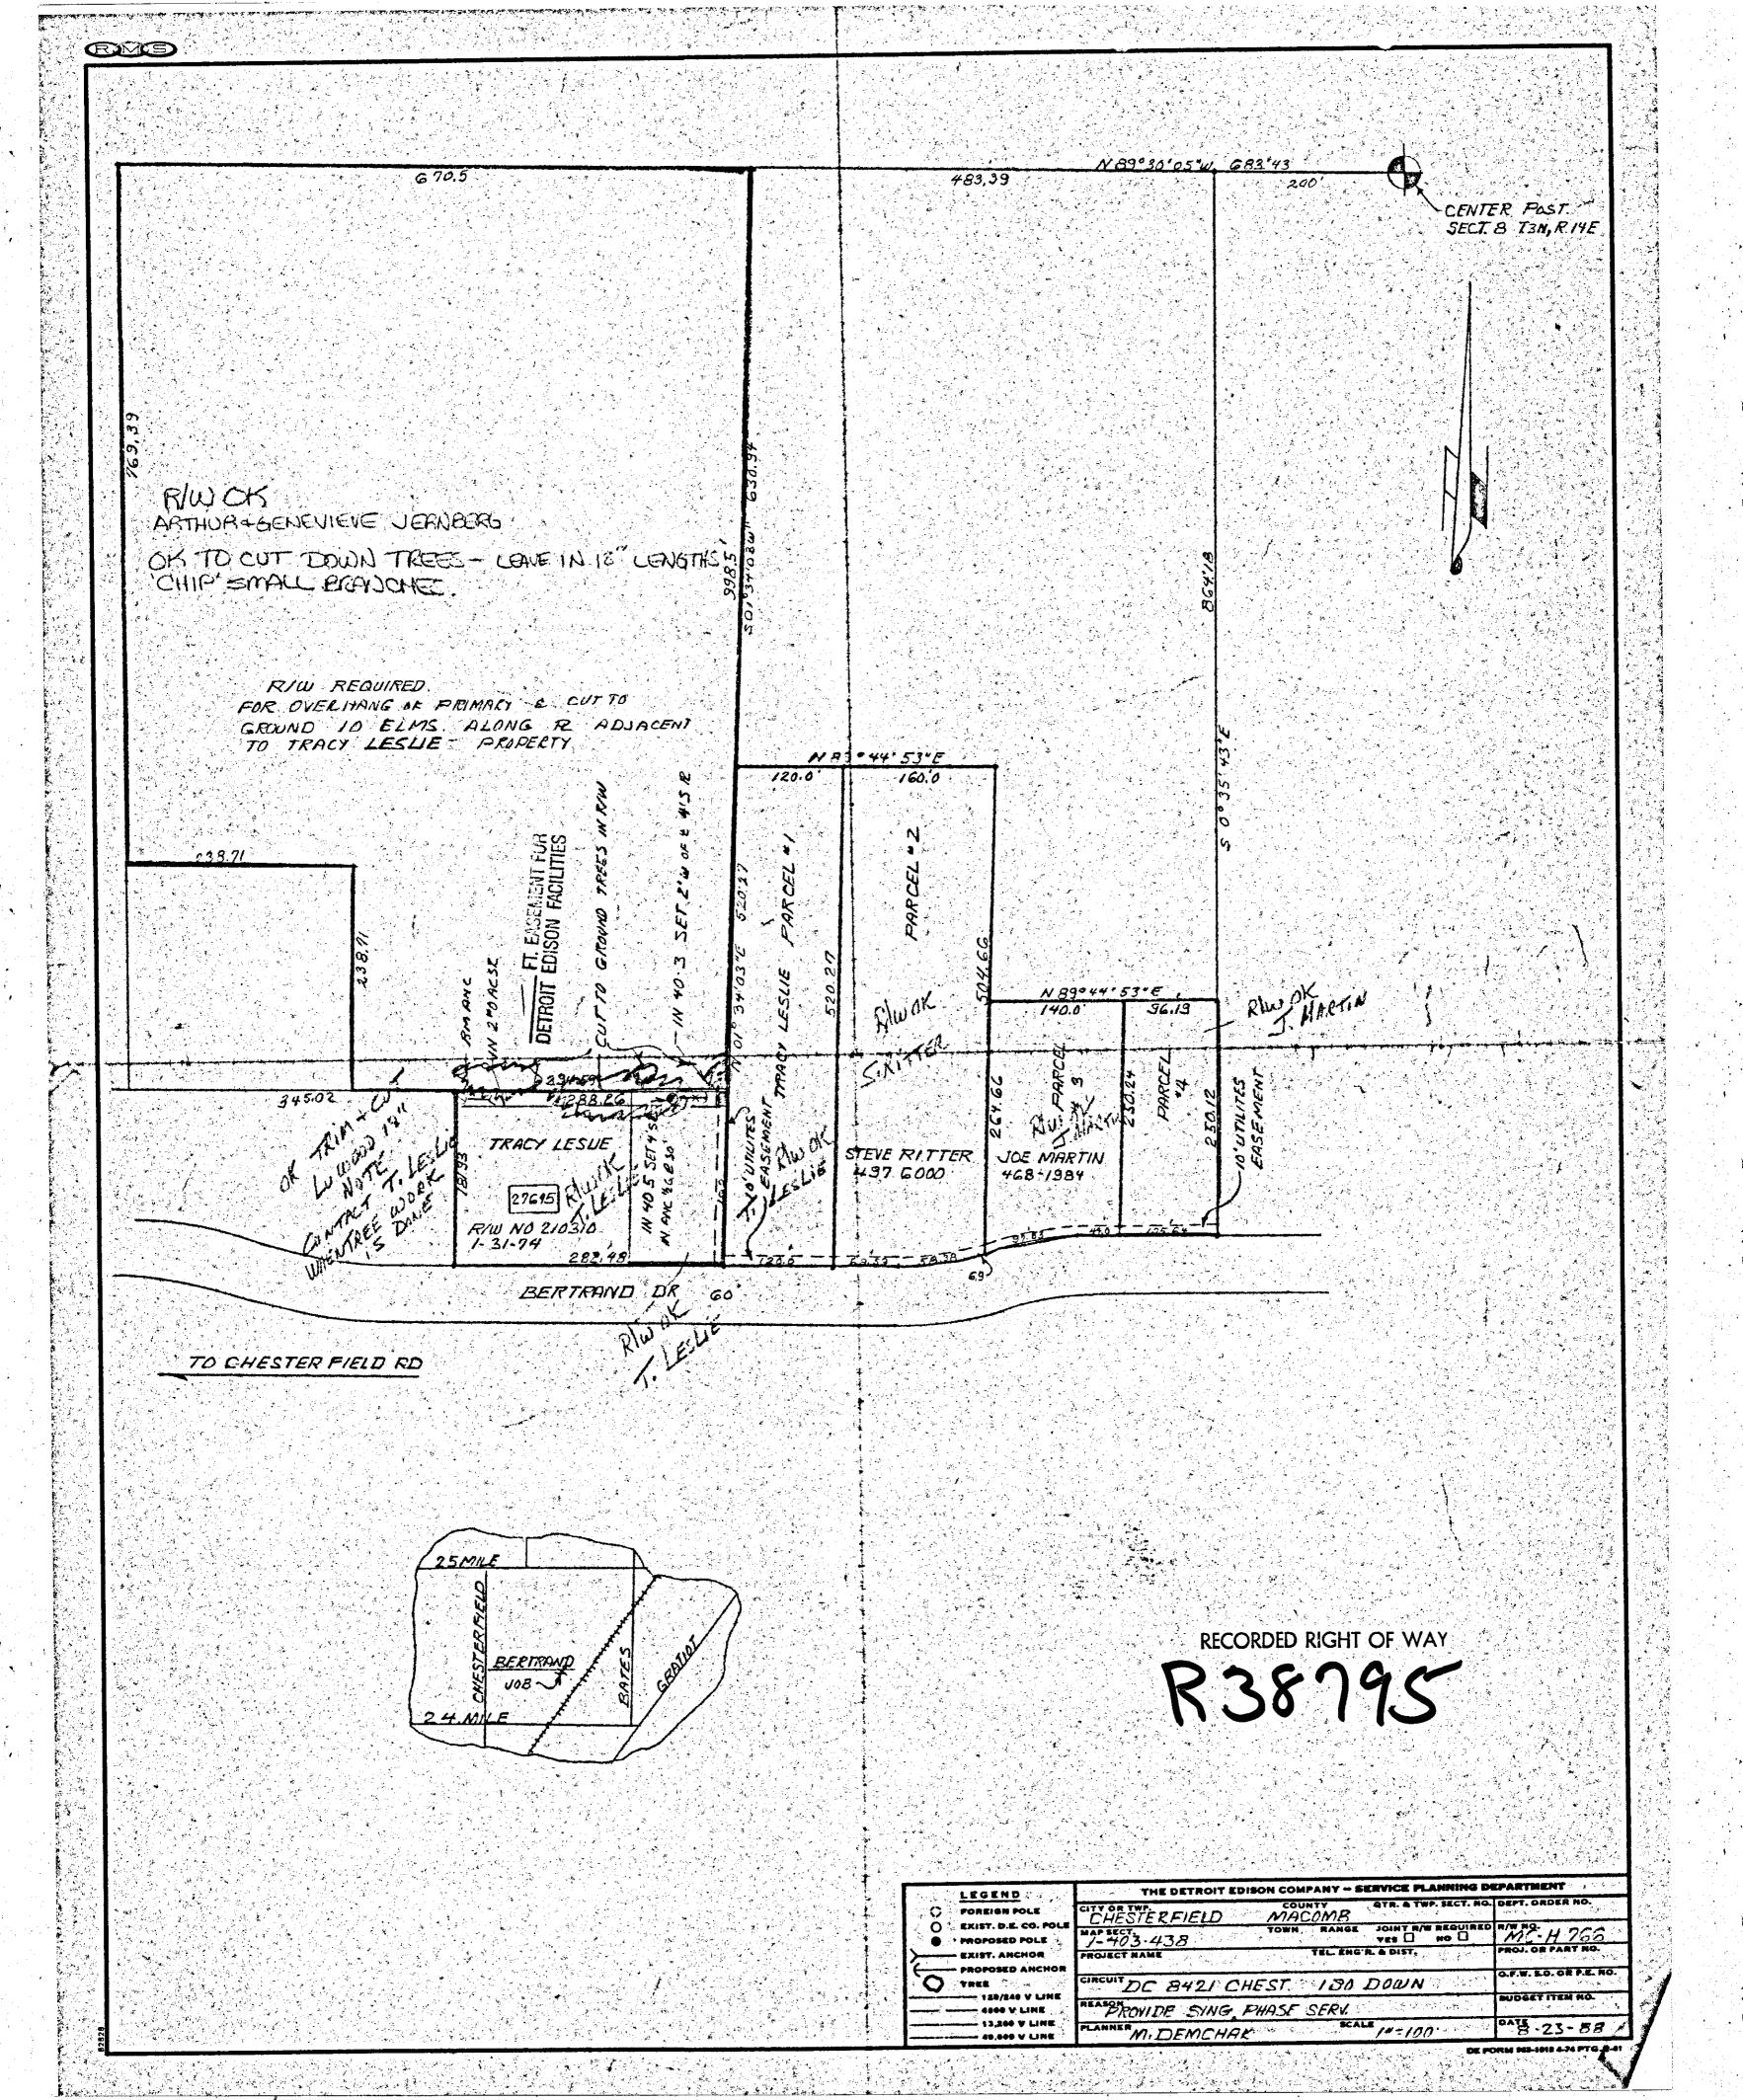

R38795

38795

RECORDED RIGHT OF WAY NO