RECORDED RIGHT OF

AVA

Right of Way Agreement

THIS INSTRUMENT IS RE-RECORDED TO SHOW AS INSTALLED DRAWING AS STIPULATED.

March 27, 19 86

For valuable consideration, the receipt of which is hereby acknowledged, the undersigned hereby grant and convey to THE DETROIT EDISON COMPANY, a corporation organized and existing concurrently under the laws of the States of Michigan and New York, of 2000 Second Avenue, Detroit, Michigan 48226 and the General Telephone Co. of Mich. of 455 E. Ellis, P.O. Box 149, Muskegon, MI 49443 hereinafter referred to as "UTILITIES", the easement and right to erect, lay, maintain, reconstruct and replace underground facilities consisting of wires, cables, conduits, fixtures and appurtenances including the necessary above ground equipment, connections, poles and accessories which may from time to time be required in, under, upon, over and across the land located in the Township of Pittsfield, Washtenaw County, Michigan, and more particularly described on the attached Appendix "A", with the full right to the UTILITIES of ingress and egress upon said land for the purposes of this grant, and the further right to trim, cut down or otherwise control brush and trees within the easements herein described.

Said easements shall be <u>Twelve (12)</u> feet in width unless otherwise indicated and their route is described as follows: The exact location of said easements will be as shown on a drawing to be recorded within 180 days after construction.

In order to provide for the proper maintenance and protection of UTILITIES, the undersigned covenant and agree that:

- 1. The easements will be graded to within four (4) inches of final grade before the UTILITIES lines are installed and this ground elevation must be maintained after installation of utilities to avoid the pooling of water in, on or around above ground UTILITIES' equipment.
- 2. No buildings or structures other than UTILITIES equipment are to be placed within the easements herein granted. No excavation is to be permitted within said easement without approval of UTILITIES.
- 3. No shrubs of foliage shall be planted or grown within five (5) feet of the front door of transformers or switching cabinet enclosures. UTILITIES shall not be responsible to Owners for damages to or removal of trees or plant life planted in front of said door or within the easement causing an interference with UTILITIES maintenance of their equipment.
- 4. If the lines of facilities of UTILITIES are damaged by the acts of Owners, their agents, employes or contractors, repairs shall be made by the Utility company so damaged at the cost and expense of Owners. Owners are defined as those persons owning the land at the time the damage occurred.

THIS GRANT is declared to be binding upon the heirs, successors, lessees, licenses and assigns of the parties hereto.

IN WITNESS WHEREOF, the undersigned have hereunto set their hand and seal on this date.

Witnesses:

Allan W. Grossman

Paul J. Peters

Paul J. Peters

Allan W. Grossman

Paul J. Peters

Allan W. Feters, husband & wife

Allan W. Feters, husband & wife

Raymond Charles Bernreuter

Aa/k/a Raymond C. Bernseuter

Aa/k/a Raymond C. Bernseuter

Aa/k/a Raymond C. Bernseuter

Andress: 203 W. Michigan

Saline, MI 48176

RECORDED

WASHTENAW COUNTY HI DE 963-4186 10-79 CS (D.E. U.R.D.)

FEB 5 10 30 AN '91

PEGGY M. HAINES
COUNTY CLERK/REGISTER
LE-LUCKOLOGIC

114 14 N 14 ST ROOM DE ANION ANION ANION

79 CS

RETURN TO:
RICHARD LONGWISH
THE DETROIT EDISON COMPANY
425 S. MAIN STREET, ROOM 332
ANN ARBOR, MI 48104

RETURN 10:
R. J. ORT
THE DETROIT EDISON COMPANY
425 S. MAIN STREET, ROOM 332
ANN ARBOR, MI 48104

LIBER 2040 PAGE 443 Park Place Condominiums LIBER 2470 PAGE 294
STATE OF MICHIGAN Page 2 of 3 Percorded
COUNTY OF <u>/ Washtenaw</u> On this <u>/ J/M.</u> day of <u>/ March</u> , A.D. 1986, before me,
the undersigned, a notary public in and for said county, personally appeared

who executed the foregoing instrument, and acknowledged the same to be their free act and
deed.
RICHT
Rathleen S. Dieterle
My Commission Expires: 10-16-88 Mathleen S. Dieterle Washtenaw County, MI Notary Public, Washtenaw County, MI
My Commission Expires: 10-16-88
o i
<u> </u>
STATE OF MICHIGAN)
COUNTY OF Washtenaw)
On this - 71 the day of Murch, A.D. 1986, before me,
the undersigned, a notary public in and for said county, personally appeared
Raymond Charles Bernreuter and Janet S. Bernreuter, husband and wife known to me to be
the persons who executed the foregoing instrument, and acknowledged the same to be their
· · · · · · · · · · · · · · · · · · ·
free act and deed.
Kathleen S. Dieterle
My Commission Expires: 10-16-88

APPENDIX "A"

Land situated in the City of Saline, Washtenaw County, MI, to-wit:

Commencing at the East 1/4 corner of Section 36, T3S, R5E, City of Saline, Washtenaw County, MI; thence S 1°28'20" W 883.31 feet along an east line of said section (as monumented) for a Place of Beginning; thence continuing along said line S 1°28'20" W 670.52 feet; thence N 89°18'15" W 335 feet along the north line of Bennett's Addition to the City of Saline, as recorded in Liber 67 of Plats, pages 726 and 727, Washtenaw County Records; thence S 1°28'20" W 220.44 feet along the east line of Lot 52 of said Bennett's Addition; thence N 89°18'15" W 67 feet along the north line of Clark Street; thence N 1°28'20" E 220.44 feet along the west line of said Lot 52; thence N 89°18'15" W 269.88 feet along the north line of said Bennett's Addition; thence N 1°27'45" E 87.59 feet; thence along the southeasterly line of an existing railroad right of way in the following two courses: 564.65 feet along the arc of a 2914.79 foot radius circular curve to the left, chord bearing N 52°08'40" E 563.69 feet; thence N 46°35'40" E 332.69 feet to the Place of Beginning, being Lot 52 of said Bennett's Addition and a part of the SE 1/4 of said Section 36.

THE DELL 1 ... COMPANY 429 S. MAIN STREET, ROOM 332 ANN ARBOR, MI 48104

RECORDED

CONTINUES TENAN COUNTY, MI

APR 7 11 20 AM '86

COUNTY CLERK/REGISTER

105-2470 p.o.2394

RETURN TO:
RICHARD LONGWISH
THE DETROIT EDISON COMPANY
425 S. MAIN STREET, ROOM 332
ANN ARBOR, MI 48104

COUNTY CLERKY RECISTER

88' MA os 11 . 7. 89A

RECORDED

RETURN TO:

THE DETROY EDISON COMPANY
425 S. MAIN STREET, ROOM 332
ANN ARBOR, MI 48104

監 3436 40 007.00 №

7,00

Detroit Edison


DATE:	2-19-91	
TO:	Corporate Real Estate Services 2310 W.C.B.	
FROM:	James M. Davenport MD Real Estate & Rights-of-Way Howell Office Ann Arbor Division	
SUBJECT:	Agreement/Easement/Restrictions for underground residential distribution for PARK PLACE CONDOS. Located In: PITTSFIELD TOWNSHIP County: WASHTENAW COUNTY	
Attached is the executed agreement dated $3/27/86$ for the above named project.		
Easements for this project were requested by H.CoLE		
Service Planning Department, Ann Arbor Division.		
The agreement was negotiated by James M. Davenport of the Real Estate and Rights-of-Way Department, Ann Arbor Division.		
Please make the attached papers a part of the recorded Right-of-Way file.		
Additional Information:		

JMD:pg:wp

Attachment(s)

Serving Customers

Nere all a part of it.

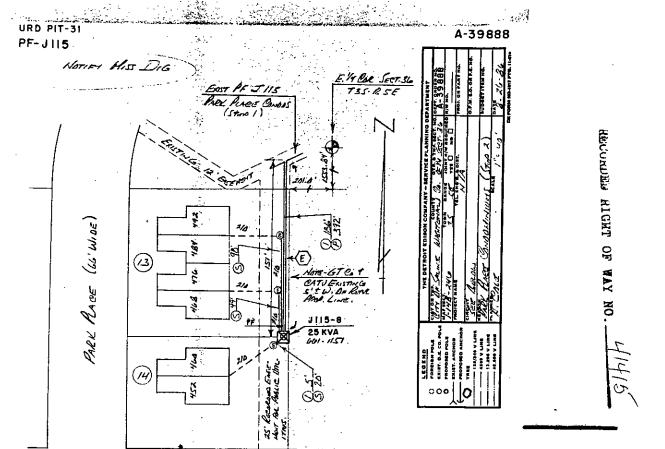

CLARK ST. (66 WIDE)

LEGIND

D.E. MAIN TRENCH PRIMARY CARLE LESSTH SECONDARY CARLE LESISTH D.O. A-39868 CANST. W.O. 36782 = 684 CANT. W.A. 59003A6 J466 PF J-115

. !	•
UTILITIES LAYOUT APPROYAL	TO CO HOUSE O CALE THE B- 26-86
Estimated Start Date Gen A	A Marine Co
Developer approves service entrance locations and	Cierl Chicusian Date NIA
Leations of lines and above grade facilities required	,
TOTESTAL TOURS , CLONE CARLESSIAN	FILE STREET JAPES X
Gas Ca. and Derinit School - she	The state of the s
Variations not not a termin green additional Gent	51.2004 DVLY W/A
Agreements, restrictions, eas - et to 5x signed prior to construction.	FTC . , ')
prior to construction,	TARGOSTIS A
Signed de Ji Les	CAPAG FOLE
Tolo - 265/86	162
Title	mirror 10 Donawalli p. 76-46
•	

- as Installed-

RECORDED

WASHTENAW COUNTY MI

FEB 5 10 30 AM '91

PEGGY M. HAINES COUNTY CLERK/REGISTER

6333 0333003 0208 10:22AM 2/05/91

8333 0333003 0208 10:22AM 2.05/91

The flat

RETURN TO:
RICHARD LONGWISH
THE DETROIT EDISON COMPANY
425 S. MAIN STREET, ROOM 332
ANN ARBOR, MI 48104