is

easement

This

drawing attached here to

5

shown

as

WESTBUF VILLAGE TOWNHOUSES

' 139695 (mar 11066 N 663

Detroit

Real Estate and Rights of Way

## Joint Underground Residential Distribution **Right of Way Agreement**

E#92 REG DEE89 PAID 0001 JUN.05/92 11:10AM 6277 MISC 13.00

For good and valuable consideration of system betterment, the undersigned hereby grant and convey to CONSUMERS POWER COMPANY, a Michigan corporation of 212 West Michigan Avenue, Jackson, Michigan, THE DETROIT EDISON COMPANY, a Michigan corporation of 2000 Second Avenue, Detroit, Michigan, MICHIGAN TELEPHONE COMPANY, a Michigan corporation of 444 Michigan Avenue, Detroit, Michigan, and UNITED CABLE TELEVISION OF OAKLAND COUNTY, LTD., 4500 Delemere Blvd., Royal Oak, MT 48068, hereinafter referred to collectively as "UTILITY", the right to erect, lay, maintain, reconstruct, add to and replace underground facilities consisting of wires, cables, conduits, piping, venting, gas facilities and appurtenances including the necessary above ground equipment, connections, poles and accessories required to provide gas, electric and communication services with the usual services, connections and accessories in, under, upon, over and across the property located in the City of Auburn Hills, County of Oakland, State of Michigan, and more particularly described on the attached Appendix "A", with the full to the UTILITY of ingress and egress upon said property for the purposes of this grant, and the further right to trim, cut down or otherwise control brush and trees within the right of way herein described.

Said right of way shall be ten (10) ft. in width unless otherwise indicated and the route is described as follows:

The exact location of said easement shall be shown on a drawing recorded 90 days after construction.

/B#92 REG/DEEDS PAID 0001 SEP.18'89 11:36AM 0487 MISC 7.00

that:

In order to provide for the proper maintenance and protection of UTILITY, the undersigned covenant and agree

- 1. The right of way will be graded to within four inches of final grade before the UTILITY'S lines are installed and this ground elevation must be maintained after installation of utilities to avoid the pooling of water in, on or around UTILITY'S above ground equipment.
- 2. No buildings or structures other than UTILITY'S equipment are to be placed within the right of way herein granted. No excavation is to be permitted within said right of way without approval of UTILITY.
- 3. No shrubs or foliage shall be planted or grown within eight feet of the front door of transformers or switching cabinet enclosures. UTILITY shall not be responsible to owners for damages to or removal of trees or plant life planted in front of said door or within the right of way causing an interference with UTILITY'S maintenance of their equipment.
- 4. If the lines or facilities of UTILITY are damaged by the acts of owners, their agents, employes or contractors, repairs shall be made by the utility company so damaged at the cost and expense of owners. Owners are defined as those persons owning the property at the time the damage occurred.

THIS GRANT is declared to be binding upon the heirs, successors, lessees, licensees and assigns of the parties hereto.

IN WITNESS WHEREOF, the undersigned have hereunto set their hand(s) on the date of this agreement.

	Witnesses:		Grantors.	100
			B#92 REG/DEEDS PAI	The second
			0001 JUN.05/92 11:1	LÖAM <del>2.00</del>
	OECO!		9.K	. AR
Prepared by:	Omer V. Racine/vkc The Detroit Edison Company	Address:	See Next Page	The transfer of the second
	30400 Telegraph Road, Suite Birmingham, MI 48010	277		

RECORDED RIGHT OF WAY



MAR - MO

RETURN TO J. D. McDONALD THE DETROIT EDISON COMPANY 30400 TELEGRAPH ROAD, 277 OAKDH BIRMINGHAM, MICHIGAN 48010 LIBER 11066 PM 66

Melvin M. Kaftan, Trustee of M. Kaftan Revocable Trust, October 4, 1971

MAXRICE

State of Michigan SS: County of Oakland

Personally came before me this 2814 day of AVGUST, 1989, Melvin M. Kaftan, Trustee of the above named Trust, to me known to be the person who executed the foregoing instrument, and to me known to be such Trustee and acknowledged that he executed the foregoing instrument as such Trustee, as the free act and deed of said Trust.

My Commission Expires: AUG. 24, 1992

Jehn A. Bentin

Notary Public, County, Michigan

JOHN A. BERTIN Notary Public, Oakland County, Michigan My Commission Expires August 24, 1992

## Appendix "A"

A parcel of land comprising part of Lot 38, part of Lot 39, all of Lot 43 and part of Lot 44 of "Supervisor's Plat No. 8", a Subdivision of Part of the S.W. 4 of Section 25, T3N, R10E, Pontiac Township (now City of Auburn Hills), Oakland County, Michigan according to the plot thereof recorded in Liber 52, Plats, Page 33 Oakland County records, said parcel being more particularly described as follows: 52033

Beginning at a concrete monument at the intersection of the North line of the South 200 ft. of Lot 38 of Supervisor's Plat No. 8, and the Westerly line of Squirrel Road (66 ft. wide) and proceeding thence along said Westerly line S. 31°32'30" W. 273.49 ft. and S. 02°40'50" E., 352.61 ft., and S. 00°15'57" W., 297.92 ft. and S. 02°05'10" W., 30.63 ft. to the Southeast corner of Lot 44 of said Supervisor's Plat No. 8, thence along the Southerly line of Lot 44 S. 65°10'33" W., 875.14 ft., thence N. 02°12'08" W., 371.45 ft., thence S. 66°32'55" W. 111.27 ft., thence S. 59°55'26" W., 149.70 ft. to the Southwest corner of Lot 43, thence along the westerly line of Lot 43 and in part along the Westerly line of Lot 39, N. 01°22'00" W., 794.22 ft. and N. 01°06'34" W. 213.97 ft., thence N. 88°50'03" E., 221.89 ft., thence N. 01°06'34" W., 482.77 ft., thence N. 89°18'00" E., 400.71 ft., to a point on the East line of Lot 39, thence along said line S. 03°07'28" E., 457.36 ft. the East line of Lot 39, thence along said line S. 03°07'28" E., 457.36 ft. thence along the North line of the S. 200 ft. of Lot 38 S. 88°33'28" E., 554.41 ft. to the point of beginning containing 30.4555 Acres and being subject to the riparian rights of the public in the waters of the Clinton River and subject easements of records.

Sidwell No. 14-25-326-007

INCORDED RIGHT OF WAY NO. 43

RETURN TO
J. D. McDONALD
THE DETROIT EDISON COMPANY
30400 TELEGRAPH ROAD, 277 OAKOH
BIRMINGHAM, MICHIGAN 48010

## Detroit Edison


## Application for U.R.D. Easements

DE 963-5145 9-730S (RR 11)

1o (Supervisor, REA R/W)	For Re & H/W Dept 1030	Date Received	DryBellis P No
Jian McDunald	Date ,	8.5.89 Application No	08 89-187.
Division	8/04/89		
We have included the following necessary material and information:	1-1-1-1-1-1	<u> </u>	
Material:			
A. Proposed Subdivision     1. copy of complete final proposed plat - All pages			
or		•	
B. Other than proposed subdivision (condo., apts. mobile home park     — other)			
Property description.			
Site plan.     ittle information (deed, title commitment, contract with title)	,		
commitment, or title search).			
Note: Do not submit application for URD easements until all above material has been acquired.			•
Information 1. Project Name	phase I	County	
Westbury Village Condi	212	Dakla	nd
City/Township/Village		Section No	·
Auburn Hills Type of Development			
Proposed Subdivision Apartment Complex		Condominium	
Subdivision Mobile Home Park	_,	Other	
2 Name of Owner		352-3	2800
Melvin M. Kaftan		<u> </u>	<u> </u>
21600 W. Eleven Mil	e Ad	Ta	
Owner's Representative		Phone No 353-3	2800
Ralph Bauman Date Service is Warner		1 729 -	3800
9/15/89			
4. Entire Project will be developed at one time			
T. 44	DIBURGA H	510-0822	¥Yes □ No
5. Joint easements required — Michigan Bell Telephone Jum (	ragus 4	33-5730	Yes No
D. W. Y. Communication of Communication			
United Cable Telluristion	of Oal	kland.	كن
D Other Utility Engineer Names		Allone regimbers	
Jim Kramer		549-1	256
4500 Delemere			
Royal Oak, MI 480	73		
6. Additional Information or Comments  CAT Jan 1 T. U. Meuro #1			
1, 1			
	,		
Note: Trenching letterattachedwill be submitted later  Service Planner	Signed (Service Planning Si	upervisor	· · · · · · · · · · · · · · · · · · ·
Patti Hennessy	Signed (Service Planning Si	odaed	
Phone No Address			
	<u> </u>		

MEMUKANUUM UKBER FOR GENERAL USE	· TO RF ~ds Center	DATE 1-22.92 TIME		
DE FORM MS 77 12-53	Please set up R/W file for:	Westbury VIIIAGE TOWNhouses		
	Being a part of $\leq \omega'_4$	Westbury VIII AGE Townhouses of Section 25- City of Auburn Fill		
<del>-</del>	Oakland County, Michigan	R		
		C CHT		
COPIES TO:		signed Mes Dacine &		
REPORT Por	tracTwp	Omer V. Racine 277 Oakland Division Headquarters		
<u> </u>	14 Section 25			
		48		
DATE RETURNED	TIME	SIGNED		

.....

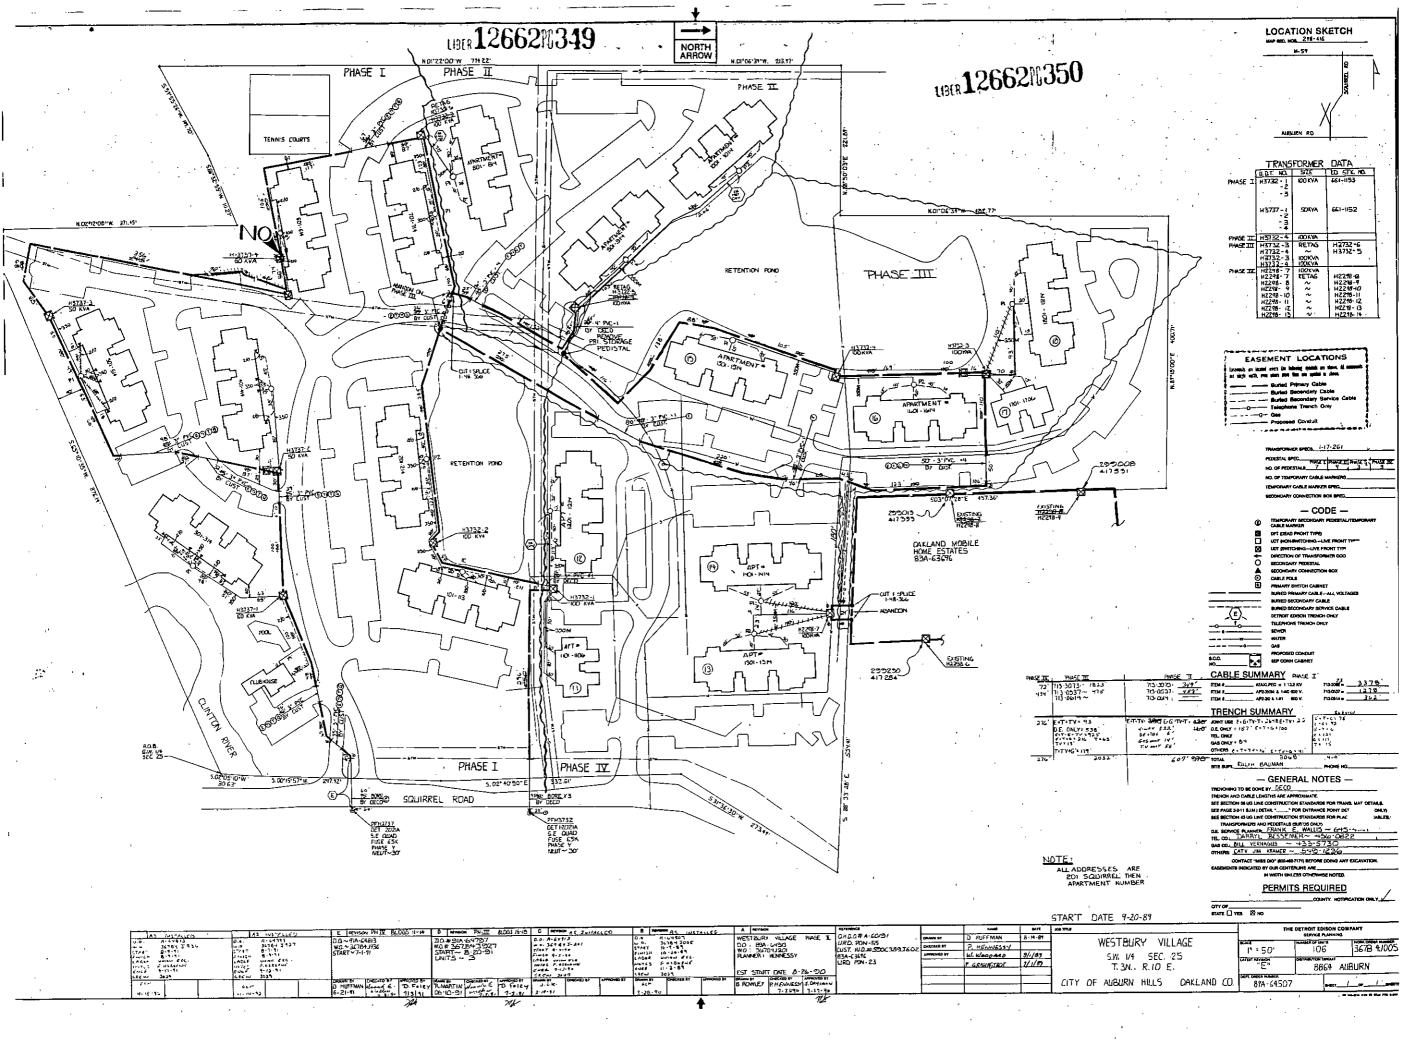

RECORDED RIGHE OF MAY NO...