

LIBER 14030PC 131

	UNDERGROUND EASEMENT (RIGHT OF WAY) NO. R 9206365-10		
	On <u>fabroary</u> , 1993, for the consideration of system betterment, Ceasement ("Right of Way") in, on and across a part of Grantor's Land called the "Grantor" is: Paul L. Simon, a single man, 21800 Pontiac Trail, South Lyon, Michigan 4817 "Grantee" is: The Detroit Edison Company, a Michigan corporation, 2000 Second Avenue, D	0001 OCT.07'93 08:44AM 8 4669 MISC 9.00	
	"Grantor's Land" is in Township of Lyon, Oakland Cou T1N, R7E, Section 32, part of NW ¼, beginning at point distant, S 00°00'01" 89°34'46" E. 380 ft., th S 00°00'04" W. 233.17 ft., th N 89°30'29" W. 380.0 2.03 Acres. Sidwell No. 21-32-100-041 The "Right of Way Area" is a part of Grantor's Land a As shown on Detroit Edison Company drawing R 9206365-10, revised and date	w. 1746.84 ft., from NW section corner, S oft., th N 00°00'01" E. 232.70 ft., to beginning.	
ıı	 Purpose: The purpose of this Right of Way is to construct, reconstruct, modiline facilities consisting of wires, manholes, conduits, pipes, cables, transformer Access: Grantee has the right of access to and from the Right of Way Area. Buildings or other Permanent Structures: No buildings or other permanent 	s and accessories.	
#	4. Excavation: As required by Public Act 53 of 1974, MISS DIG must be called Right of Way Area. 5. Trees, Bushes, Branches, Roots, Structures and Fences: Grantee may trin bushes, branches and roots in the Right of Way Area (or that could grow into fences in the Right of Way Area that Grantee believes could interfere with maintenance of Grantee's facilities. No trees, plant life, structures and fences the front door and within 2 feet of the other sides of transformers and switching to Grantor for damages to or removal of trees, plant life, structures and fences 6. Restoration: If Grantee's employees, contractors, vehicles or equipment dar for the purposes stated in this Right of Way, then Grantee shall restore Grantor' 7 Successors: This Right of Way runs with the land and binds and benefits Grand assigns.	the Right of Way Area) and remove structures and the safe and reliable construction, operation and hall be planted, grown or installed within 8 feet of cabinet enclosures. Grantee shall not be responsible placed in front of transformer doors. The placed in front of transformer doors.	
PIS	T Successors: This Right of Way runs with the land and binds and benefits Grand assigns. 8 Grantel agrees to upid this agreement at Granton. Witnesses: (type or print name below signature) Granton Granton SANDRA J. PAYNE	tand Summan &	
	Acknowledged before me in OAKLAND County, Michigan, on by PAUL L. SIMON, a single man. CHRYSIA A. CARSON CHRYSIA A. CARSON Wordery Public, Wayne County, Mil Notary's Stamp Notary's Signature Notary's Signature	FEbruary 8, ,1993	

Prepared by and Return to: Annie P. Grimmett, 30400 Telegraph Road, Room 277, Bingham Farms, Michigan 48025/PEW

Notary's Signaturg/


(Notary's name, county and date commission expires)

Notary's Stamp

_		OG. APPROVED	DATE
1		Δ.	
1	C & MS Eg & Plg	19 Bonowsky	2-B83
ł		<u> </u>	
١	Lines		
	WIGI		_1

Return to:

O.V. Racino
Th. Auroit Edison Company
3744, Telegraph Road, Rm. 277
Bingham Farms, MI 48025

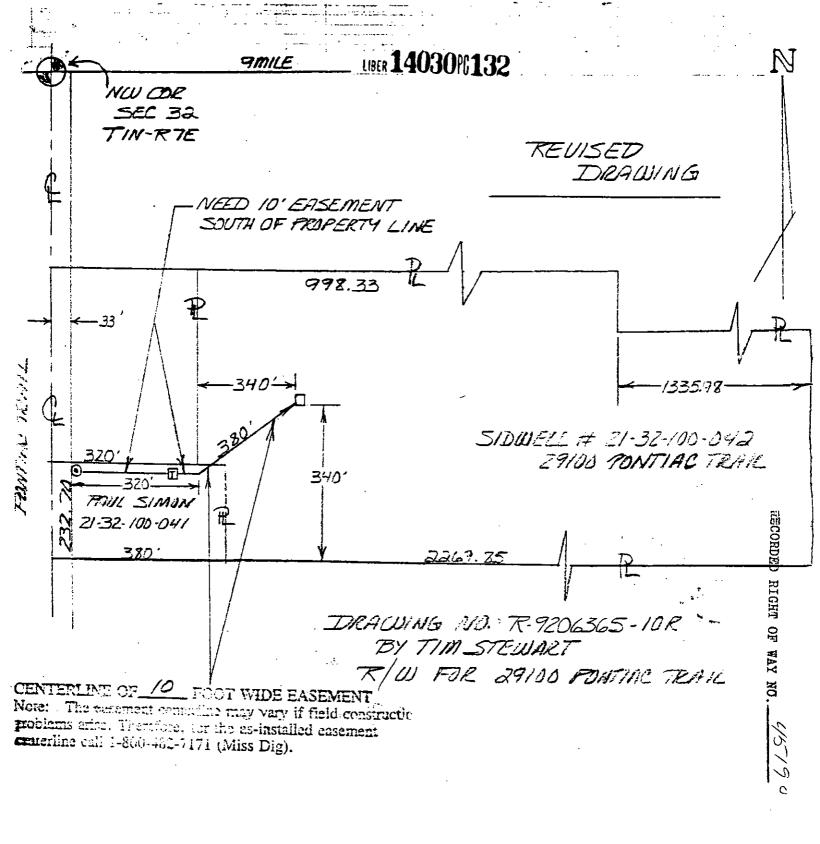

LEGEND FOREIGN POLE	THE DETROIT EDISON COMPANY-SERVICE PLANNING DEPARTMENT			
EXIST D.E. CO. POLE	CITY OR TOWNSHIP COUNTY OTR & TWP. SECT. NO. LYON DRILLAND NIII LYON 32	DEPT. ORDER NO.		
PROPOSED POLE	MAP SECT. TOWN RANGE JOINT R/W REQUIRED	R/W NO.		
EXIST ANCHOR	 2-184-540	_ 7.9206355-18R		
PROPOSED ANCHOR	PROJECT NAME TEL ENGR & DIST. SNOOPY GOLF RAINGE	PROJ. OR PART NO.		
TIPEE () ()	2939 CODY	O.F.W. S.O. OR P.E. NO.		
4800 VOLT LINE REASON FRONT TRAIL		BUDGET ITEM NO.		
	77M STEUSIART SCALE NORIE	DATE /-//- 93		

Return to:
O.V. Racine
The Detroit Edison Company
30400 Telegraph Road, Rm. 277
Bingham Farms, MI 48025