Derroir
Edison
OVERHEAD EASEMENT (RIGHT OF WAY) NO. 22223
1996
On 1-9-95, for the consideration of system betterment, Grantor grants to Grantee a
permanent overhead easement ("Right of Way") in, on and across a part of Grantor's Land called the
"Right of Way Area".
"Grantor" is:
Scott A. Walkup and Regina D. Walkup, husband and wife, 57 N. Elm, Lapeer, MI 48446
"Grantee" is:
The Detroit Edison Company, a Michigan corporation, 2000 Second Avenue, Detroit, Michigan 48226
"Grantor's Land" is in Goodland Township, Lapeer County, Michigan
described as:
PARCEL "D":
Part of the North 1/2 of the Northeast 1/4 of Section 8, T8N-R12E, described as: Beginning at a point on
the North line of Section 8, T8N-R12E, that is South 89°05'21" East 1294.32 feet from the North 1/4
corner of said Section 8; thence continuing along said North Section line South 89°05'21" East 330.00
feet; thence South 01°29'02" West 660.00 feet; thence North 89°05'21" West 330.00 feet; thence North
01°29'02" East 660.00 feet to the point of beginning.
The "Right of Way Area" is a part of Grantor's Land and is described
as:
1. Purpose The purpose of this Right of Way is to construct, reconstruct, modify, add to, operate and
maintain overhead utility line facilities consisting of poles, guys, anchors, wires, cables, transformers
and accessories.
2. Access Grantee has the right of access to and from the Right of Way Area.
3. Buildings or other Permanent Structures No buildings or other permanent structures shall be placed
in the Right of Way Area without Grantee's prior written consent.
4. Trees, Bushes, Branches or Roots Grantee may trim, cut down, remove or otherwise control any
trees, bushes, branches or roots in the Right of Way Area (or that could grow into the Right of Way
Area) that Grantee believes could interfere with the safe and reliable construction, operation and
maintenance of Grantee's facilities.

5. Restoration If Grantee's employees, contractors, vehicles or equipment damage Grantor's Land while entering Grantor's Land for the purposes stated in this Right of Way, then Grantee shall restore Grantor's Land as nearly as can be to its original condition.

6. Successors This Right of Way runs with the land and binds and benefits Grantor's and Grantee's successors, lessees, licensees and assigns.

Witnesses: (type or print name below signature) RECEIVED FOR RECORD
Michael Lough FEB 12 PM 1:41 de Olt H. Walthigh
MICHAEL J. LOUWSMA 936PAGENOLII- SCOTT A. WALKURD
Lenise Suther Byton of DEPOS (Por 11) allala
DENISE SUTHER BYLAPEER COUNTY HIGHIGAN DEGINA D WALKUP (HIS WIFE
Acknowledged before me in <u>LAFEER</u> County, Michigan, on <u>JANUARY 9</u> , 1995 by Scott A., Walkup and Regina D. Walkup, husband and wife.
Notary's Stamp GARY W. NEWNET Notary Public, Lapear County, MI My Commission Expires June 23, 1999

Prepared by and Return to: Gary W. Kenney, 1075 Suncrest Drive, Lapeer, MI 48446/jmm

RECORDER STOWN OF WAY NO.

WICHHEL W. LOUWSHA

France LERNEY


LA PEPP


EFEINS D WALKUP (HIS VILFE)

·.

. .

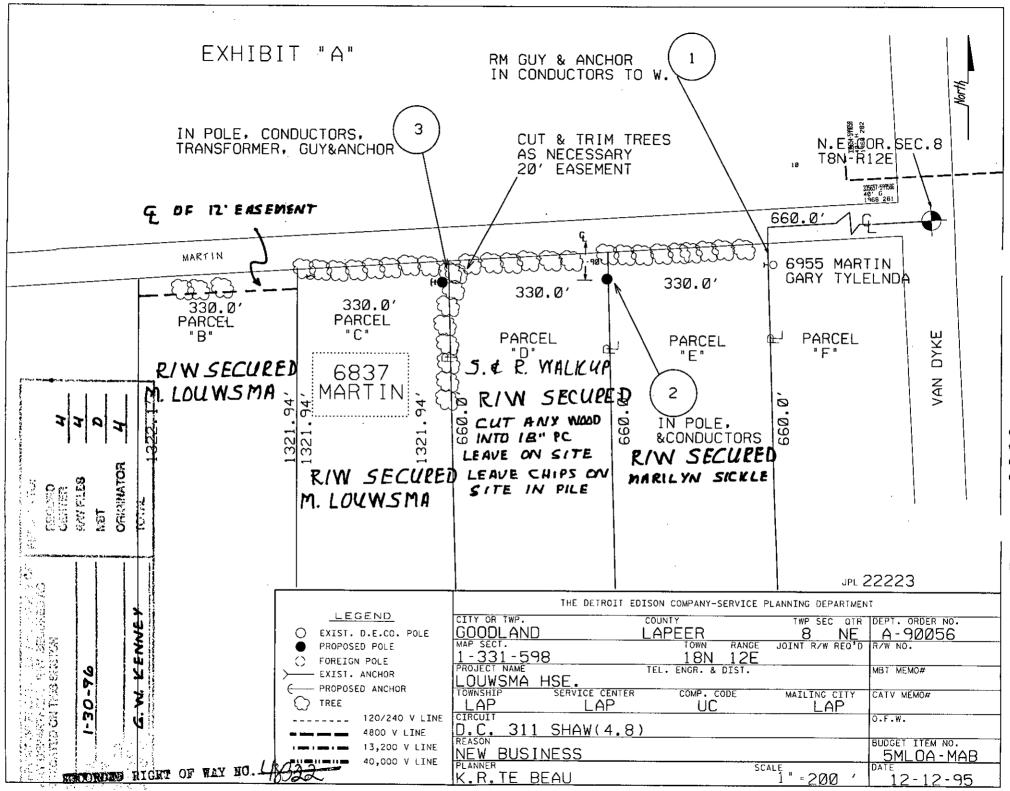

9.00 P0009 2.00

MISC D ESMT REMONT